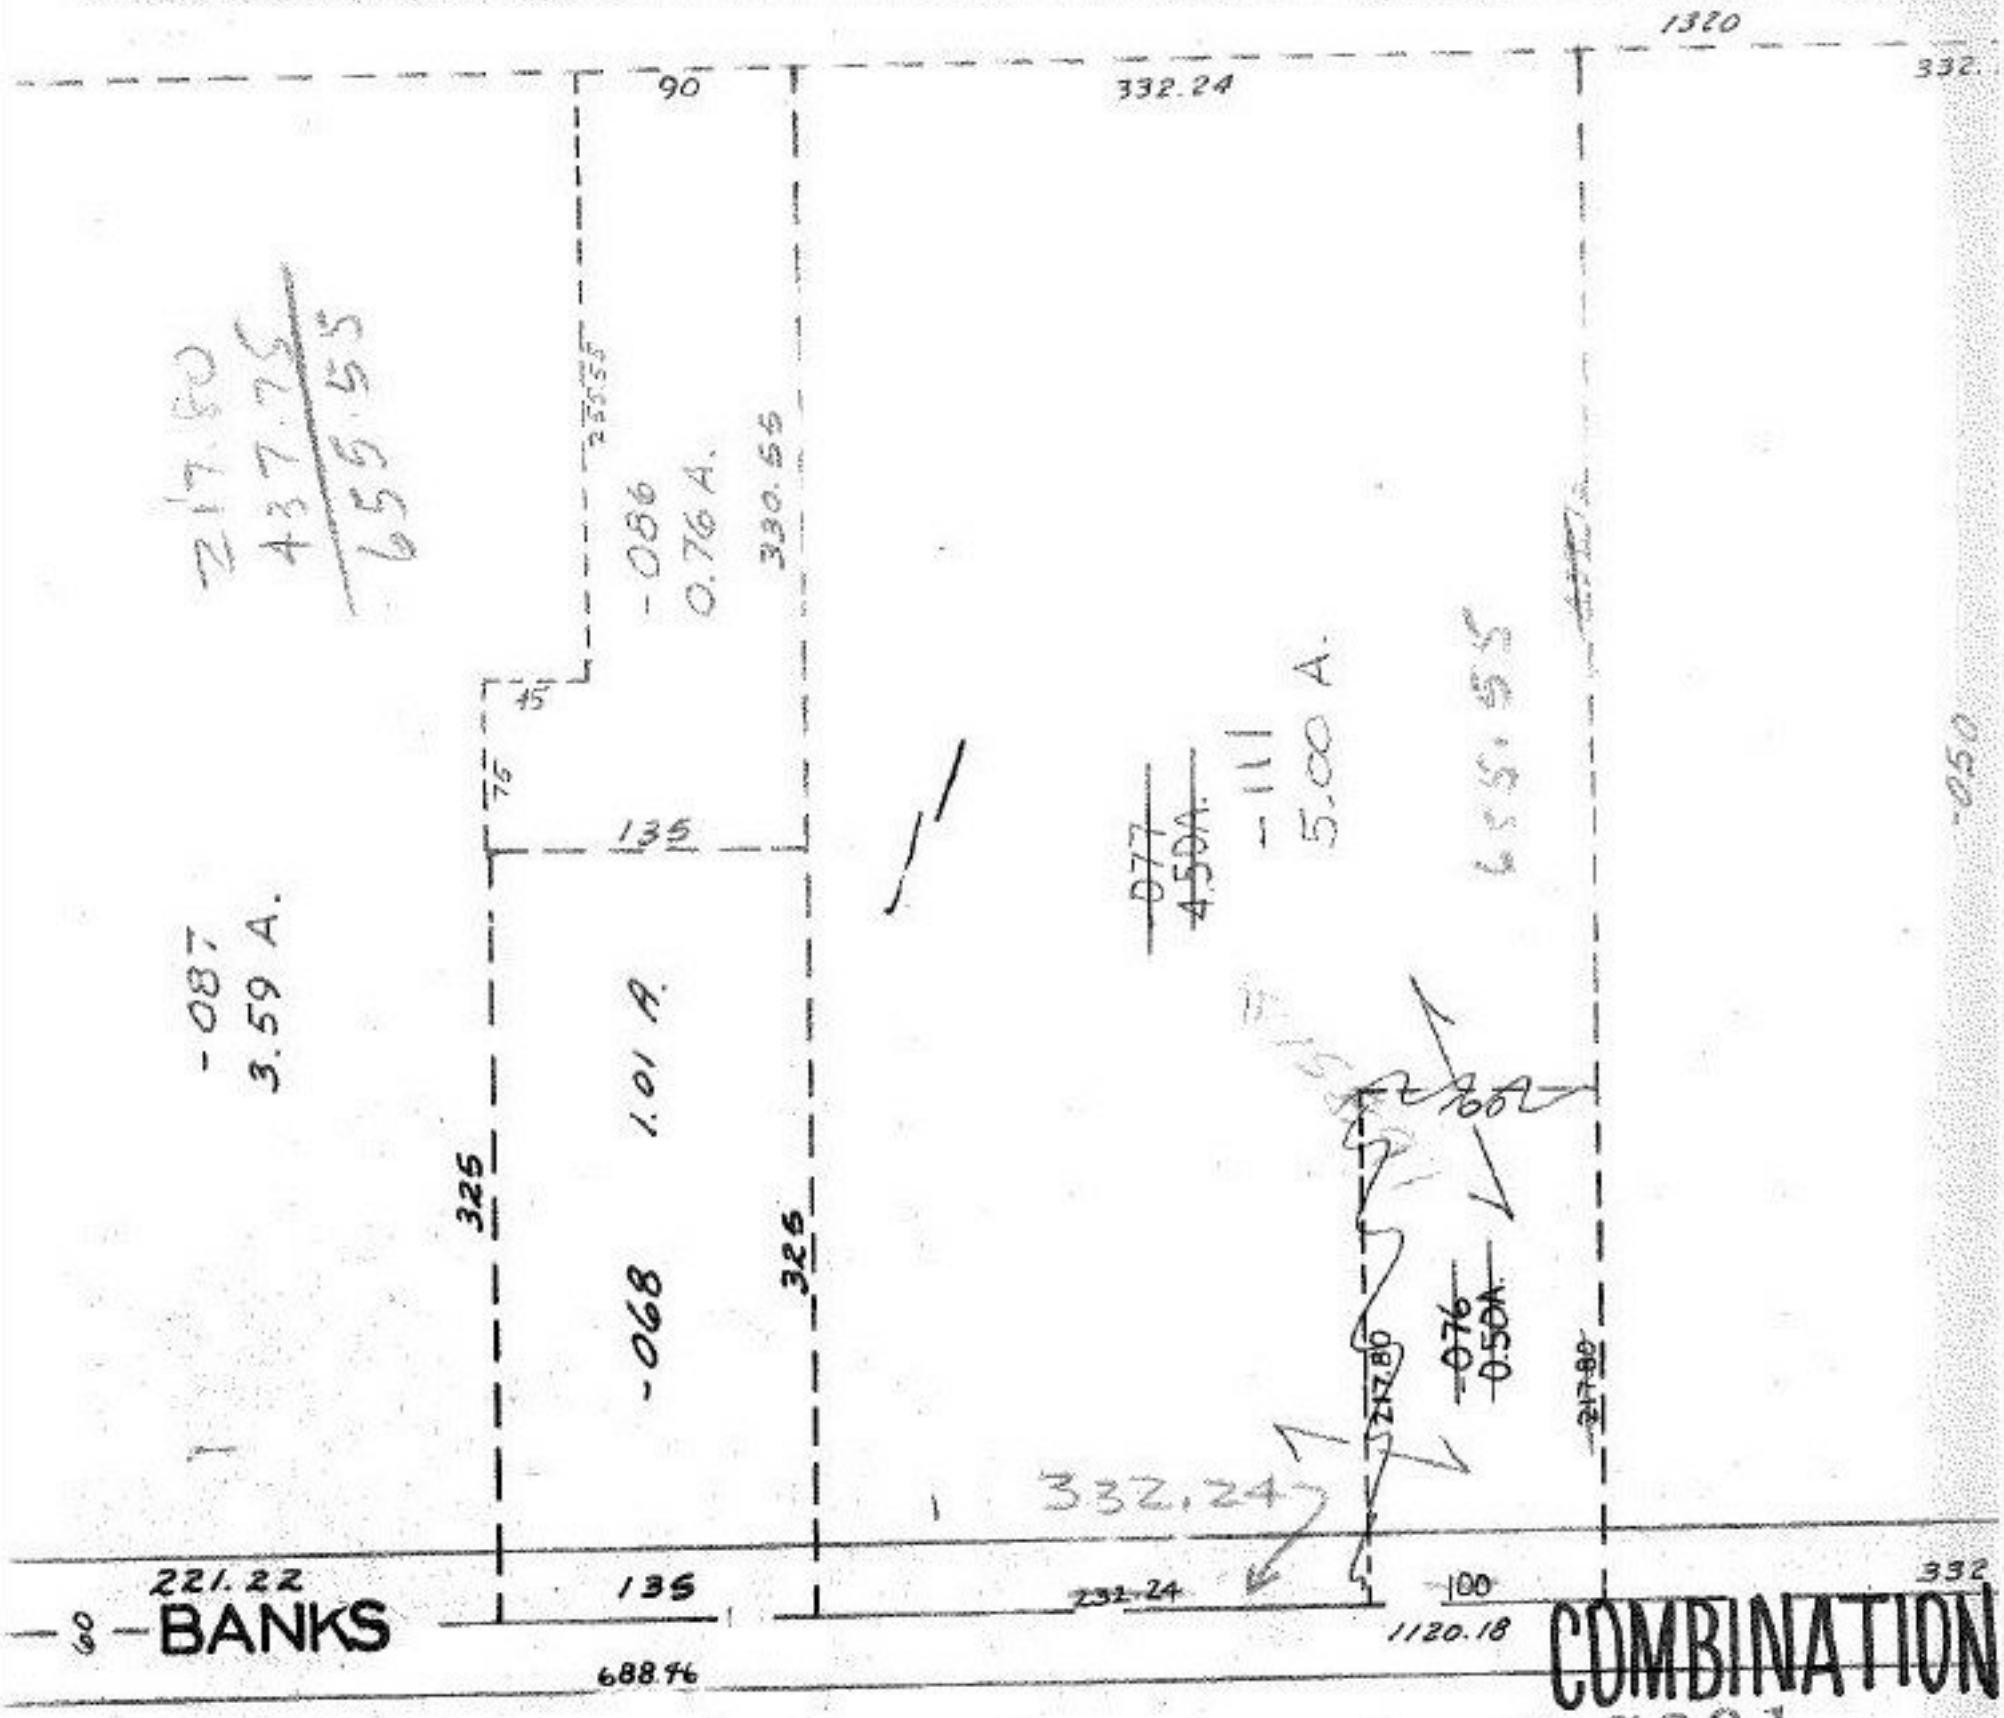

#15891

APPROVED
LORAIN CO.
MAP DEPT.

DATE 11-6-84

PAGE 10-00-024.A

BY T. McNair

VOID

1/25/85