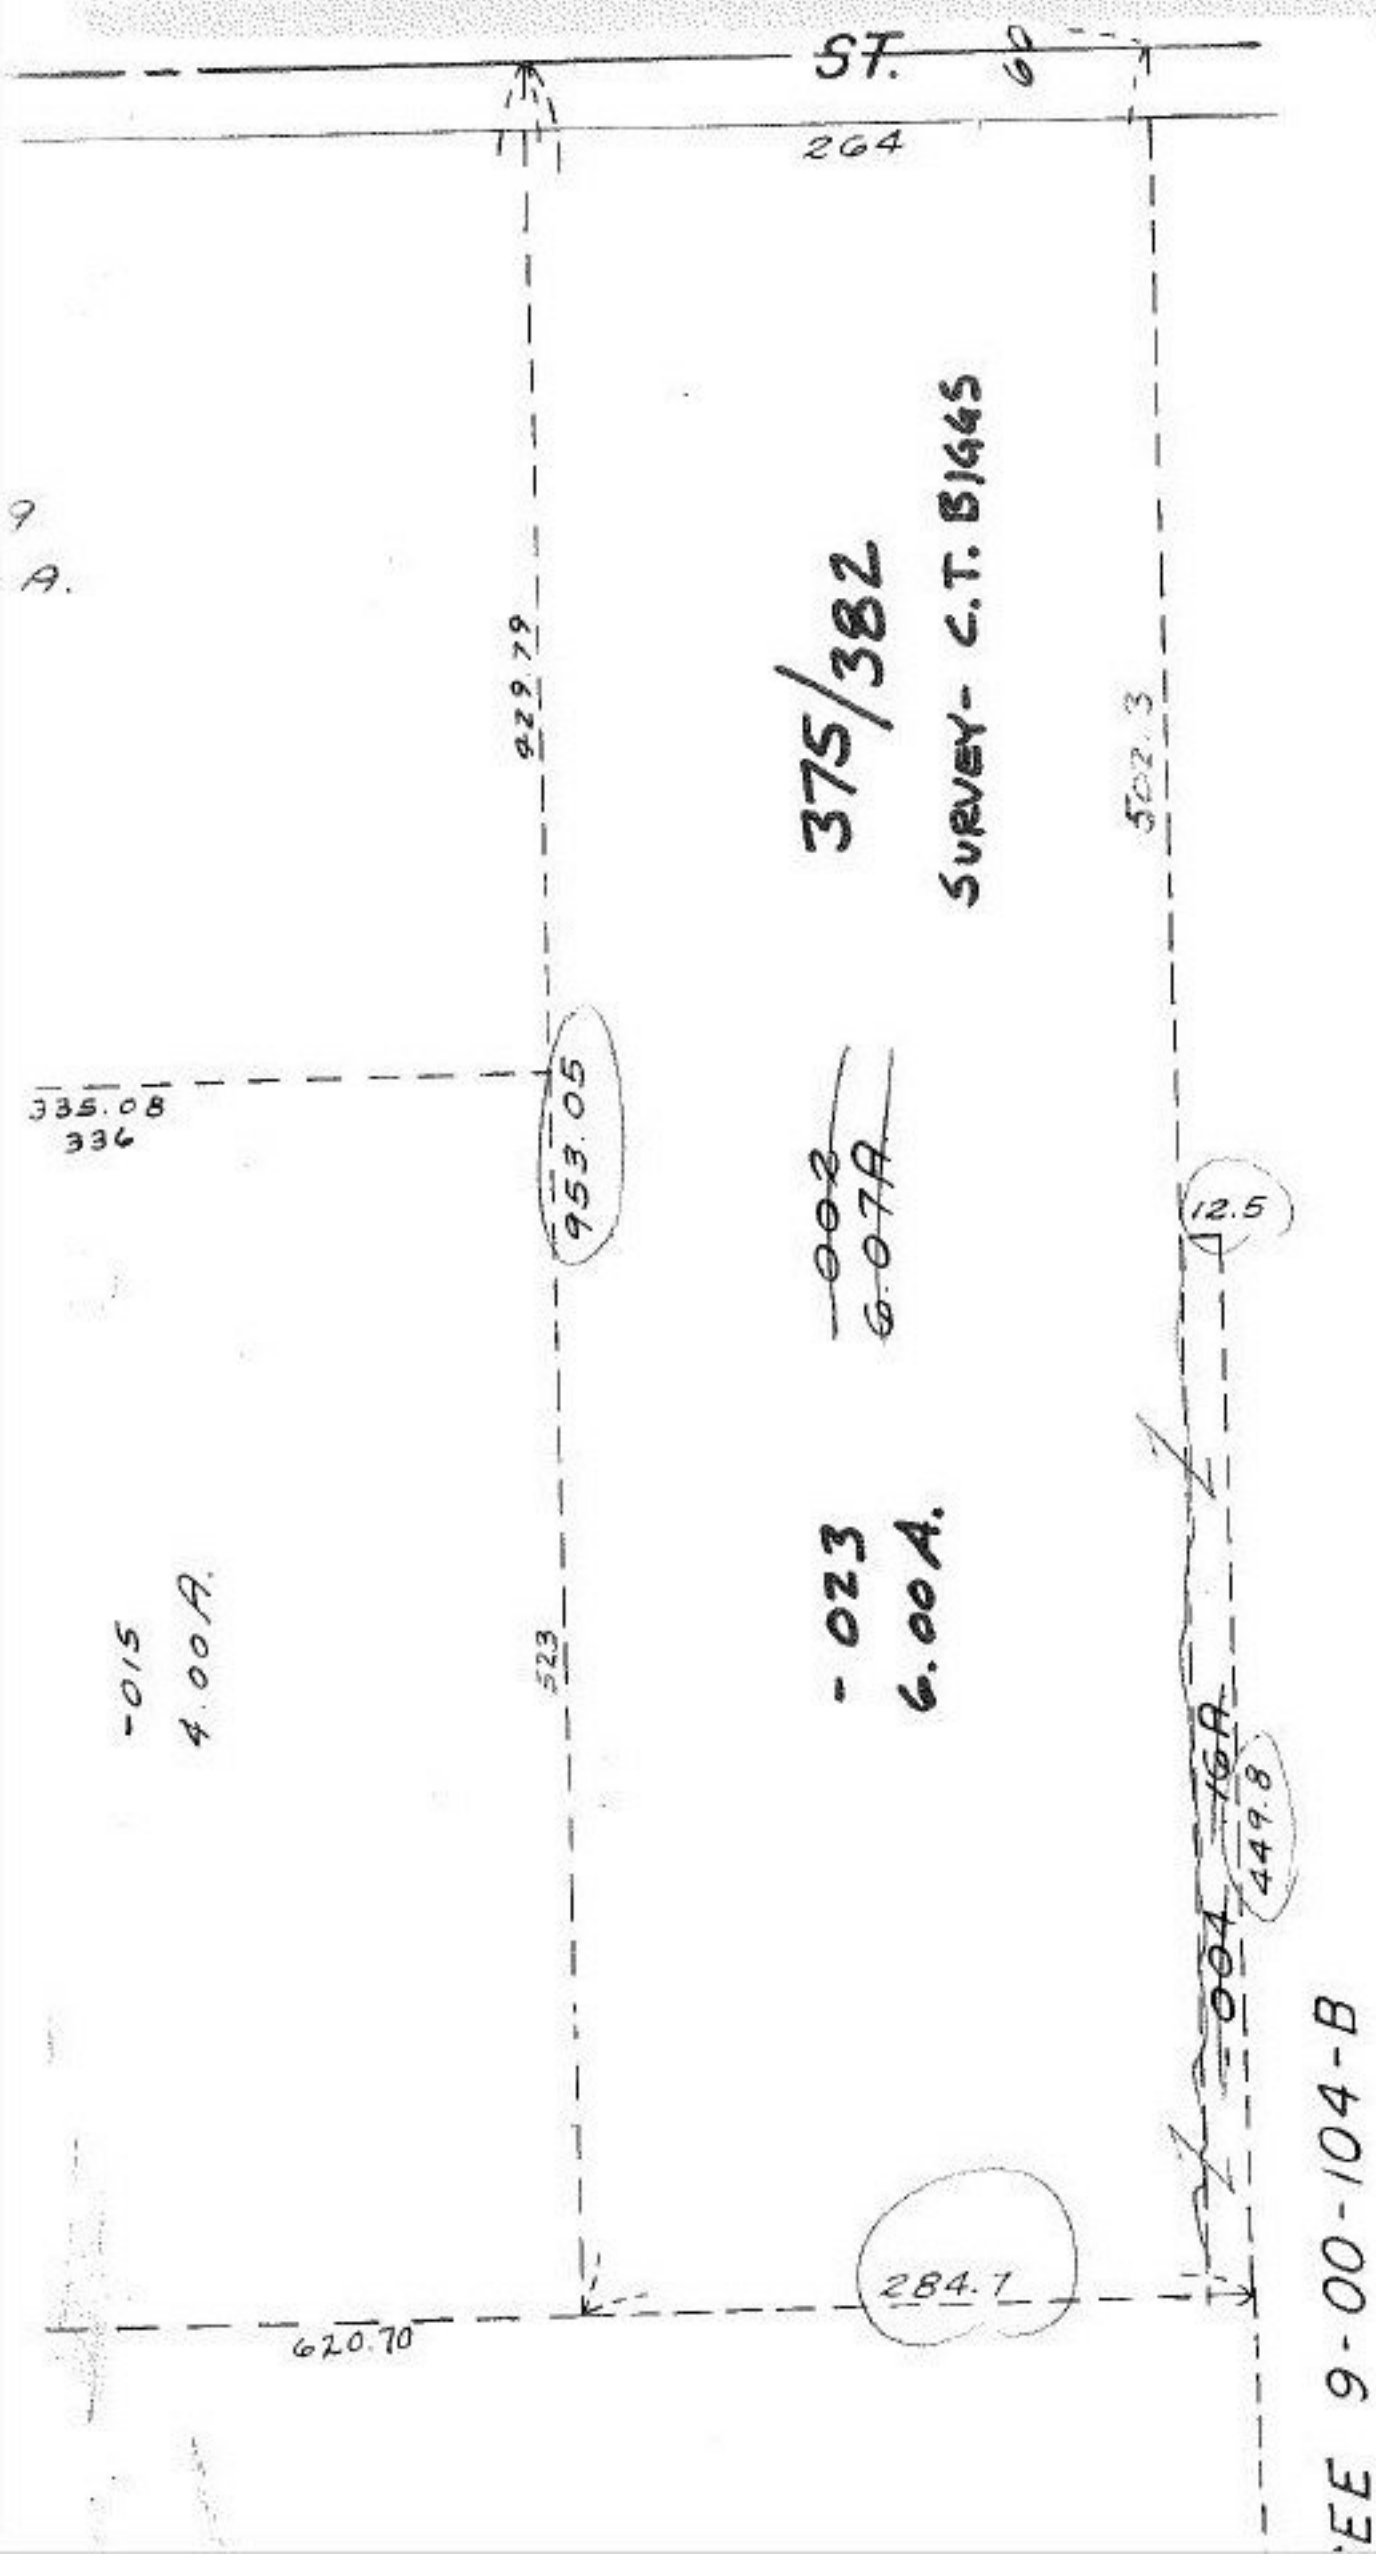

AC. CDRR.

COMB.

#15893

APPROVED
LORAIN CO.
MAP DEPT.

DATE 11. 8. 84

PAGE 9.00.104.A

BY T. McNair

VOID

4-7-86