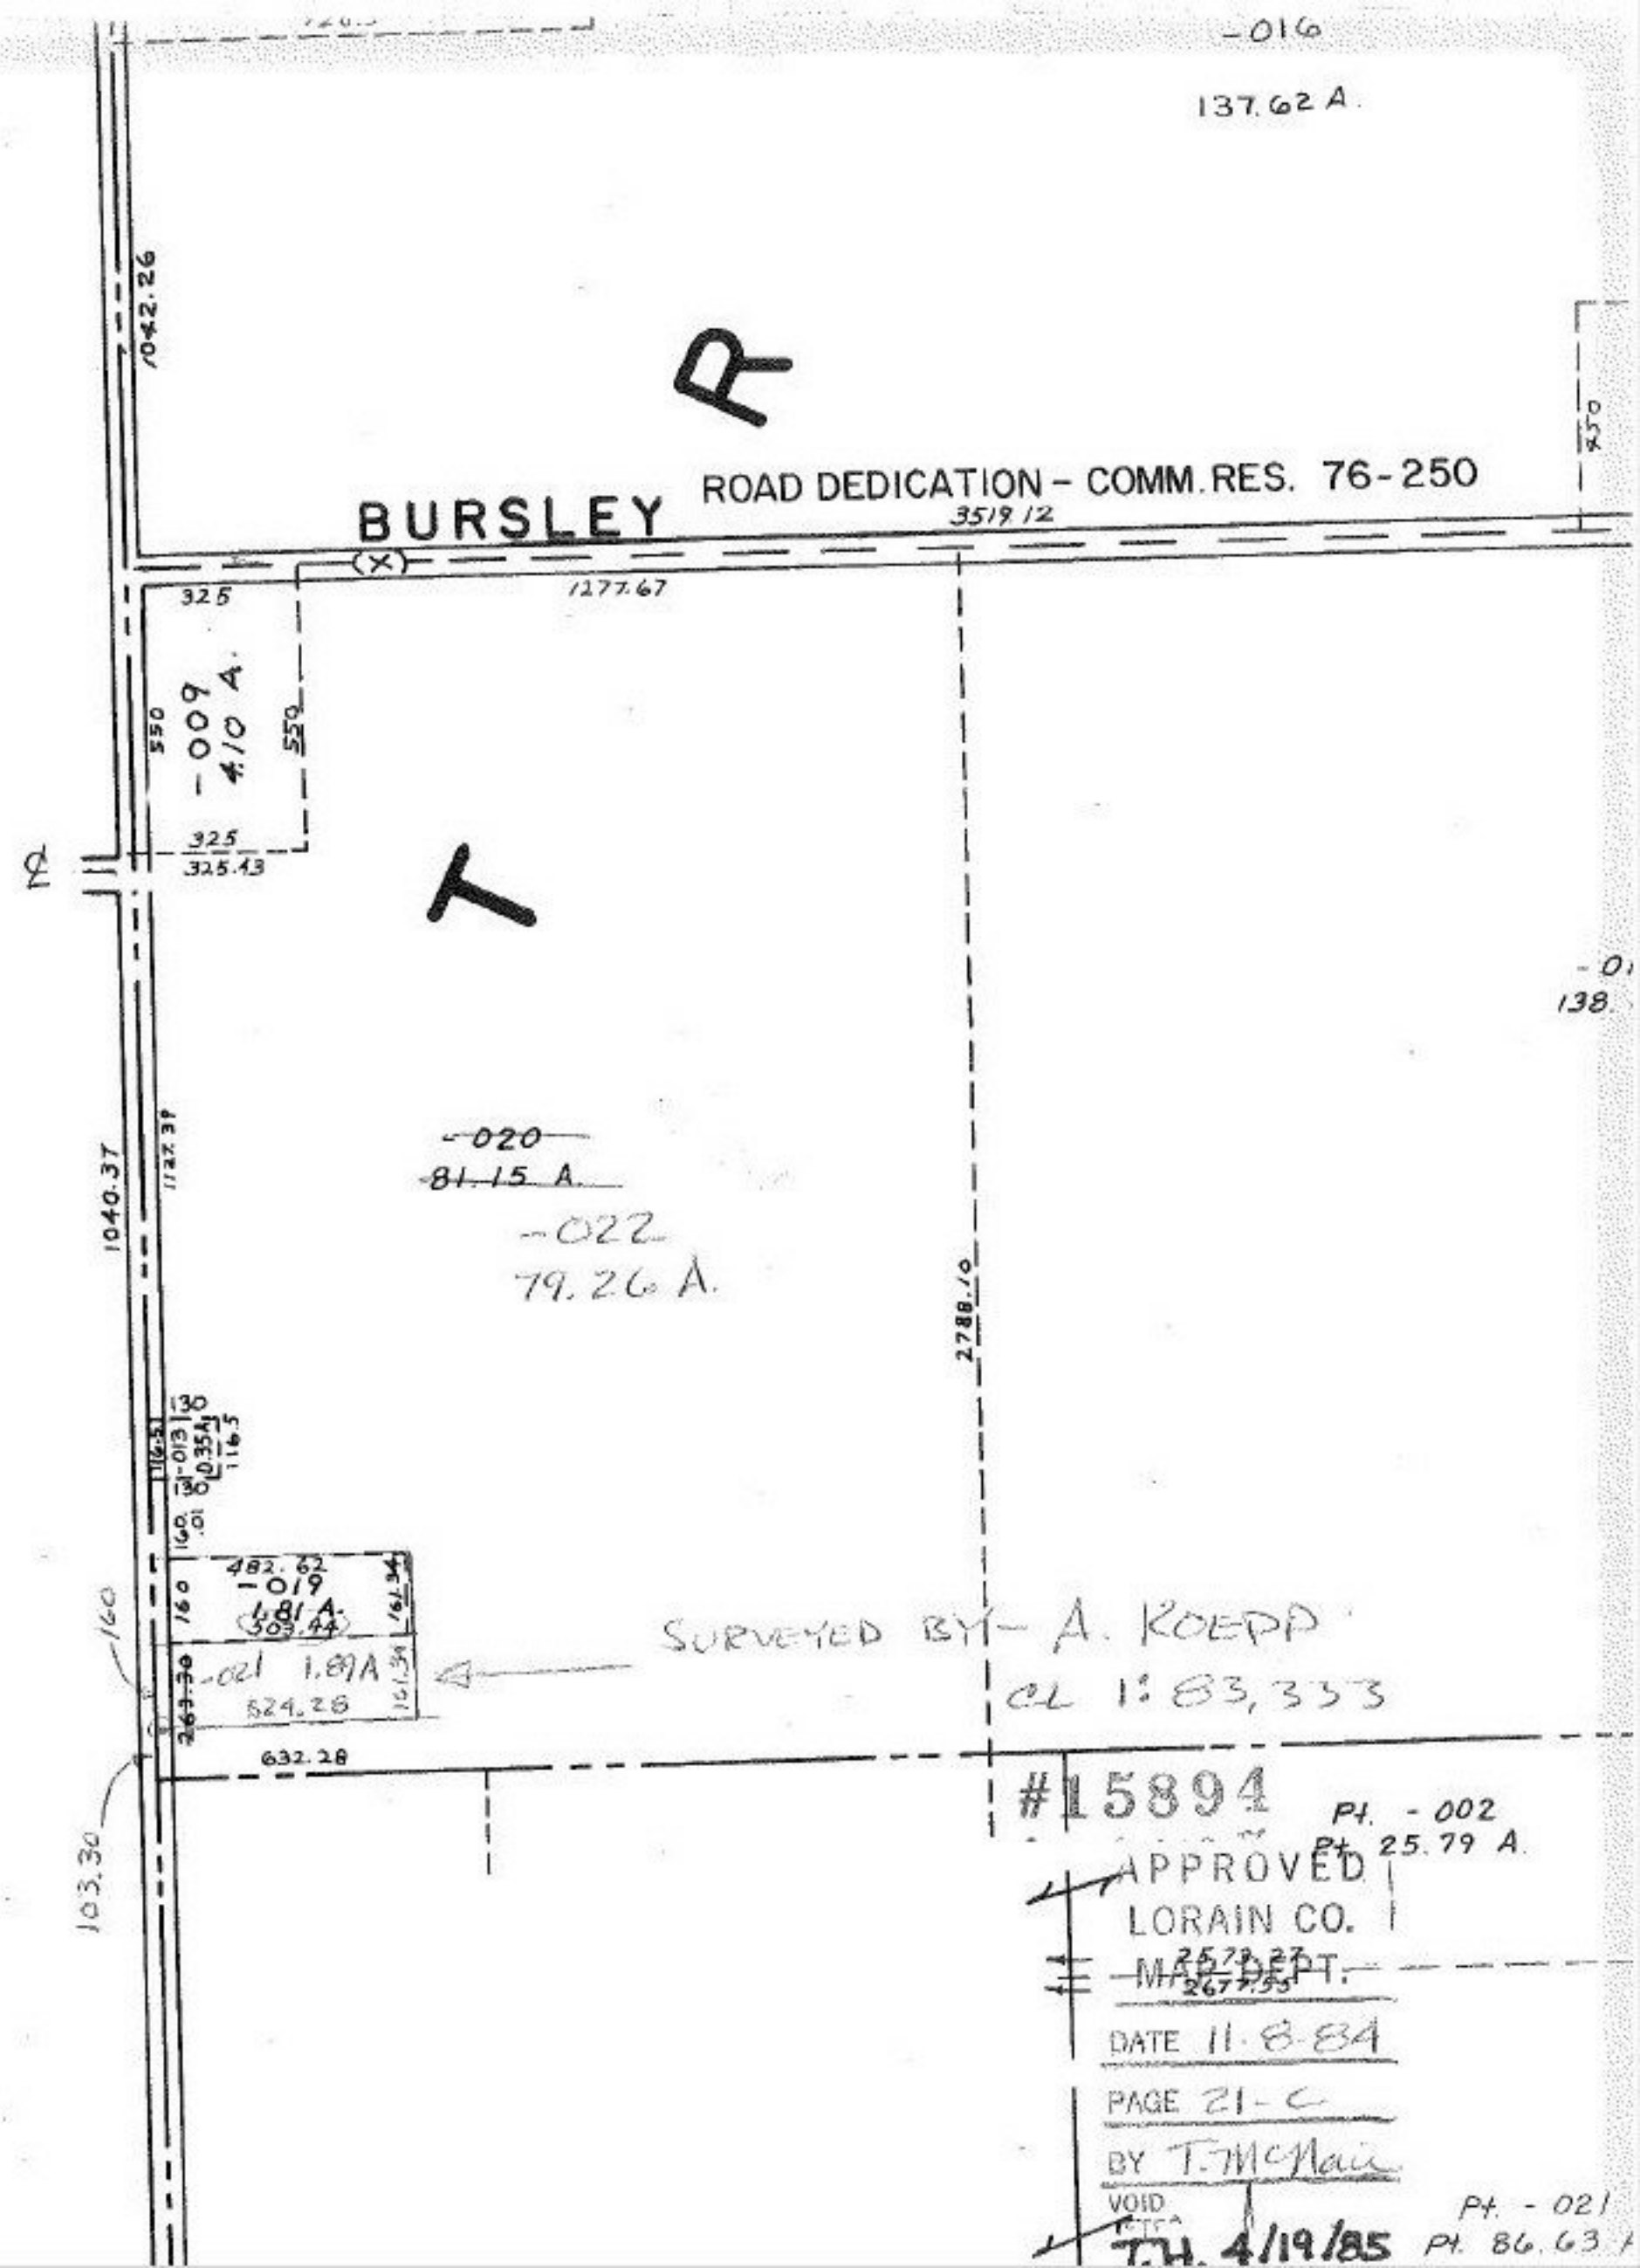
-016
137.62 A.
1042.26
R
BURSLEY
ROAD DEDICATION - COMM. RES. 76-250
3519.12
1277.67
325
550
-009
4.10 A.
550
325
325.43
T
-020
81.15 A.
-022
79.26 A.
1040.37
1127.39
2788.10
130
116.5
-013
0.35A
116.5
130
160
.01
482.62
-019
1.81 A.
503.44
160
161.34
-021 1.89A
524.28
161.34
263.30
632.28
103.30
SURVEYED BY - A. KOEPP
CL 1: 83,333
#15894
Pt. -002
Pt. 25.79 A.
APPROVED
LORAIN CO.
MAP DEPT.
DATE 11-8-84
PAGE 21-C
BY T. McNair
VOID
T.H. 4/19/85
Pt. -021
Pt. 86.63