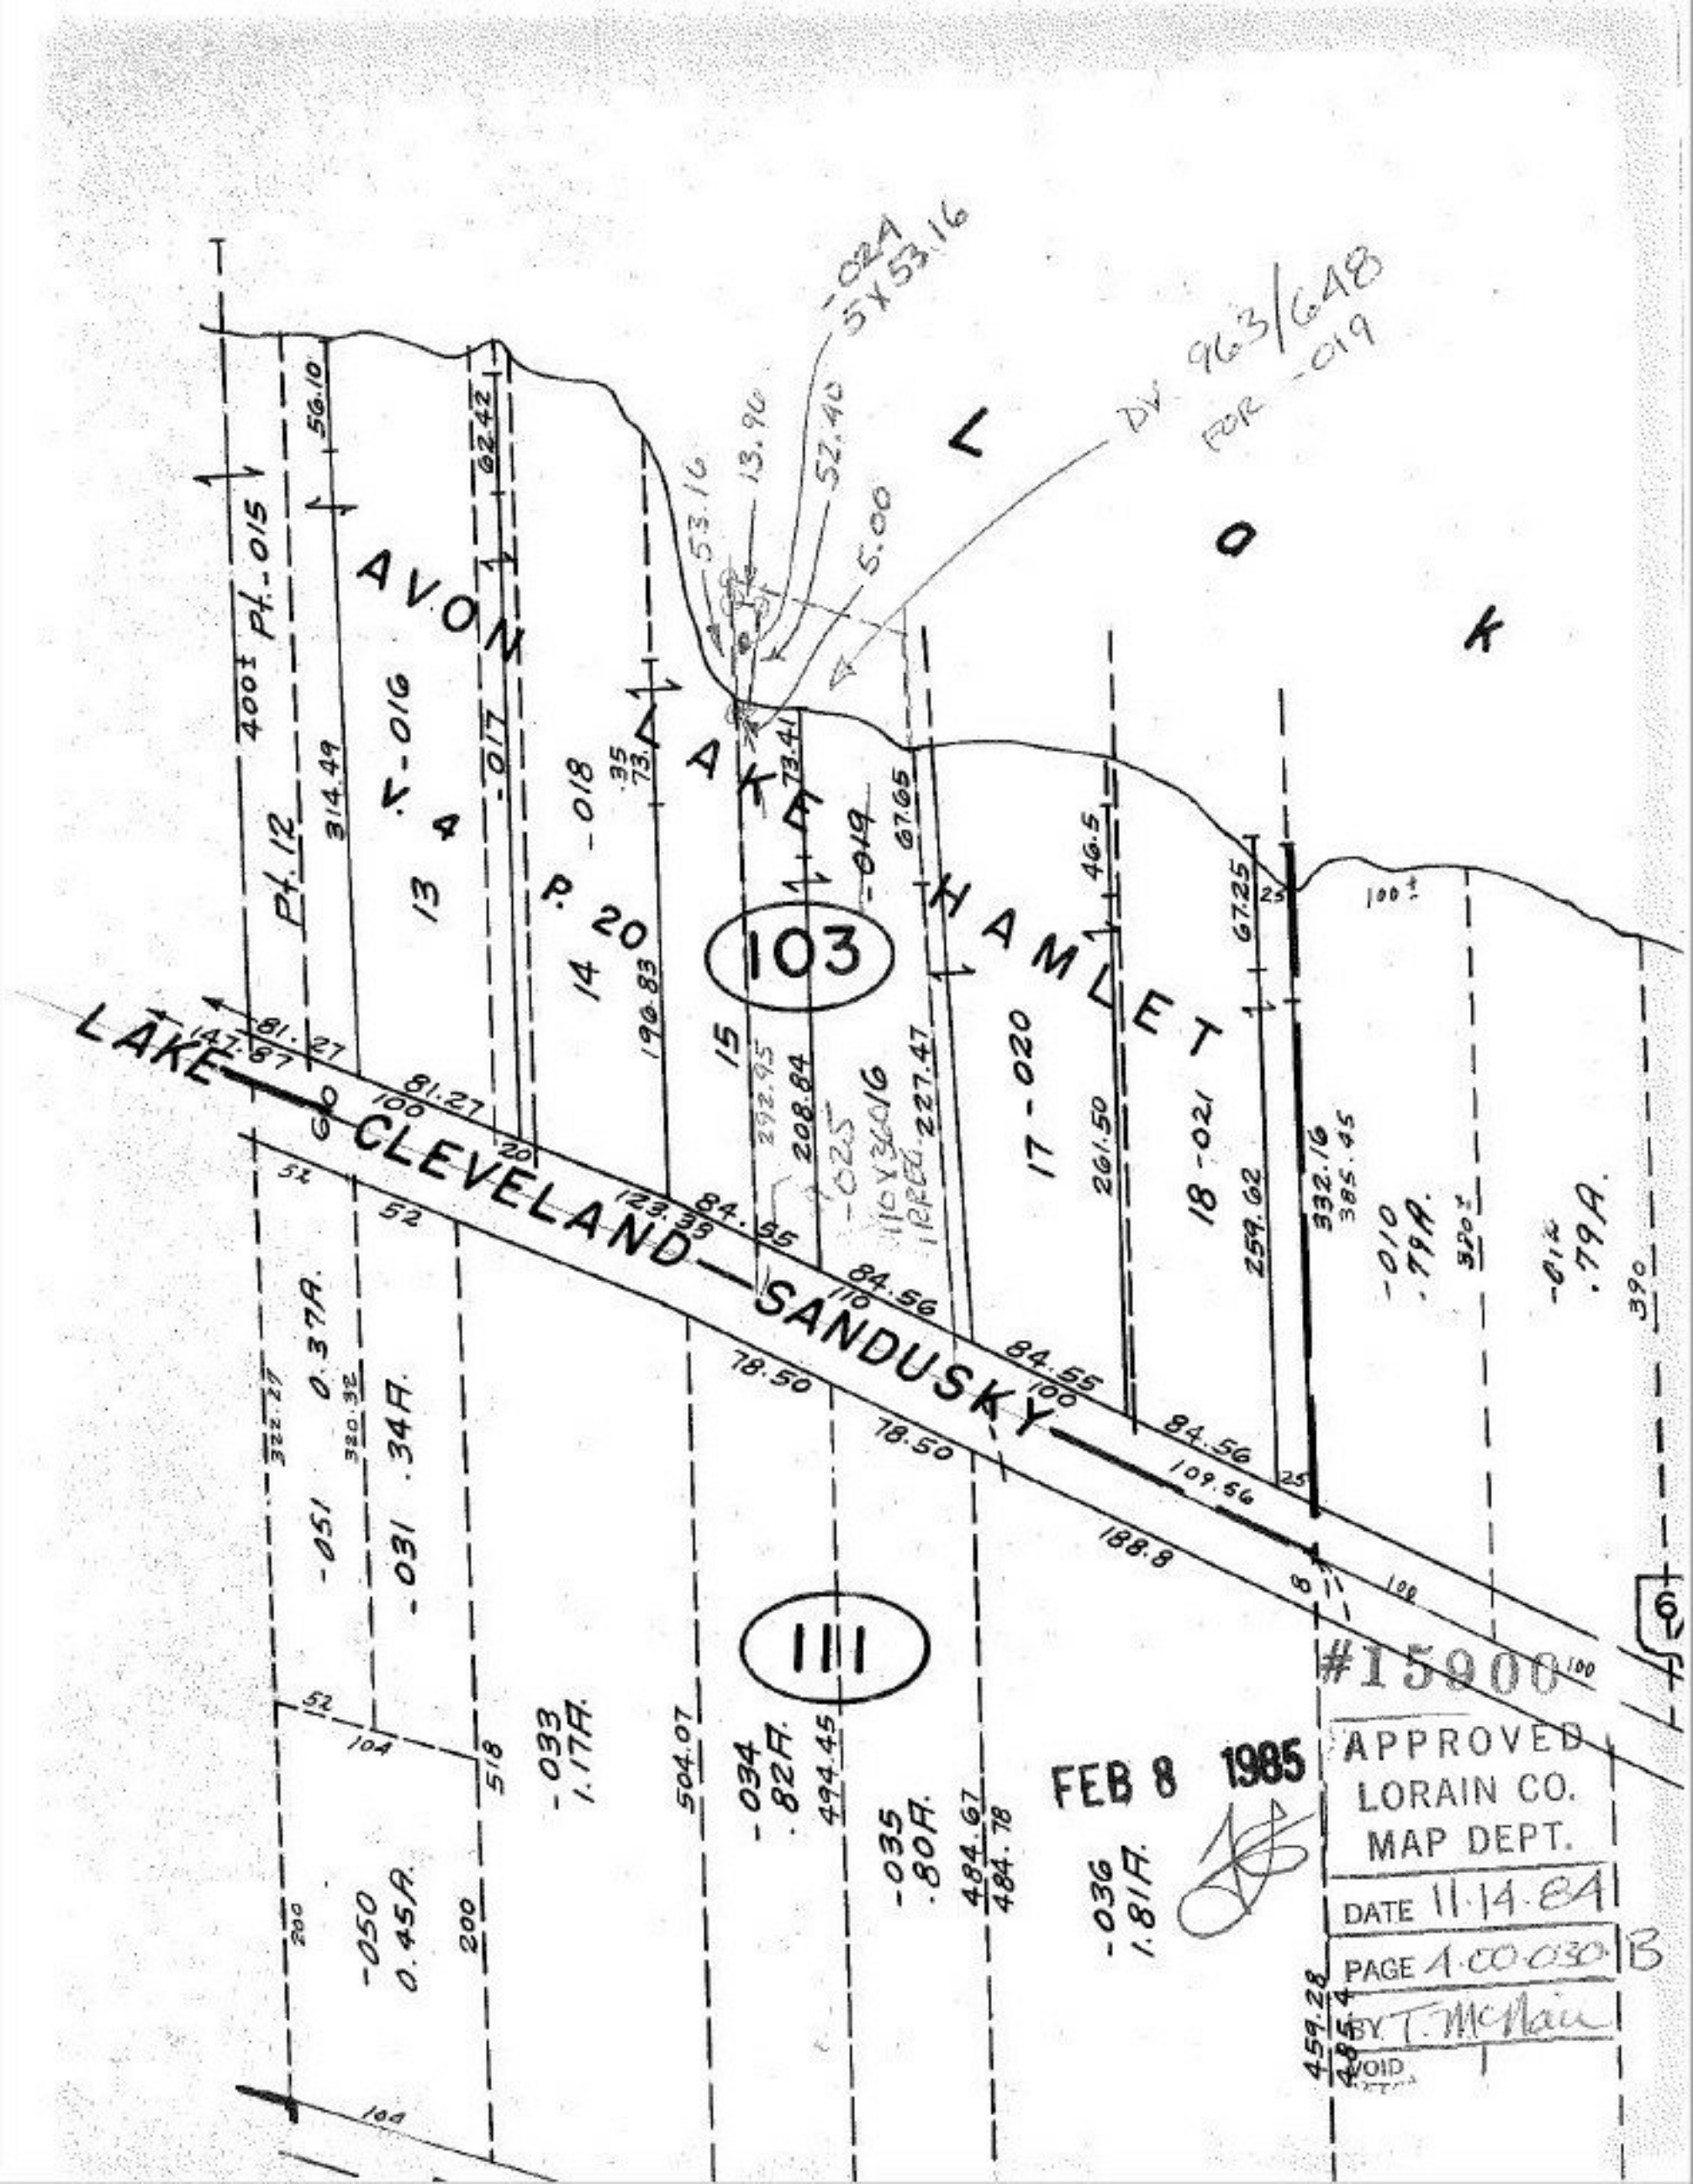

LAKE CLEVELAND—SANDUSKY
AVON LAKE
HAMLET
LOK
103
111
-024
5X53.16
DV 963/648
FOR -019
53.16
13.90
52.40
5.00
400± Pt.-015
Pt. 12
V. 4
13
-016
-017
-018
P. 20
14
15
-019
17-020
18-021
-010
.79A.
-012
.79A.
-051
0.37A.
-031
.34A.
-050
0.45A.
-033
1.17A.
-034
.82A.
-035
.80A.
-036
1.81A.
#15900
FEB 8 1985
APPROVED
LORAIN CO.
MAP DEPT.
DATE 11.14.84
PAGE 4.00.030 B
BY T. McNair
VOID