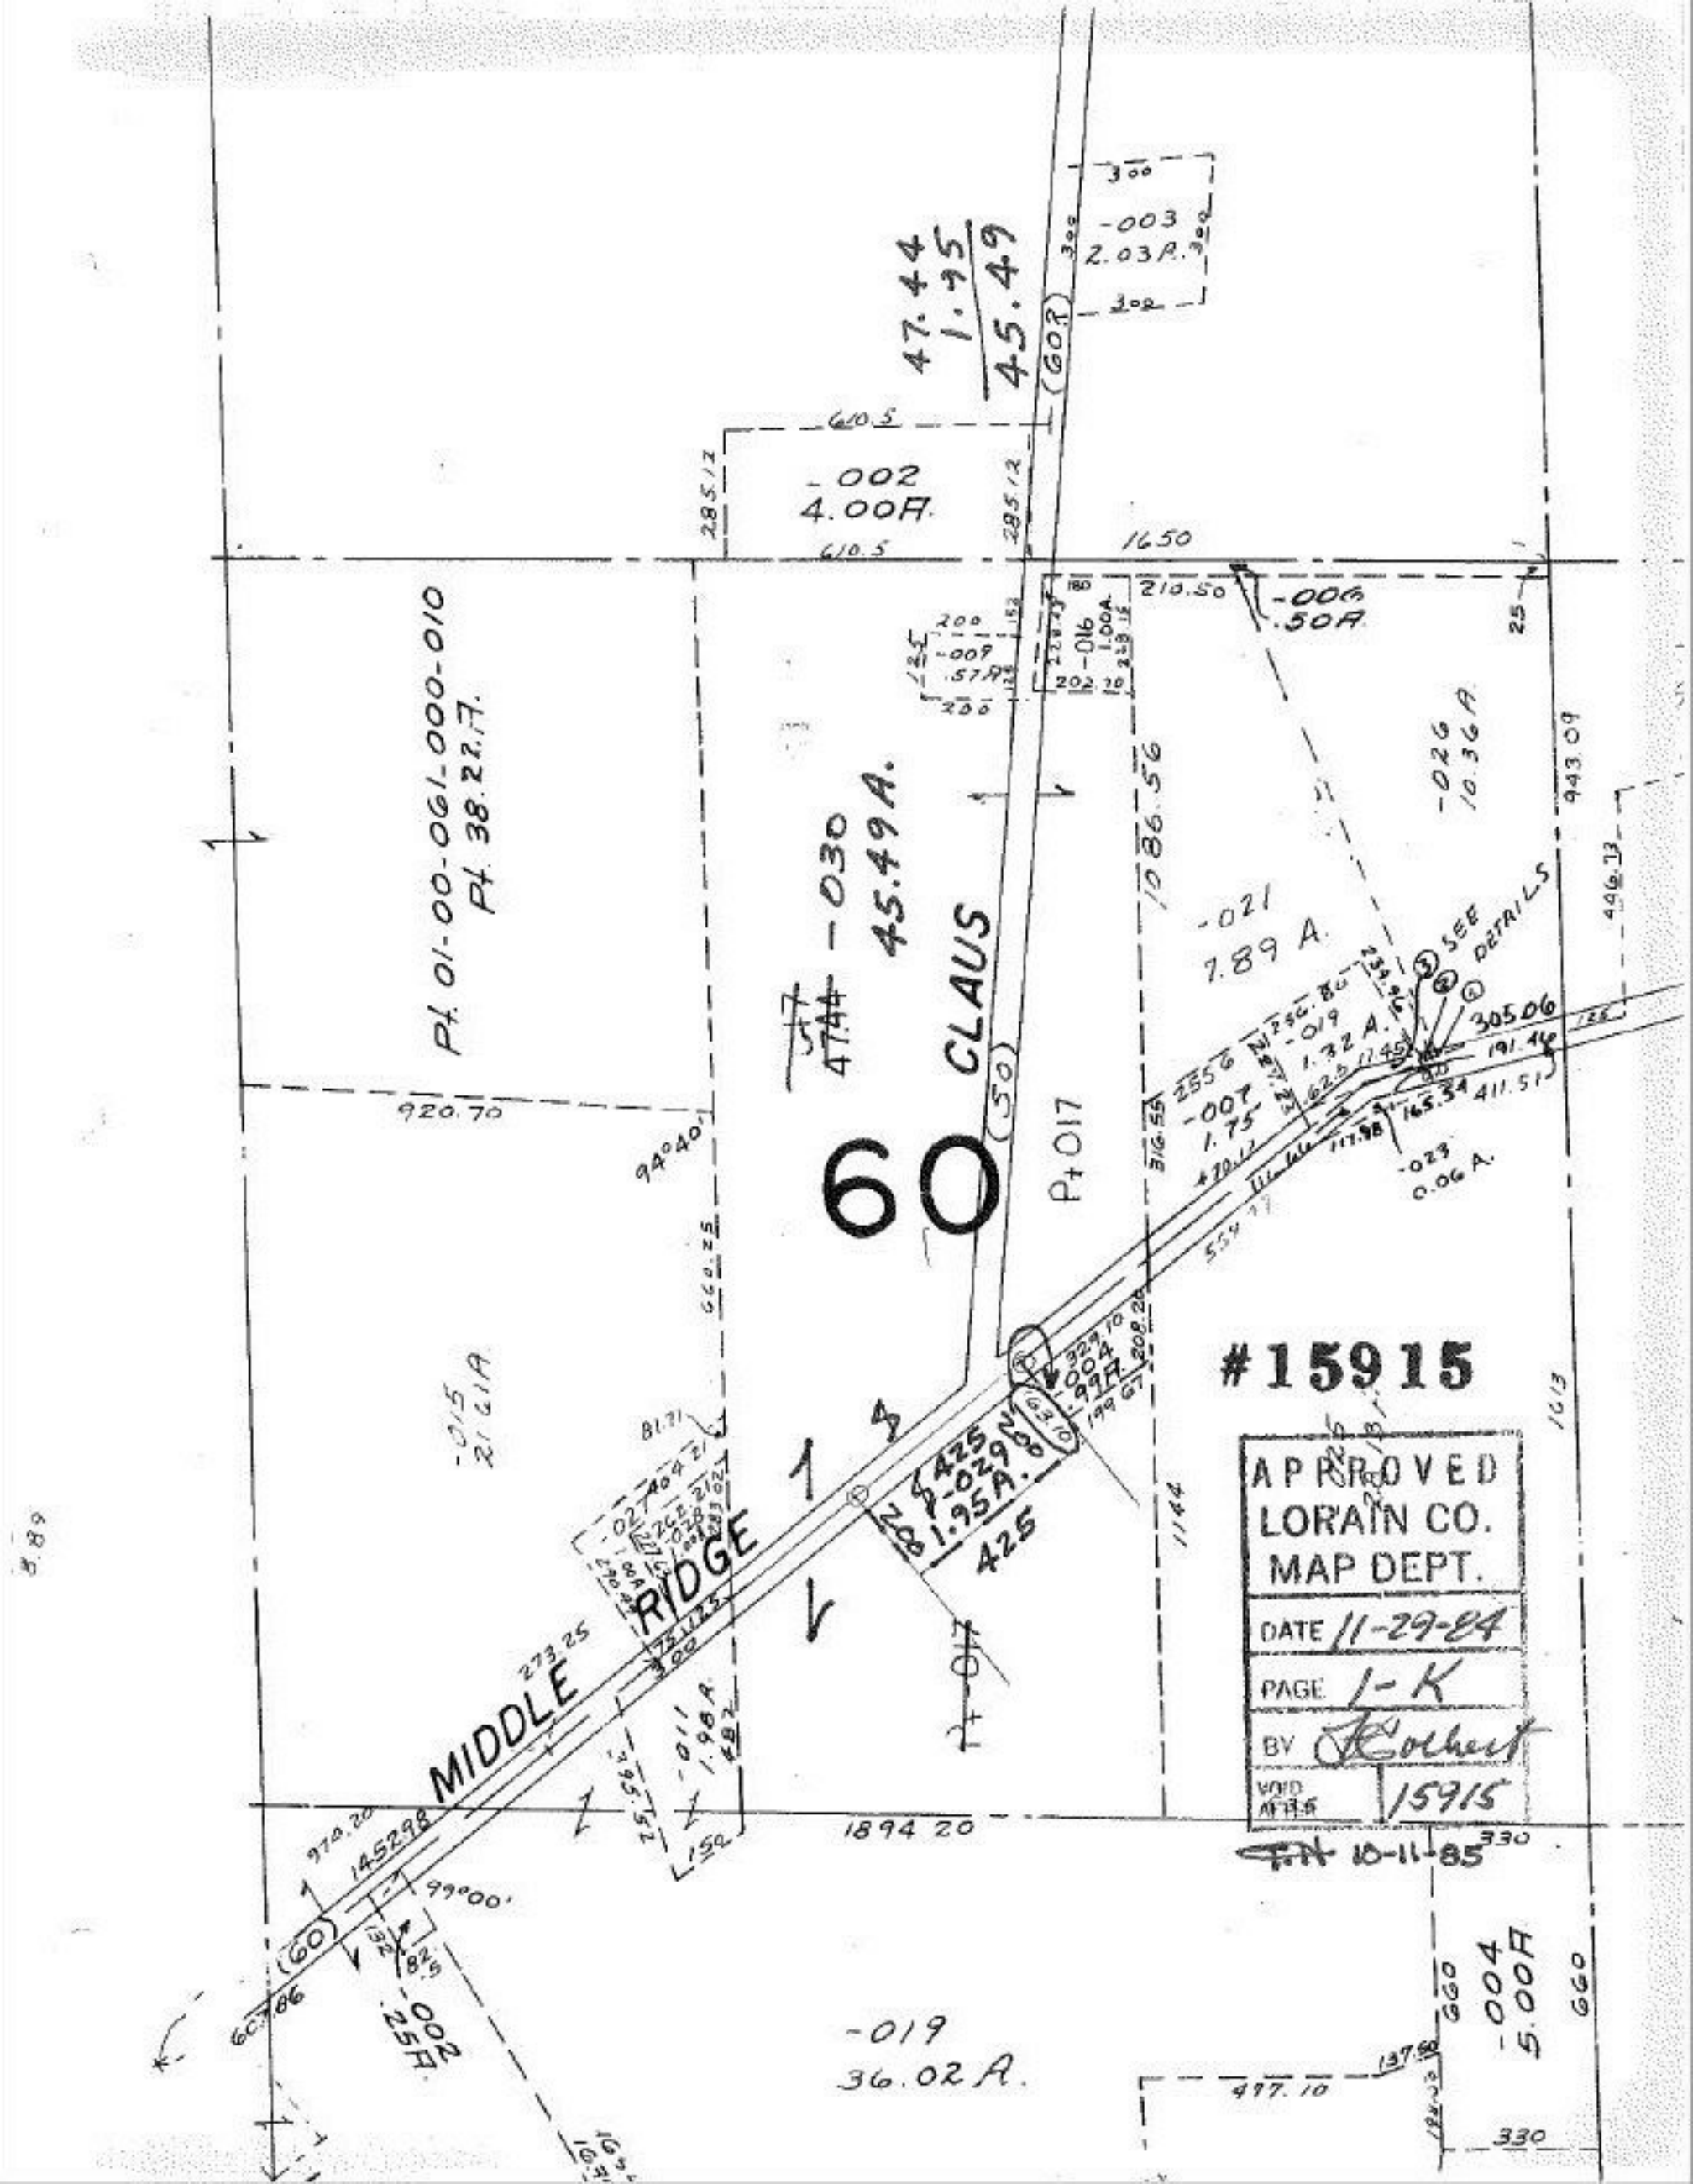

#15915

APPROVED
LORAIN CO.
MAP DEPT.
DATE 11-29-84
PAGE 1-K
BY Kolbert
VOID AFTER 15915

T.N 10-11-85