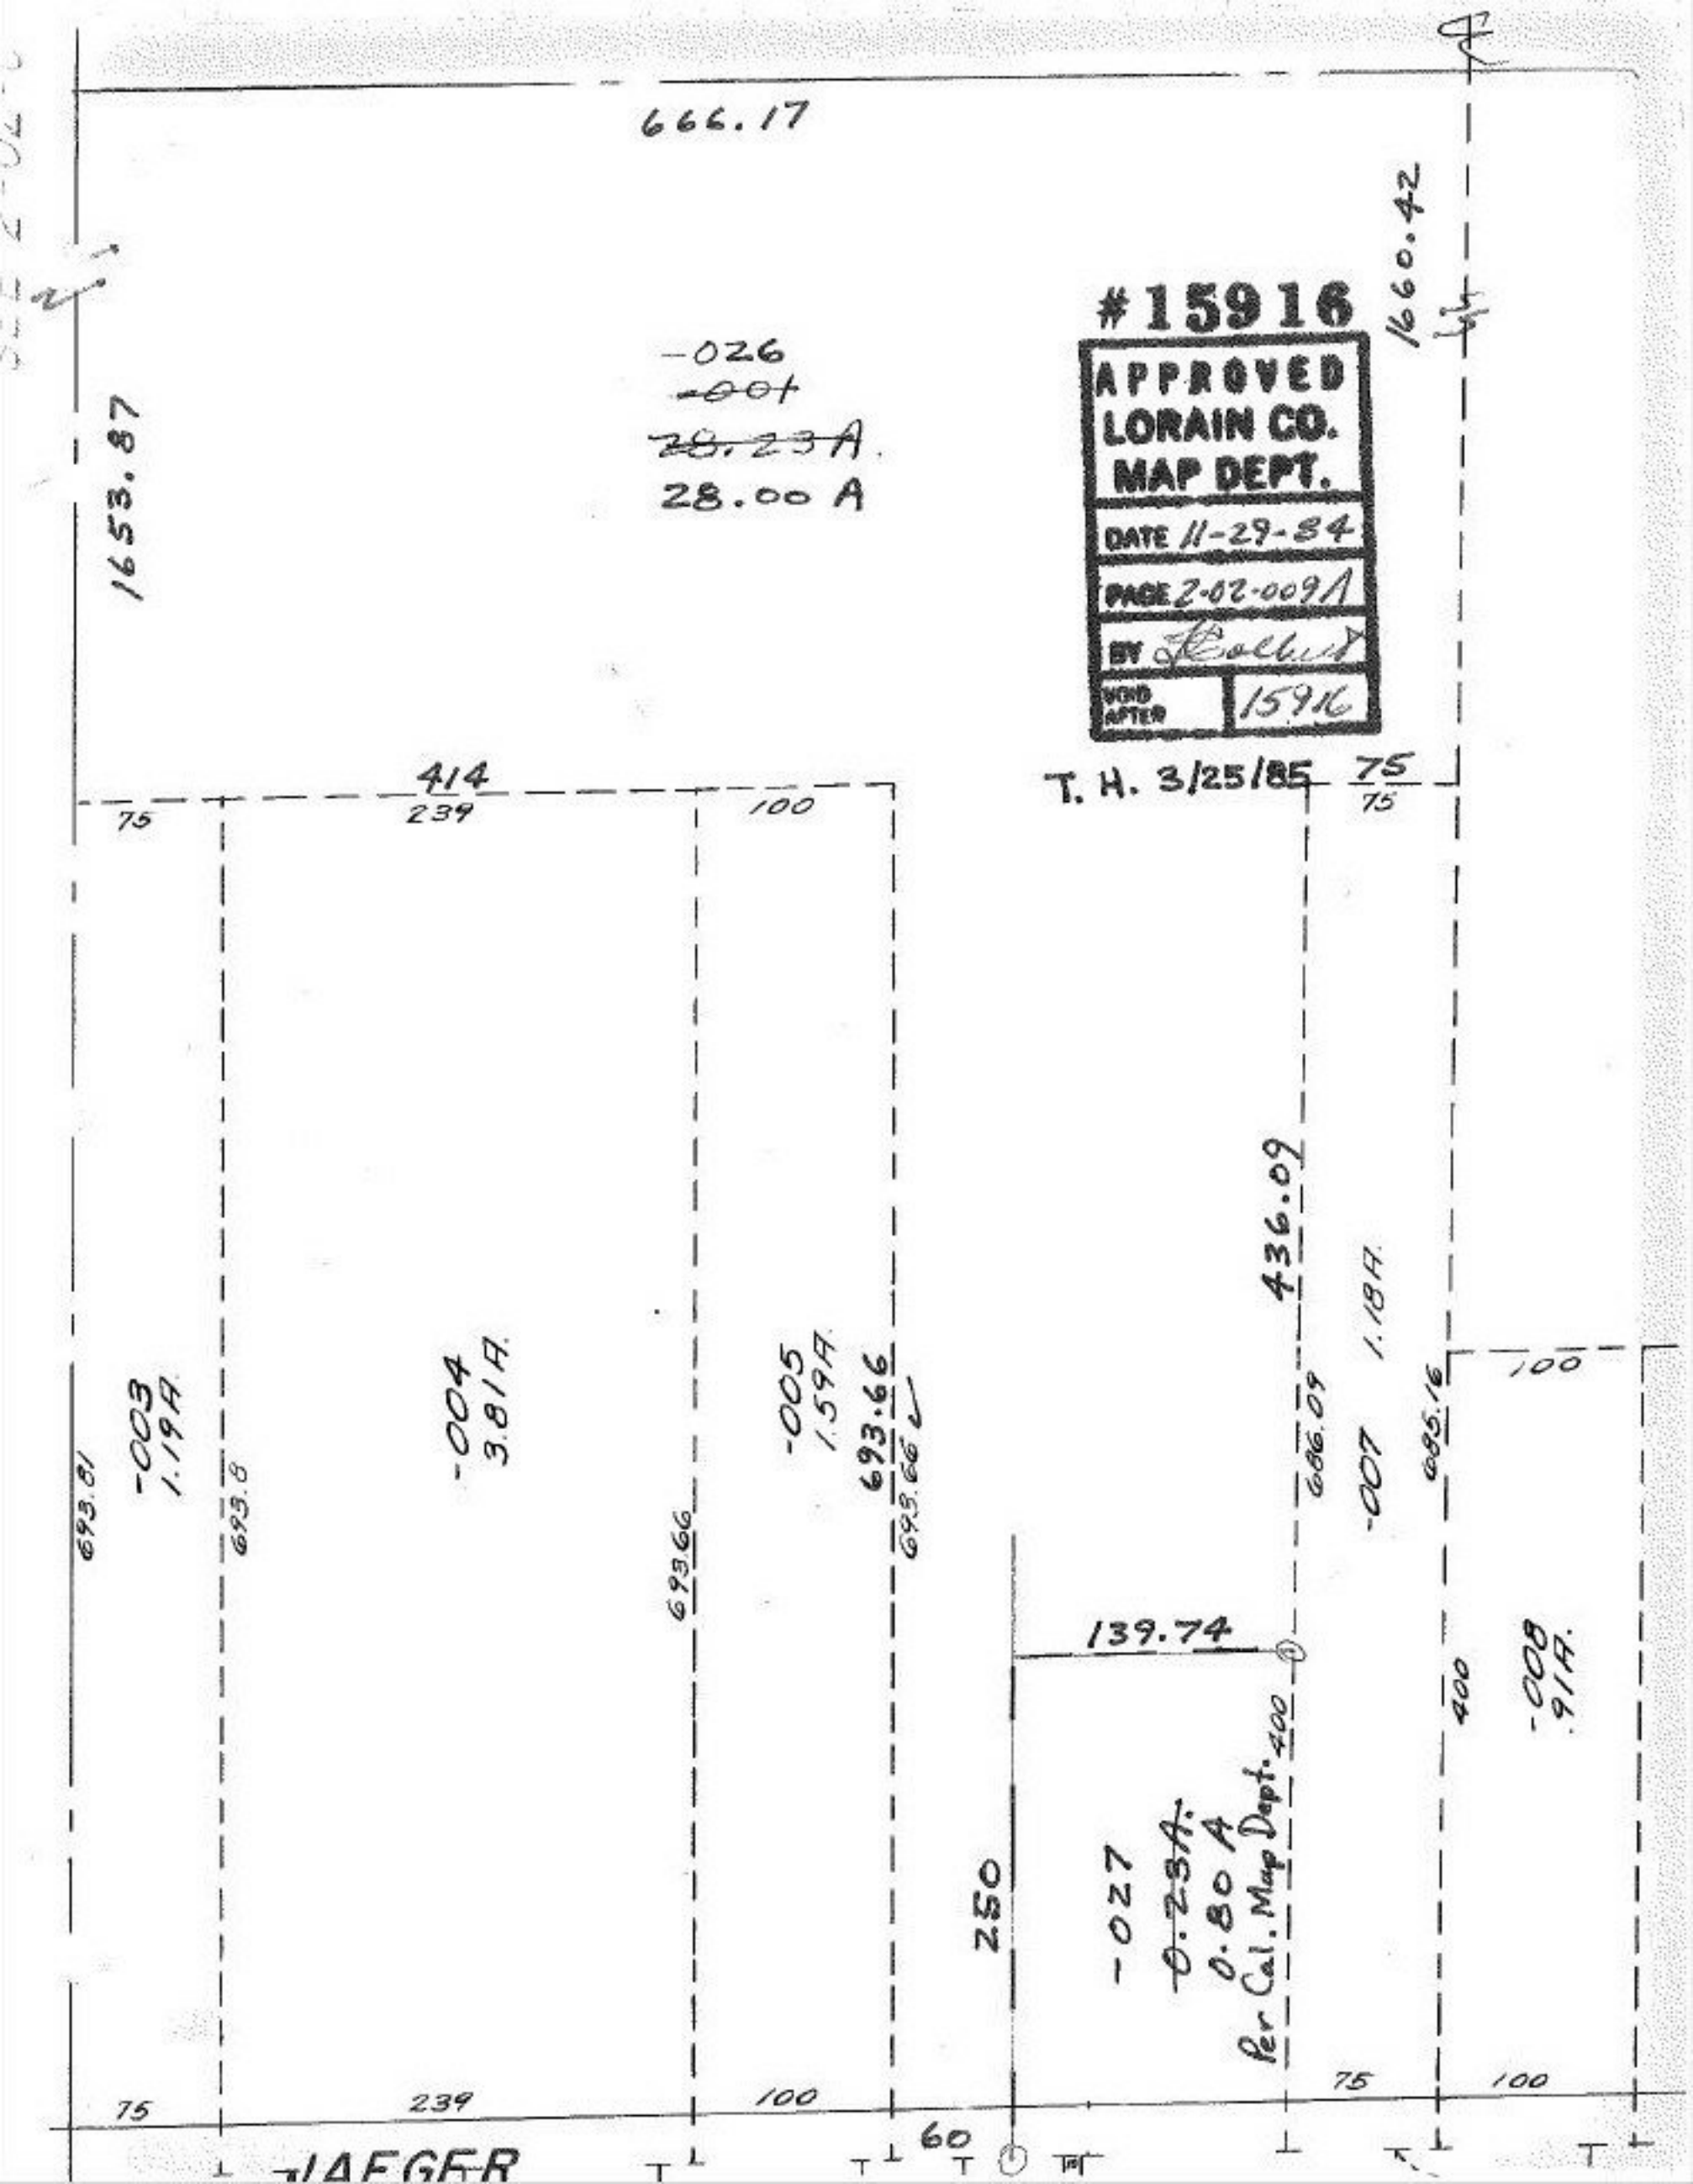
666.17
1660.42
1653.87
-026
~~-001~~
~~28.23 A~~
28.00 A
#15916
APPROVED
LORAIN CO.
MAP DEPT.
DATE 11-29-84
PAGE 2-02-009A
BY
VOID AFTER 15916
T. H. 3/25/85
75
75
414
239
100
75
436.09
1.18A
-003
1.19A
-004
3.81A
-005
1.59A
693.66
693.66
693.81
693.8
693.66
686.09
-007
685.16
100
139.74
400
-008
.91A
250
-027
~~0.23A~~
0.80 A
Per Cal. Map Dept.
400
75
239
100
75
100
60
JAEGER