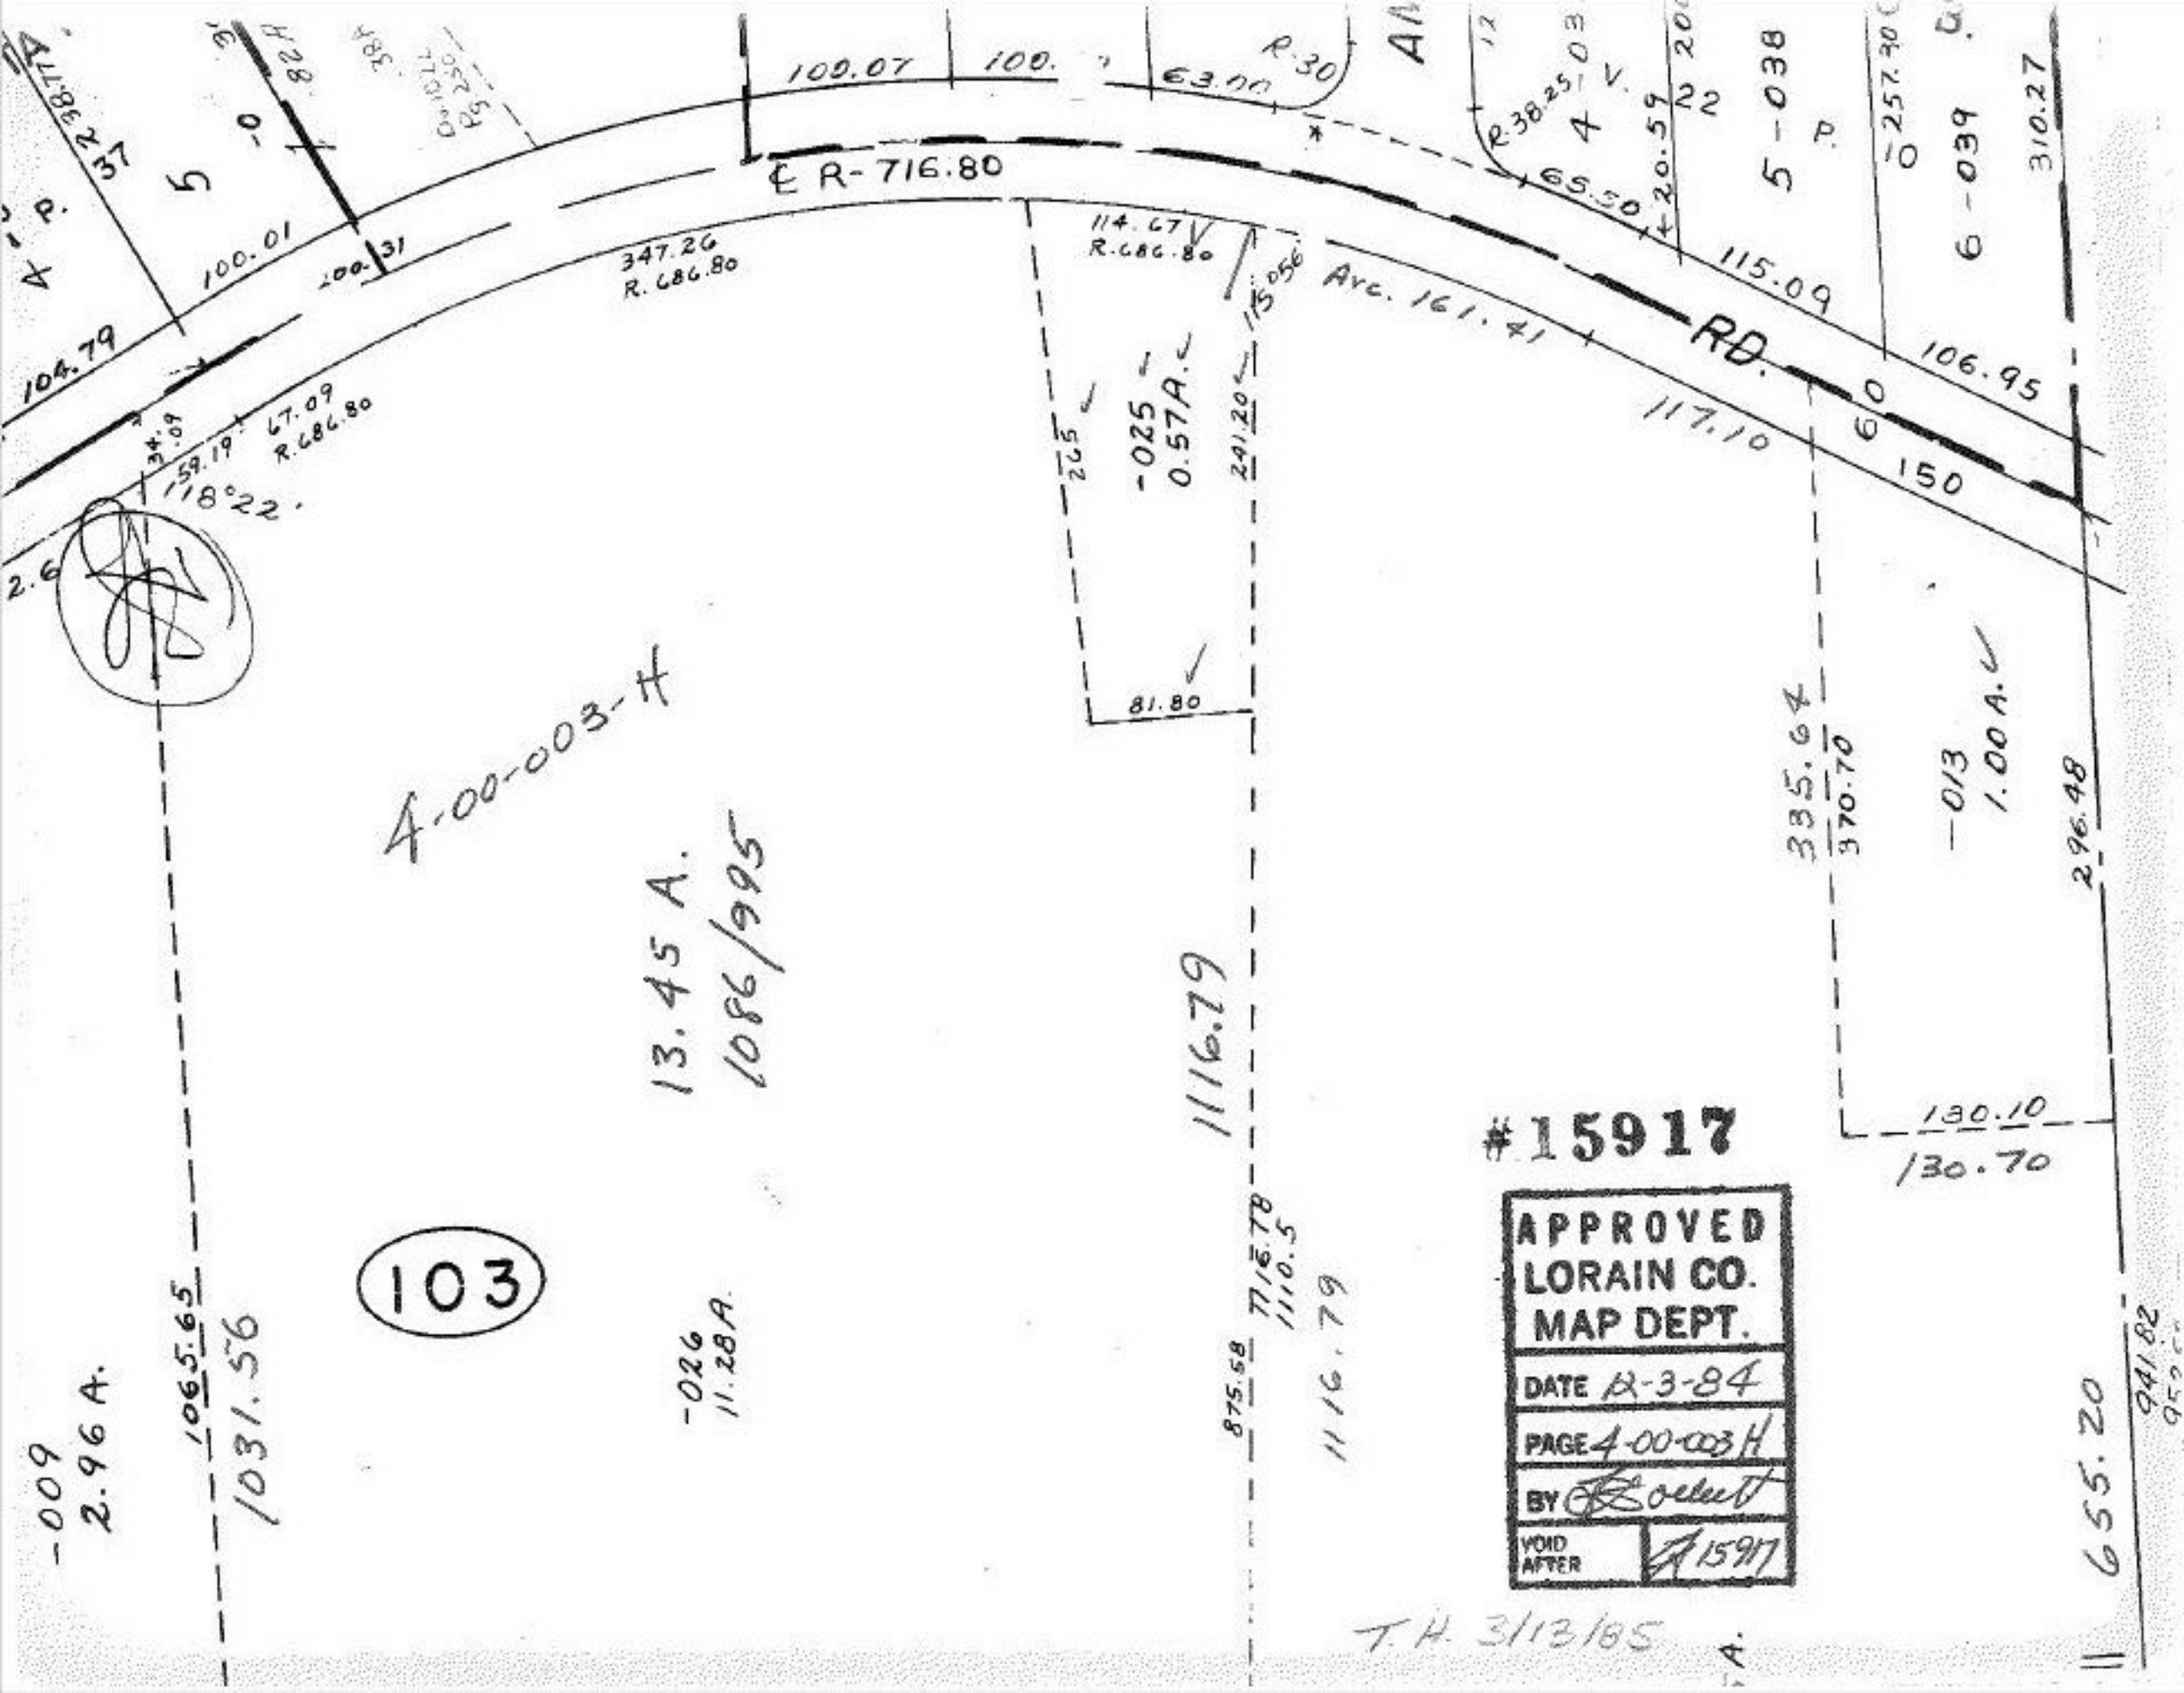

#15917

APPROVED
LORAIN CO.
MAP DEPT.
DATE 12-3-84
PAGE 4-00-003 H
BY [signature]
VOID AFTER 15917