4-G

4-00-022

1592

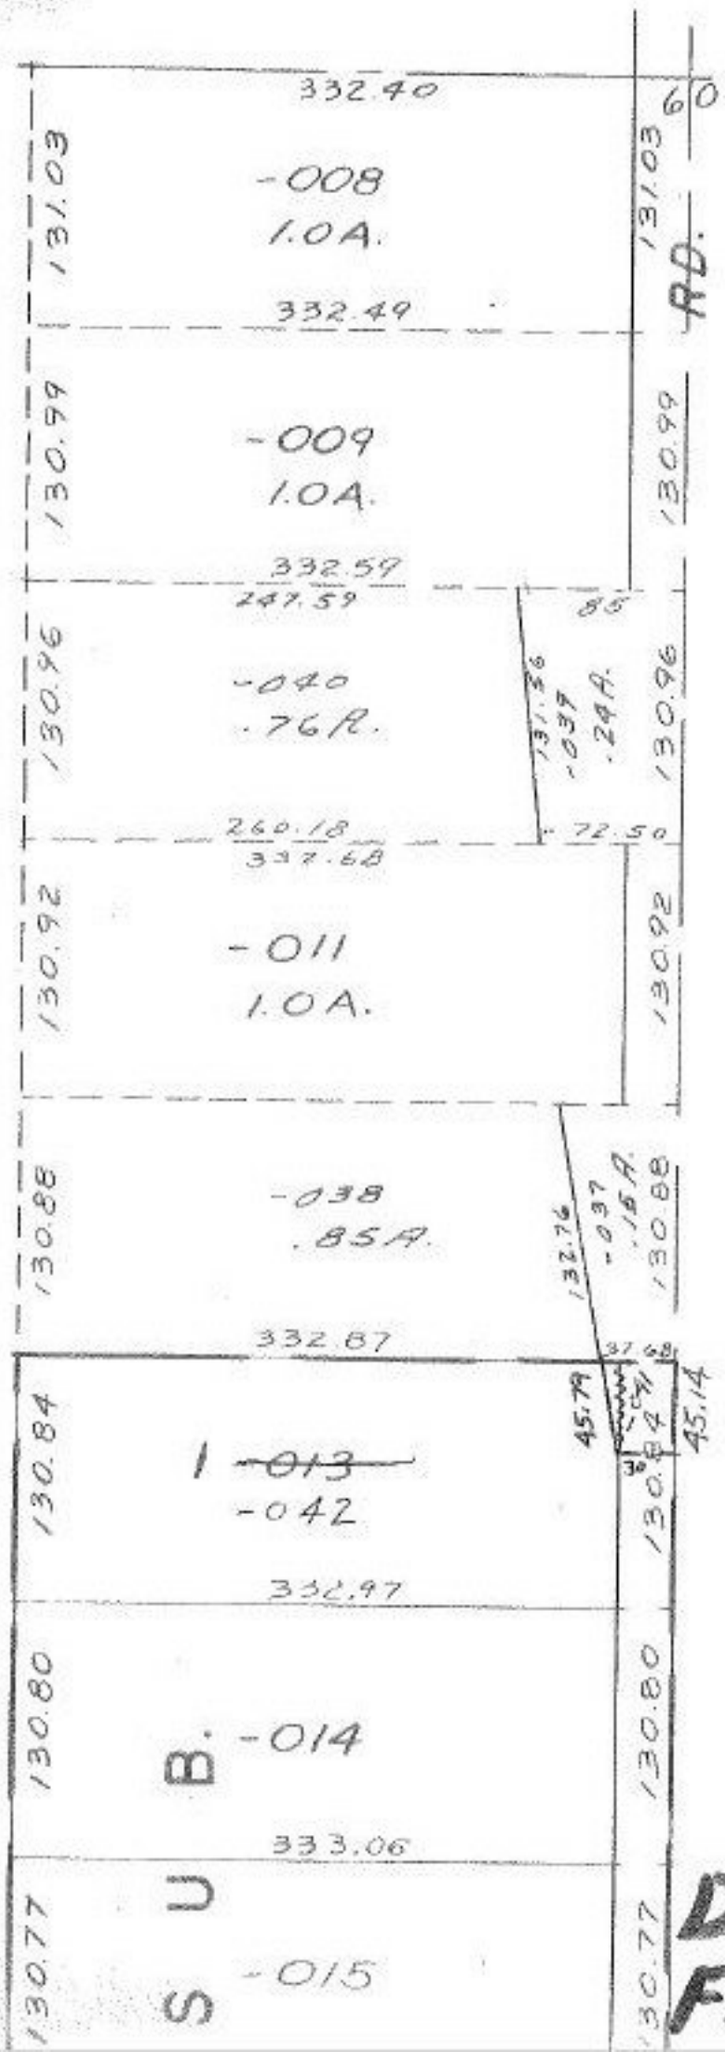

7-15-81 BMB

APPROVED
LORAIN CO.
MAP DEPT.
DATE 3-14-68
4-00-022-B
BY D. Maynard

DONE 5-9-68
FRANK COLBERT