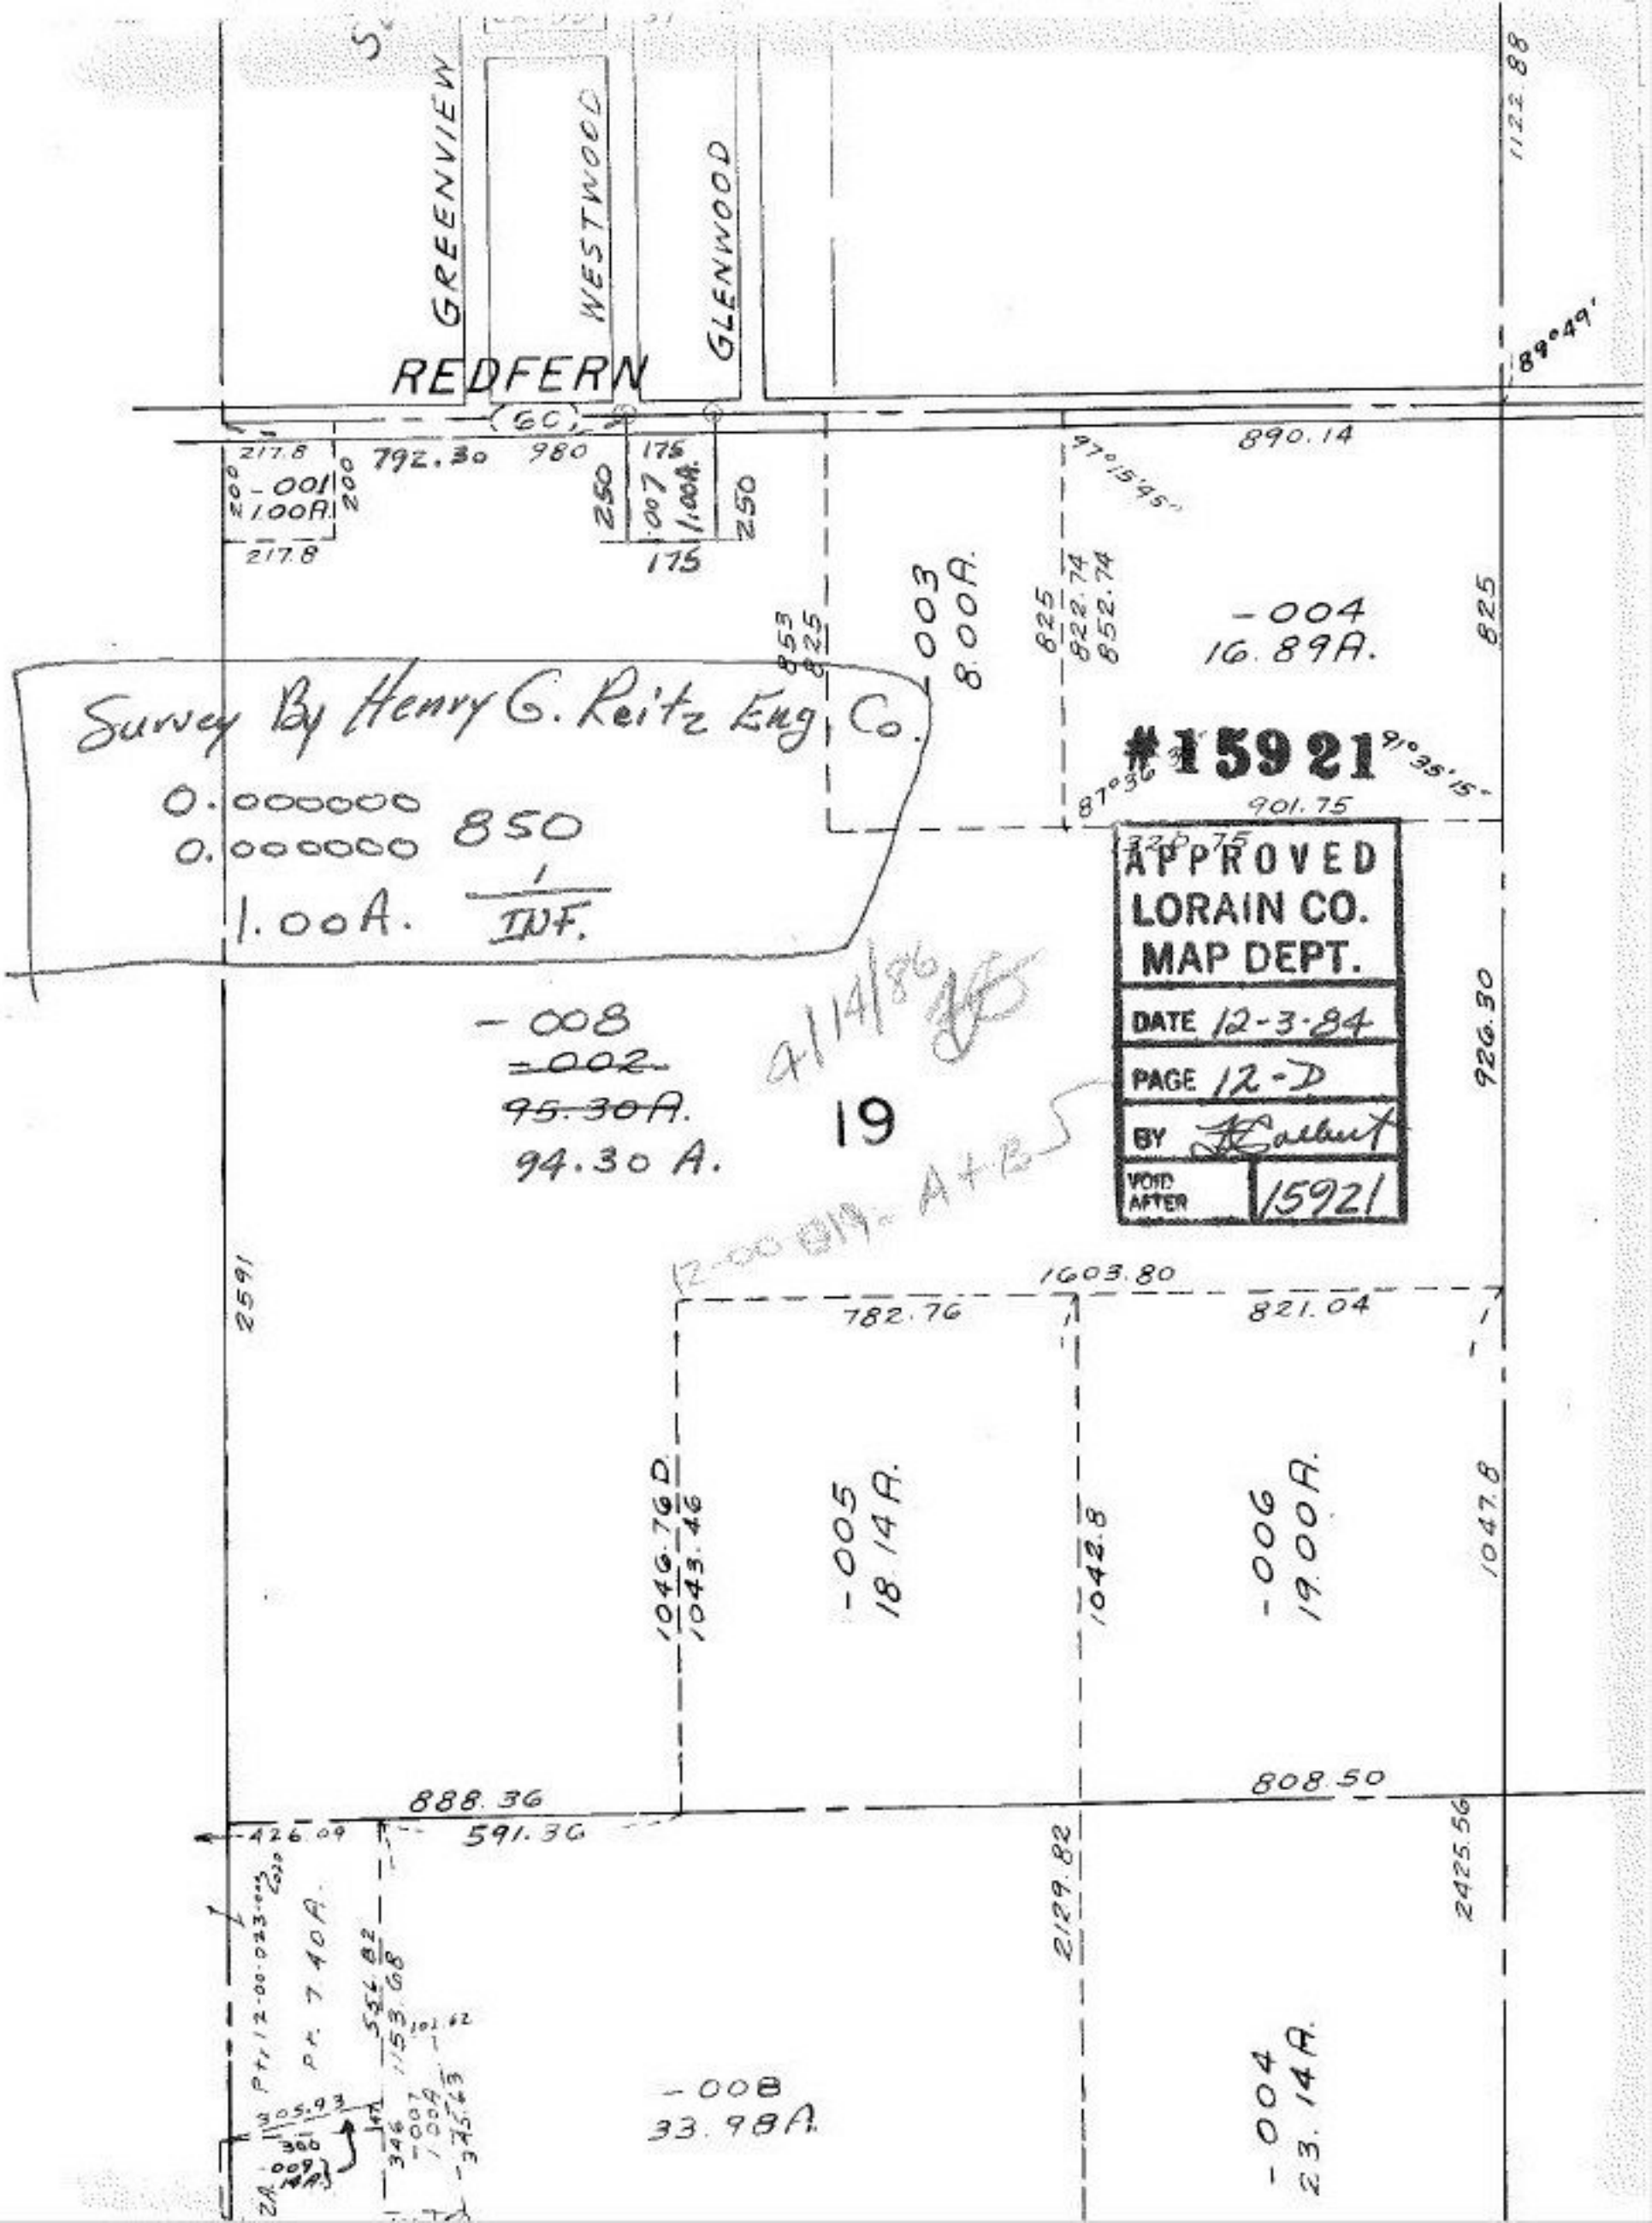
GREENVIEW
WESTWOOD
GLENWOOD
REDFERN
(60)
1122.88
89°49'
890.14
97°15'45"
217.8
792.30
980
175
250
-001
1.00A.
200
217.8
-007
1.00A.
175
250
853
825
-003
8.00A.
825
822.74
852.74
-004
16.89A.
825
Survey By Henry G. Reitz Eng. Co.
0.000000
0.000000
850
1.00A.
1
INF.
#15921
87°36'
91°35'15"
901.75
APPROVED
LORAIN CO.
MAP DEPT.
DATE 12-3-84
PAGE 12-D
BY
VOID AFTER 15921
-008
~~-002~~
~~95.30A.~~
94.30 A.
4/14/86
19
926.30
12-00-019 - A+B
2591
1603.80
782.76
821.04
1046.76 D.
1043.46
-005
18.14A.
1042.8
-006
19.00A.
1047.8
888.36
591.36
808.50
426.09
2129.82
2425.56
Pt. 12-00-023-003
Pt. 7.40A.
556.82
1153.68
101.62
305.93
300
-009
14A.
346
-007
1.00A.
345.63
-008
33.98A.
-004
23.14A.