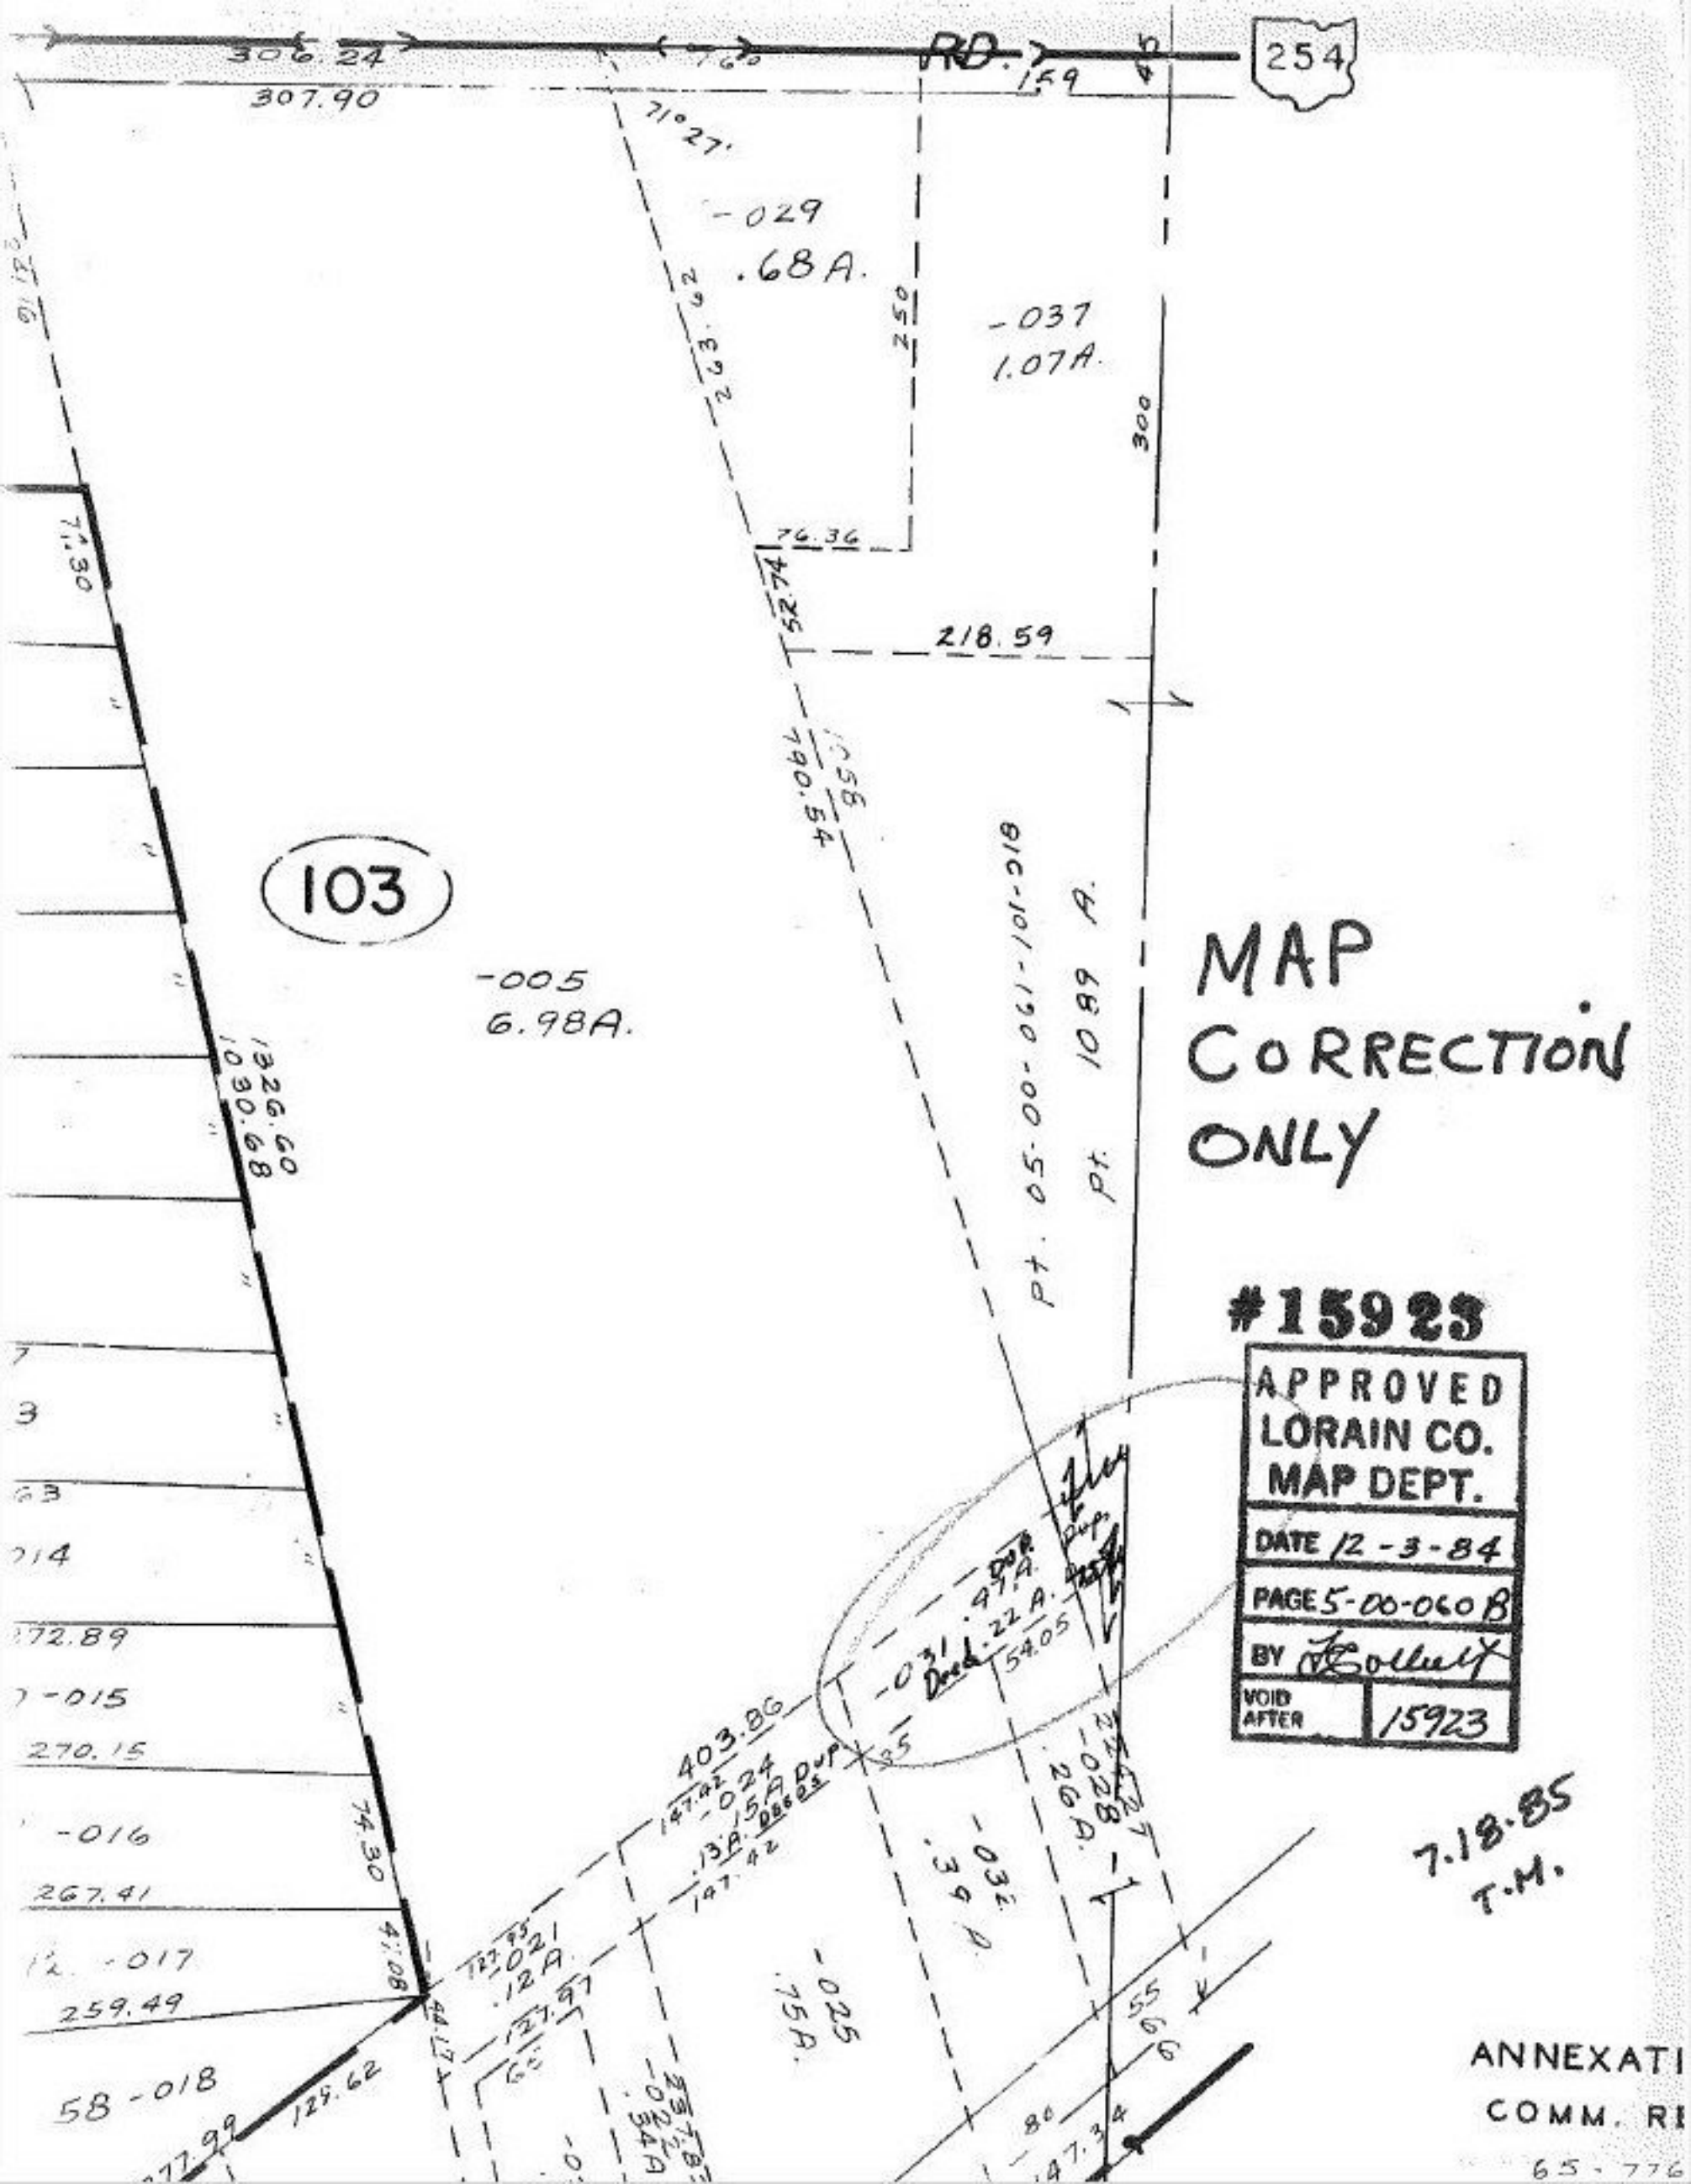

254
RD.
306.24
307.90
71°27'
-029
.68A.
263.62
250
-037
1.07A.
300
76.36
52.74
218.59
790.54
103
-005
6.98A.
1326.60
1030.68
pt. 05-00-061-101-018
pt. 1089 A.
MAP
CORRECTION
ONLY
#15923
APPROVED
LORAIN CO.
MAP DEPT.
DATE 12-3-84
PAGE 5-00-060 B
BY
VOID AFTER 15923
403.86
-024
.15A Dup
-031
.47A.
Deed .22 A.
54.05
-028
.26A.
-032
.39 A.
-025
.75A.
-021
.12A.
-016
267.41
-017
259.49
58-018
129.62
74.30
7.18.85
T.M.
ANNEXATI
COMM. RE
65-776