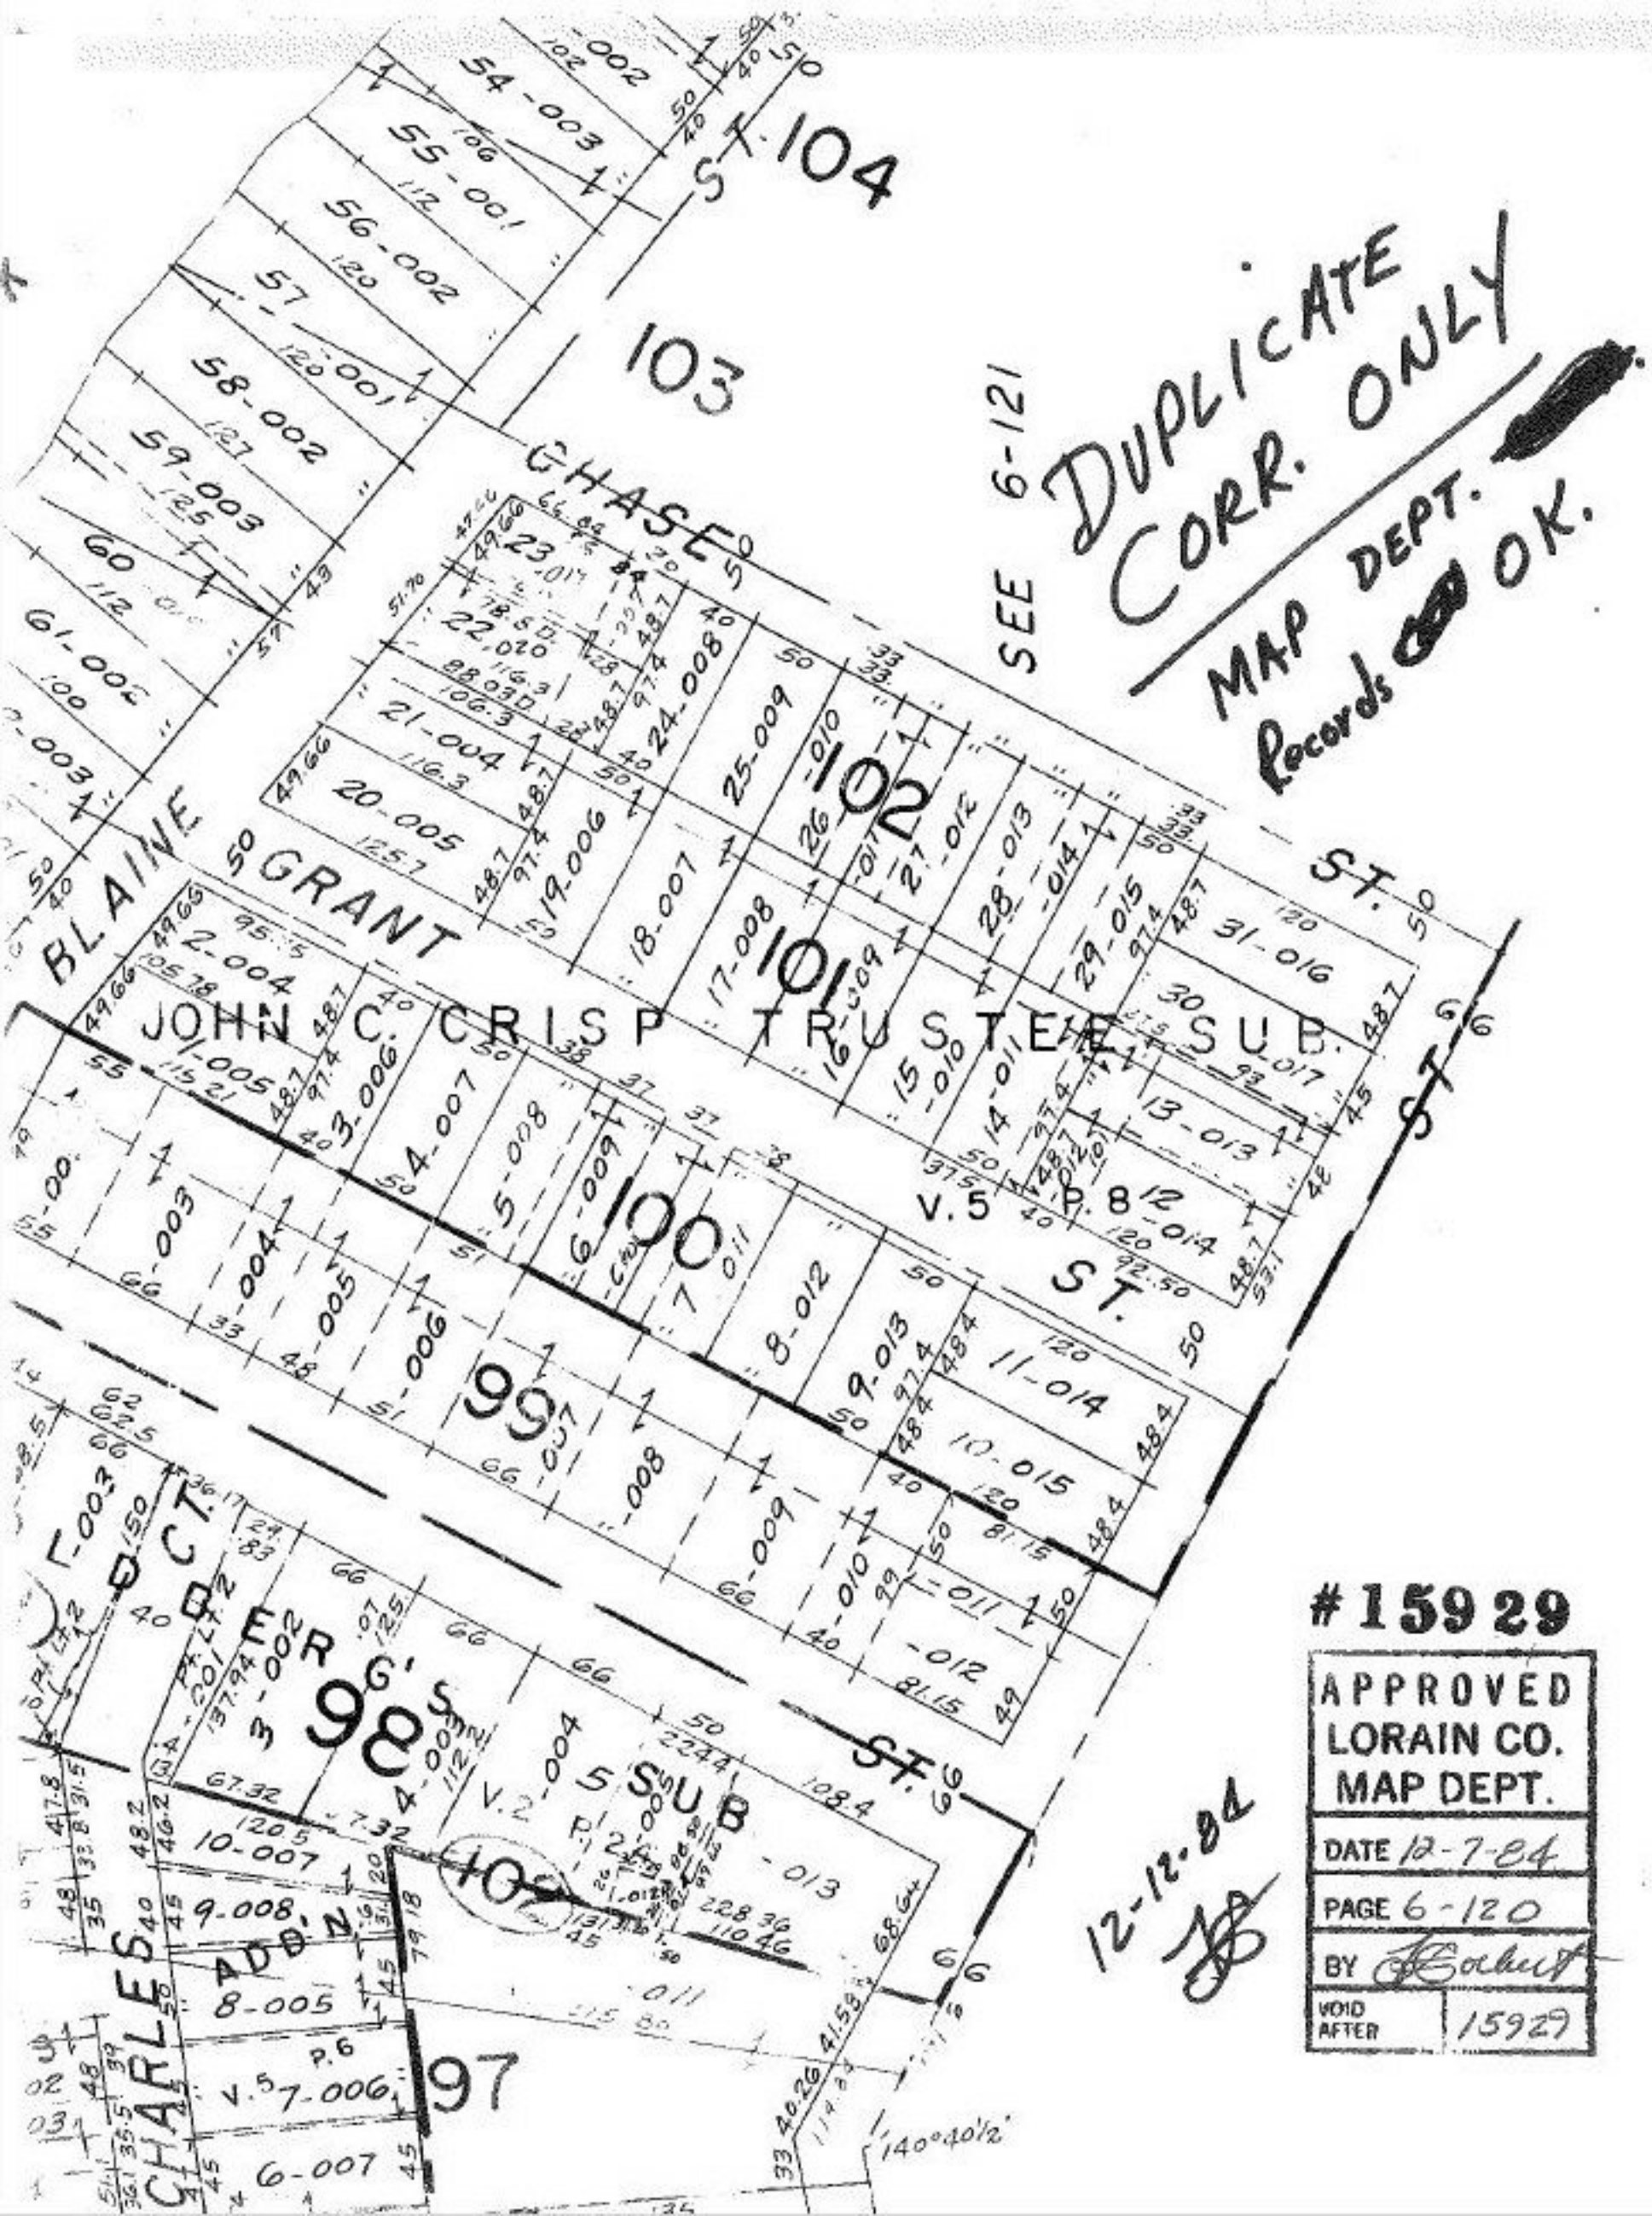

15929

APPROVED
LORAIN CO.
MAP DEPT.

DATE 12-7-84

PAGE 6-120

BY

VOID AFTER 15929