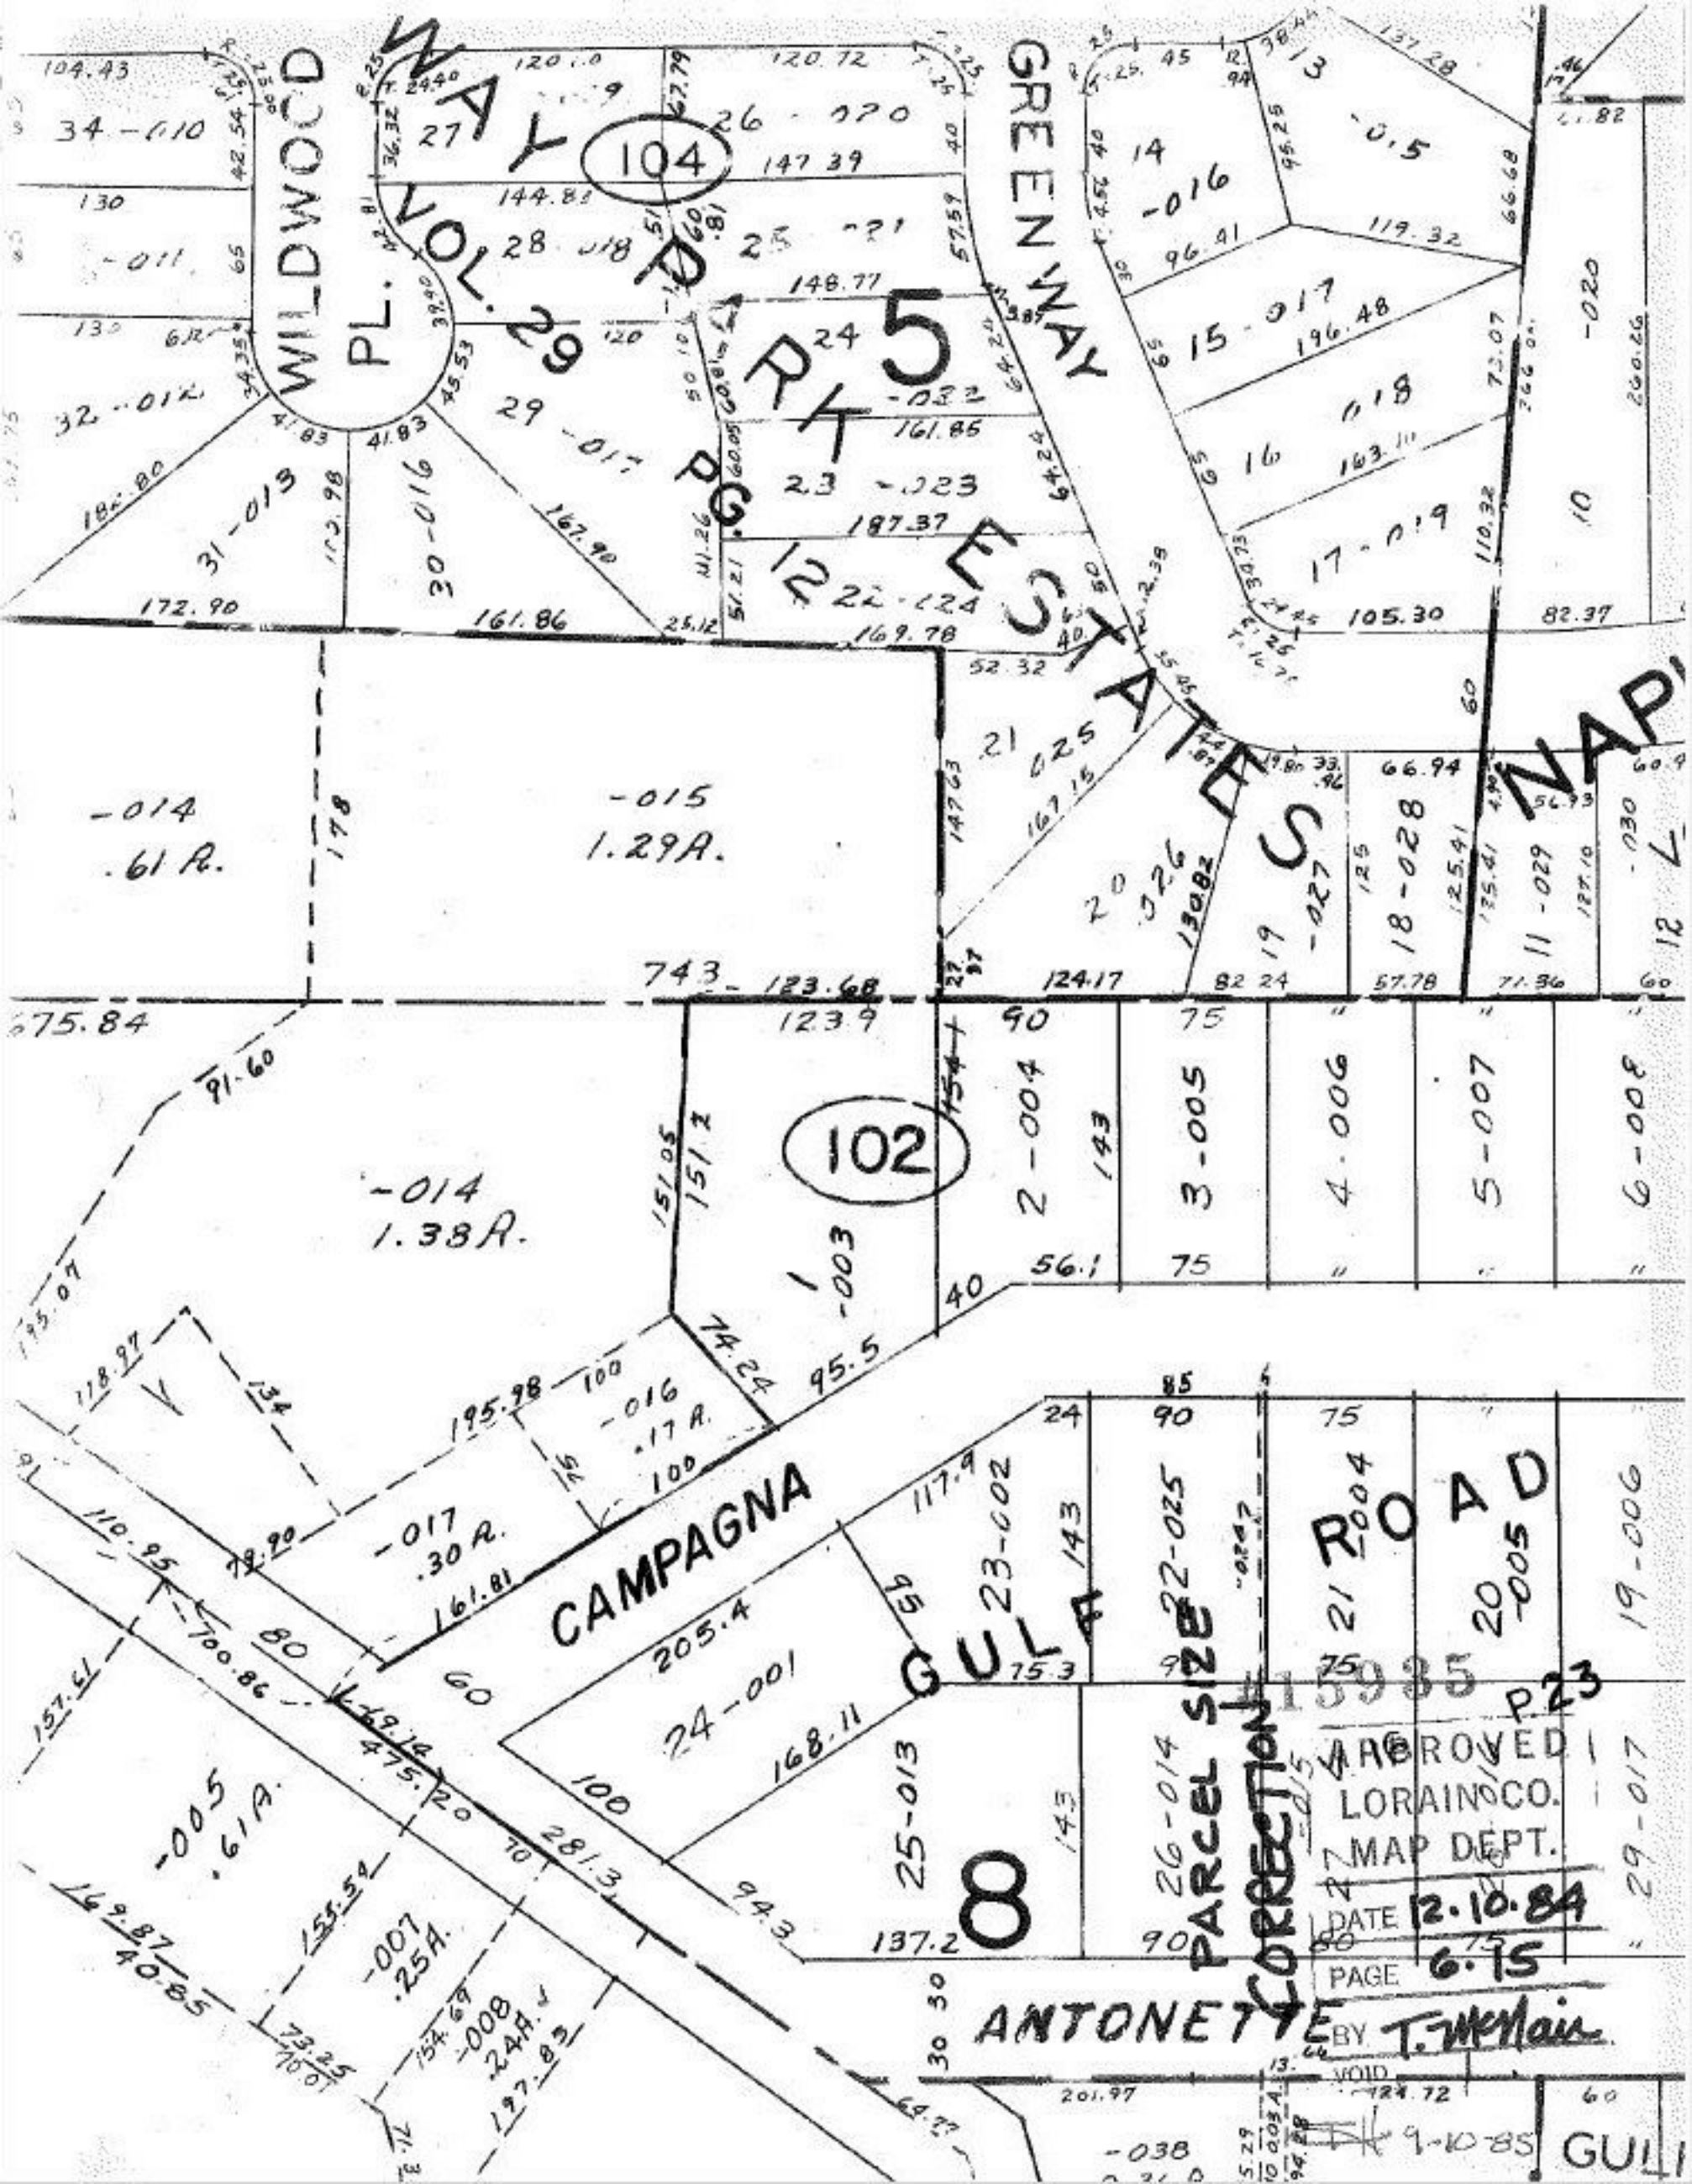
WILDWOOD PL.
WAY
VOL. 29
PARK
PG. 12
ESTATES
GREENWAY
NAP
104
102
5
8
CAMPAGNA
GULF
ROAD
PARCEL SIZE CORRECTION
ANTONETTE
-014 .61 A.
-015 1.29A.
-014 1.38A.
-016 .17 A.
-017 .30 A.
-005 .61A.
-007 .25A.
-008 .24A.
-038
#15935
P.23
APPROVED
LORAIN CO.
MAP DEPT.
DATE 12.10.84
PAGE 6.15
BY T. McNair
VOID
9-10-85
GULF