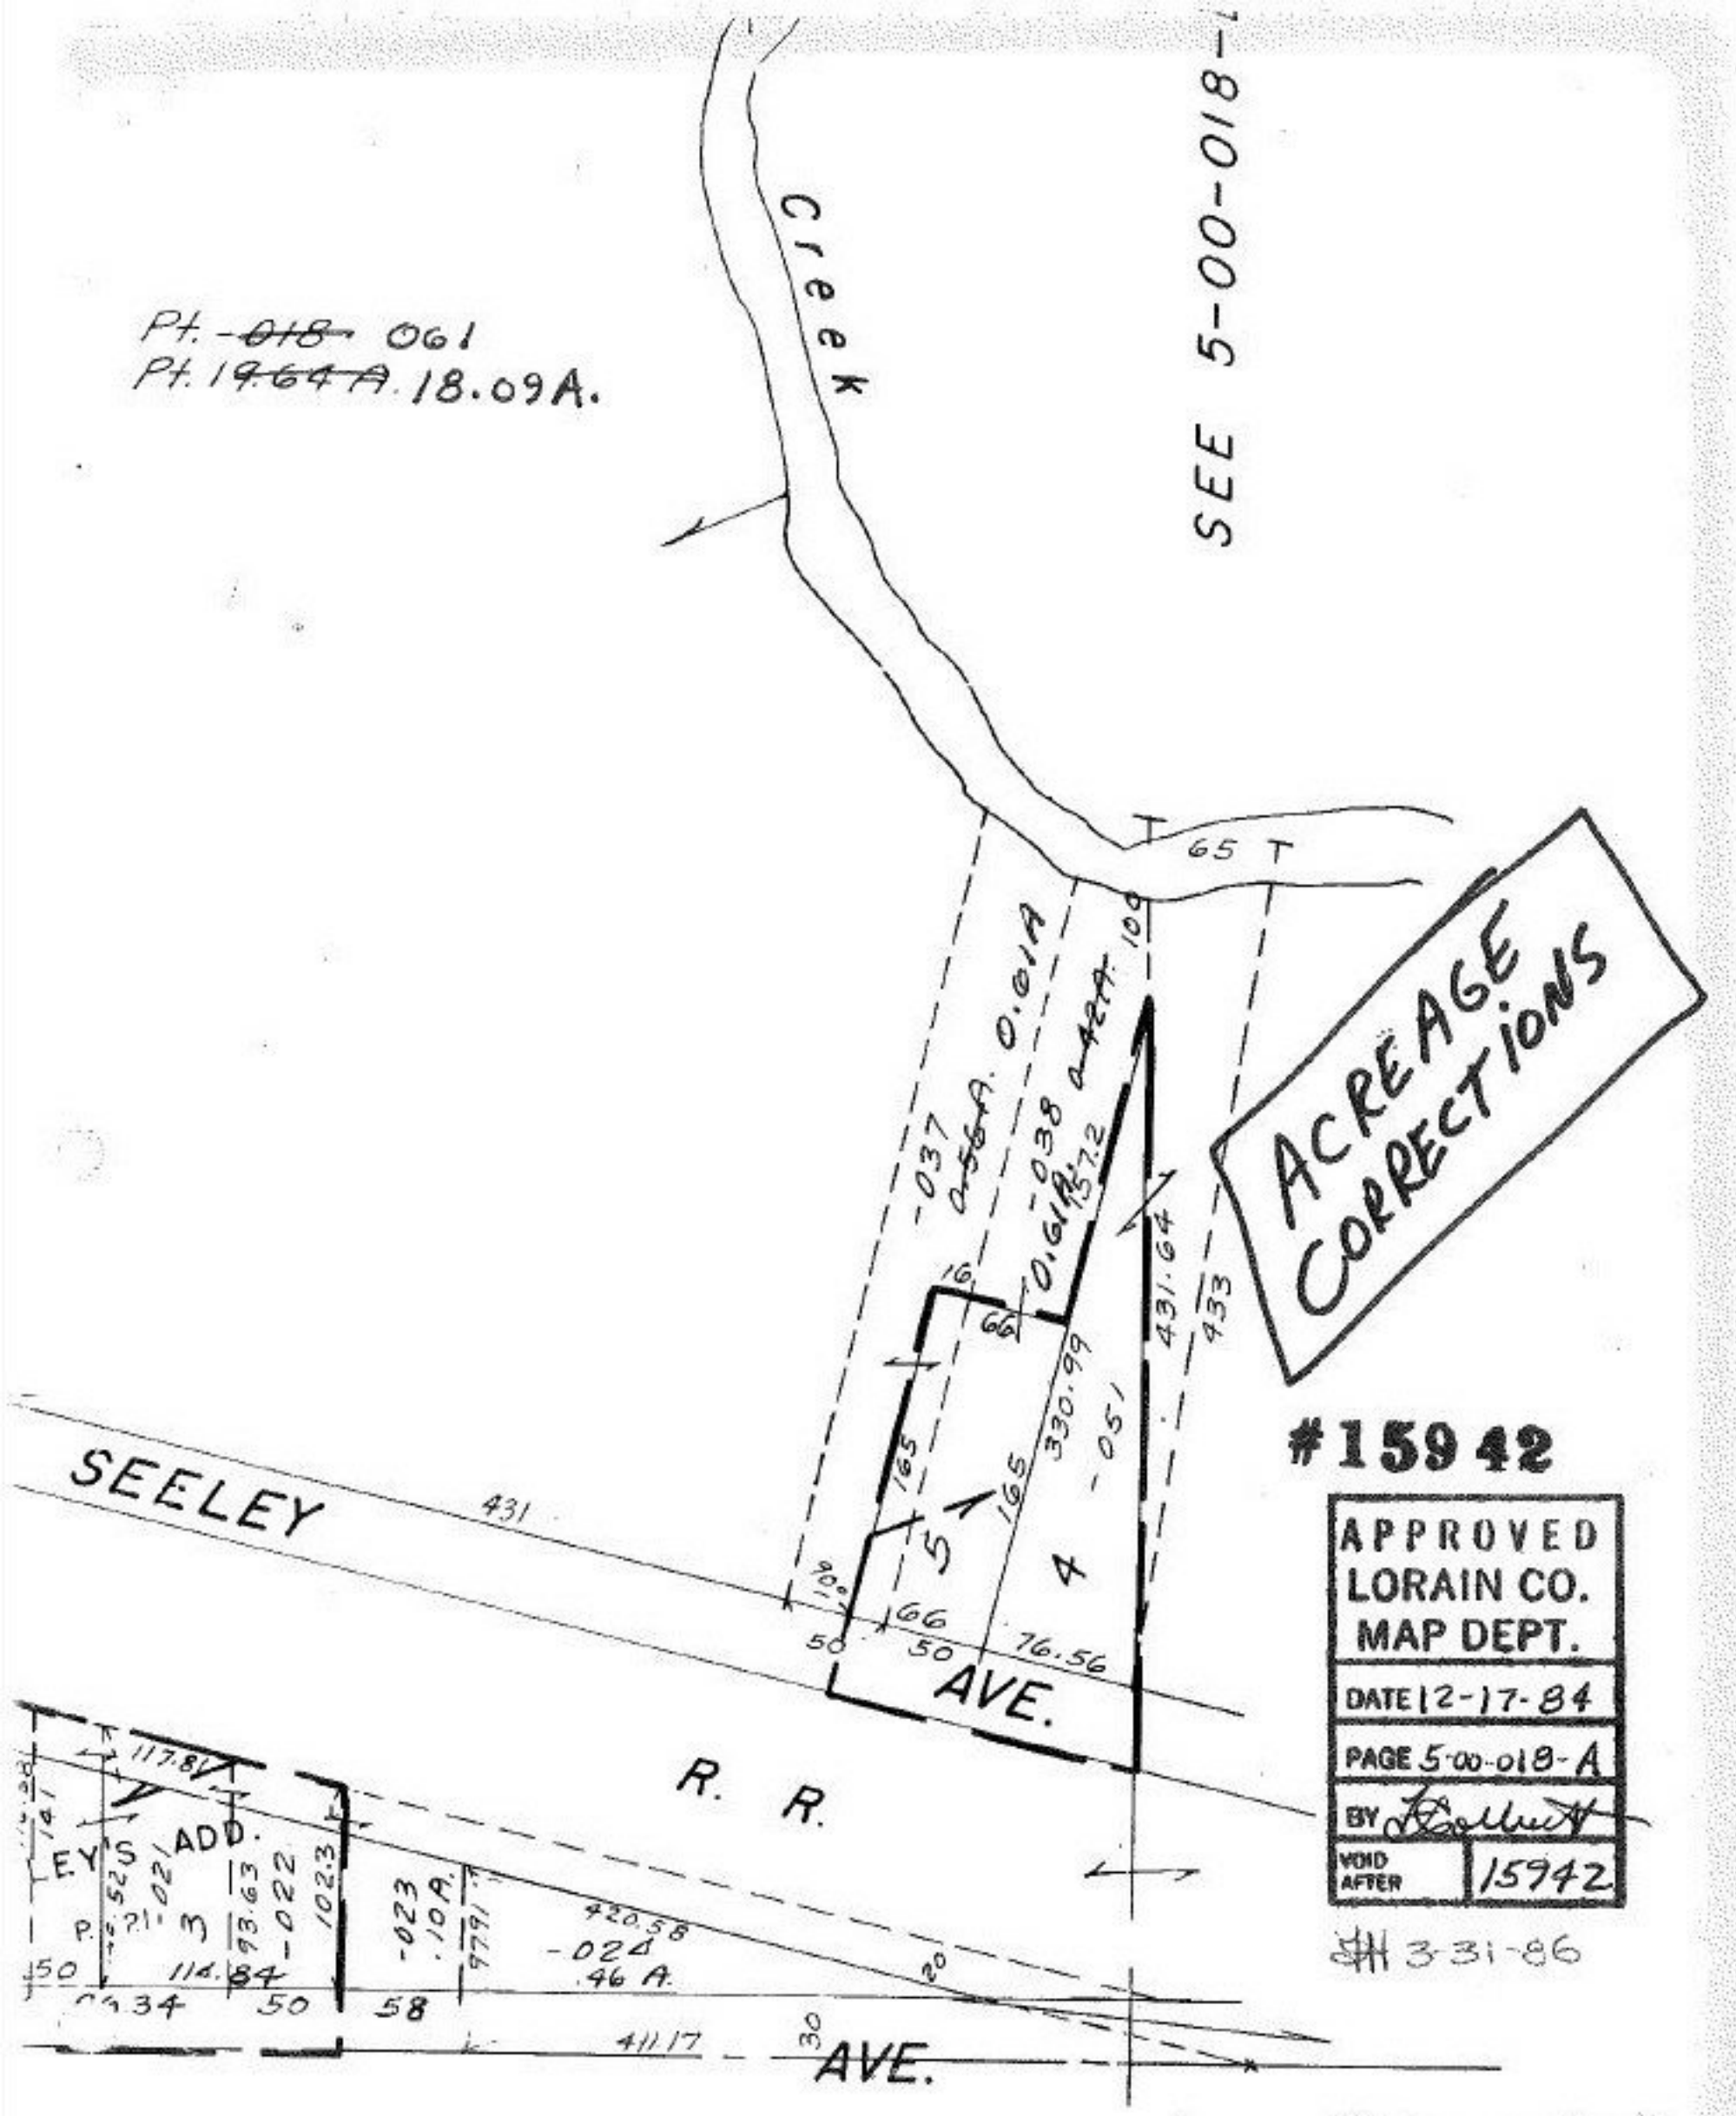


#15942

APPROVED
LORAIN CO.
MAP DEPT.

DATE 12-17-84

PAGE 5-00-018-A

BY [signature]

VOID AFTER 15942

3-31-86

5-00-018-A