PARCEL No. 126 WD

THESE DIMENSIONS PROVIDED BY SURVEY BY RICHLAND ENGINEERING AND DON'T NECESSARILY AGREE WITH ANY DIMENSIONS OF RECORD.

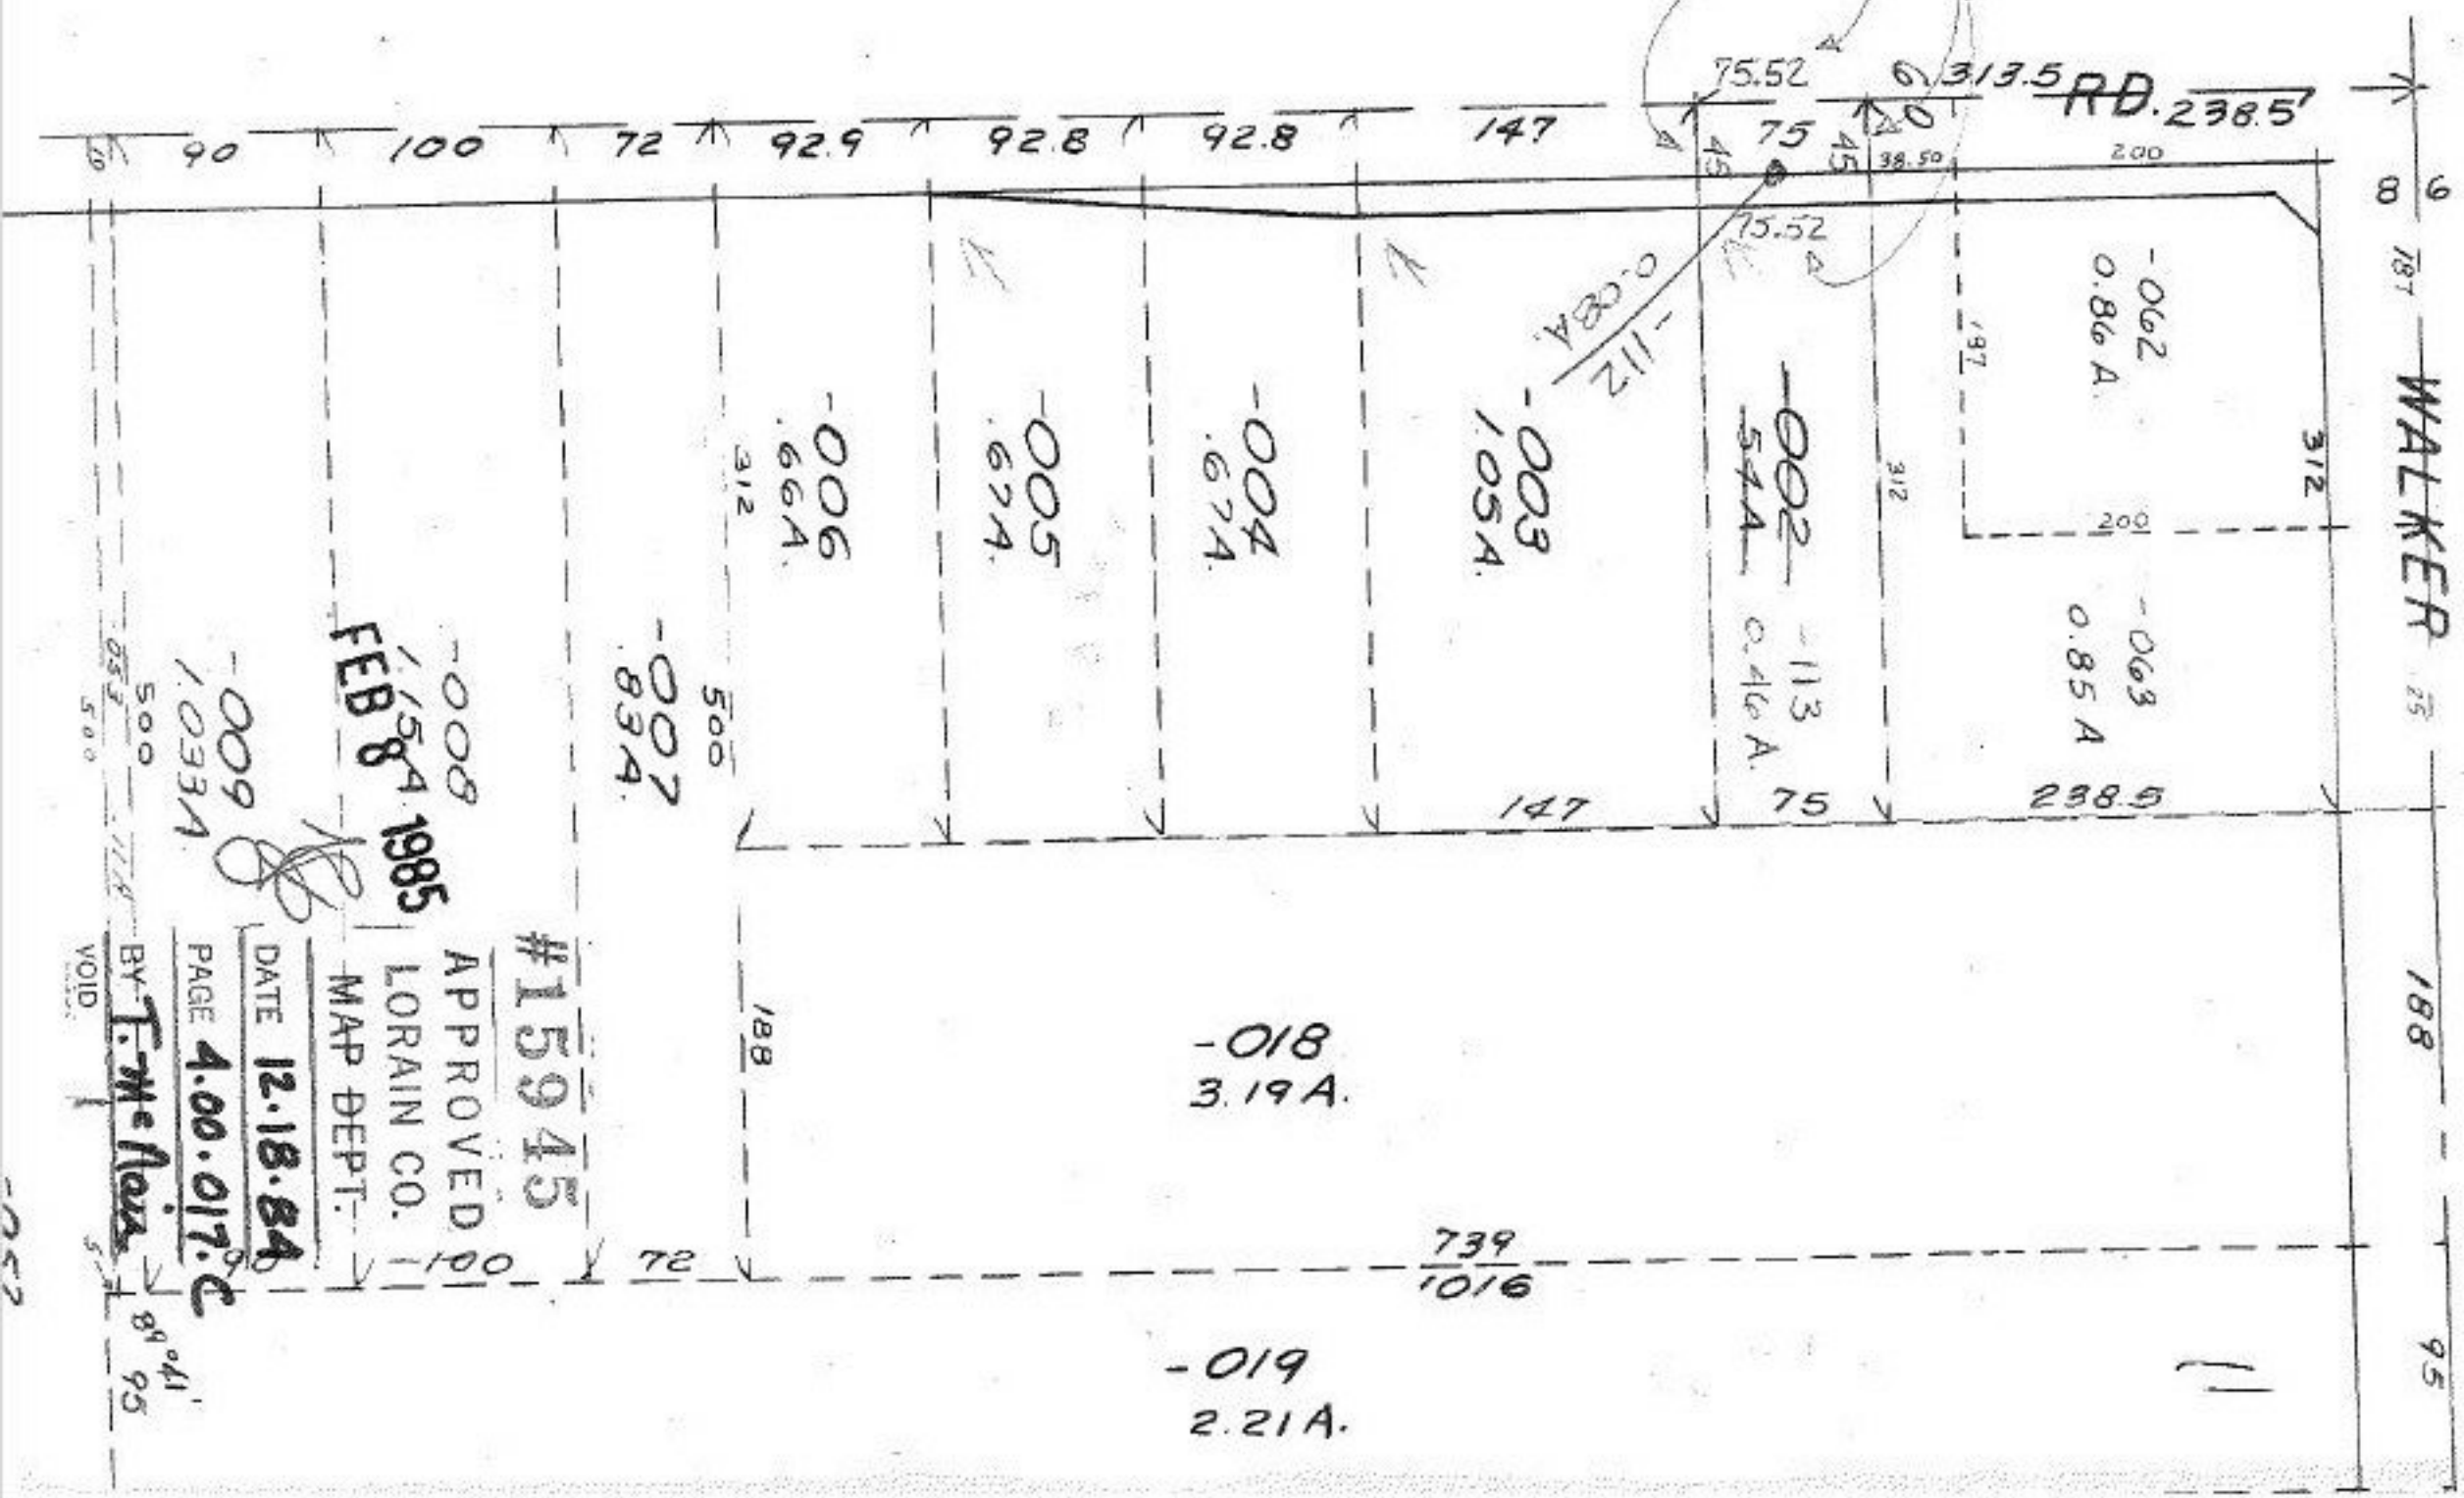


FEB 8 1985

#15945
APPROVED
LORAIN CO.
MAP DEPT.
DATE 12.18.84
PAGE 4.00.017.C
BY T. McNair
VOID