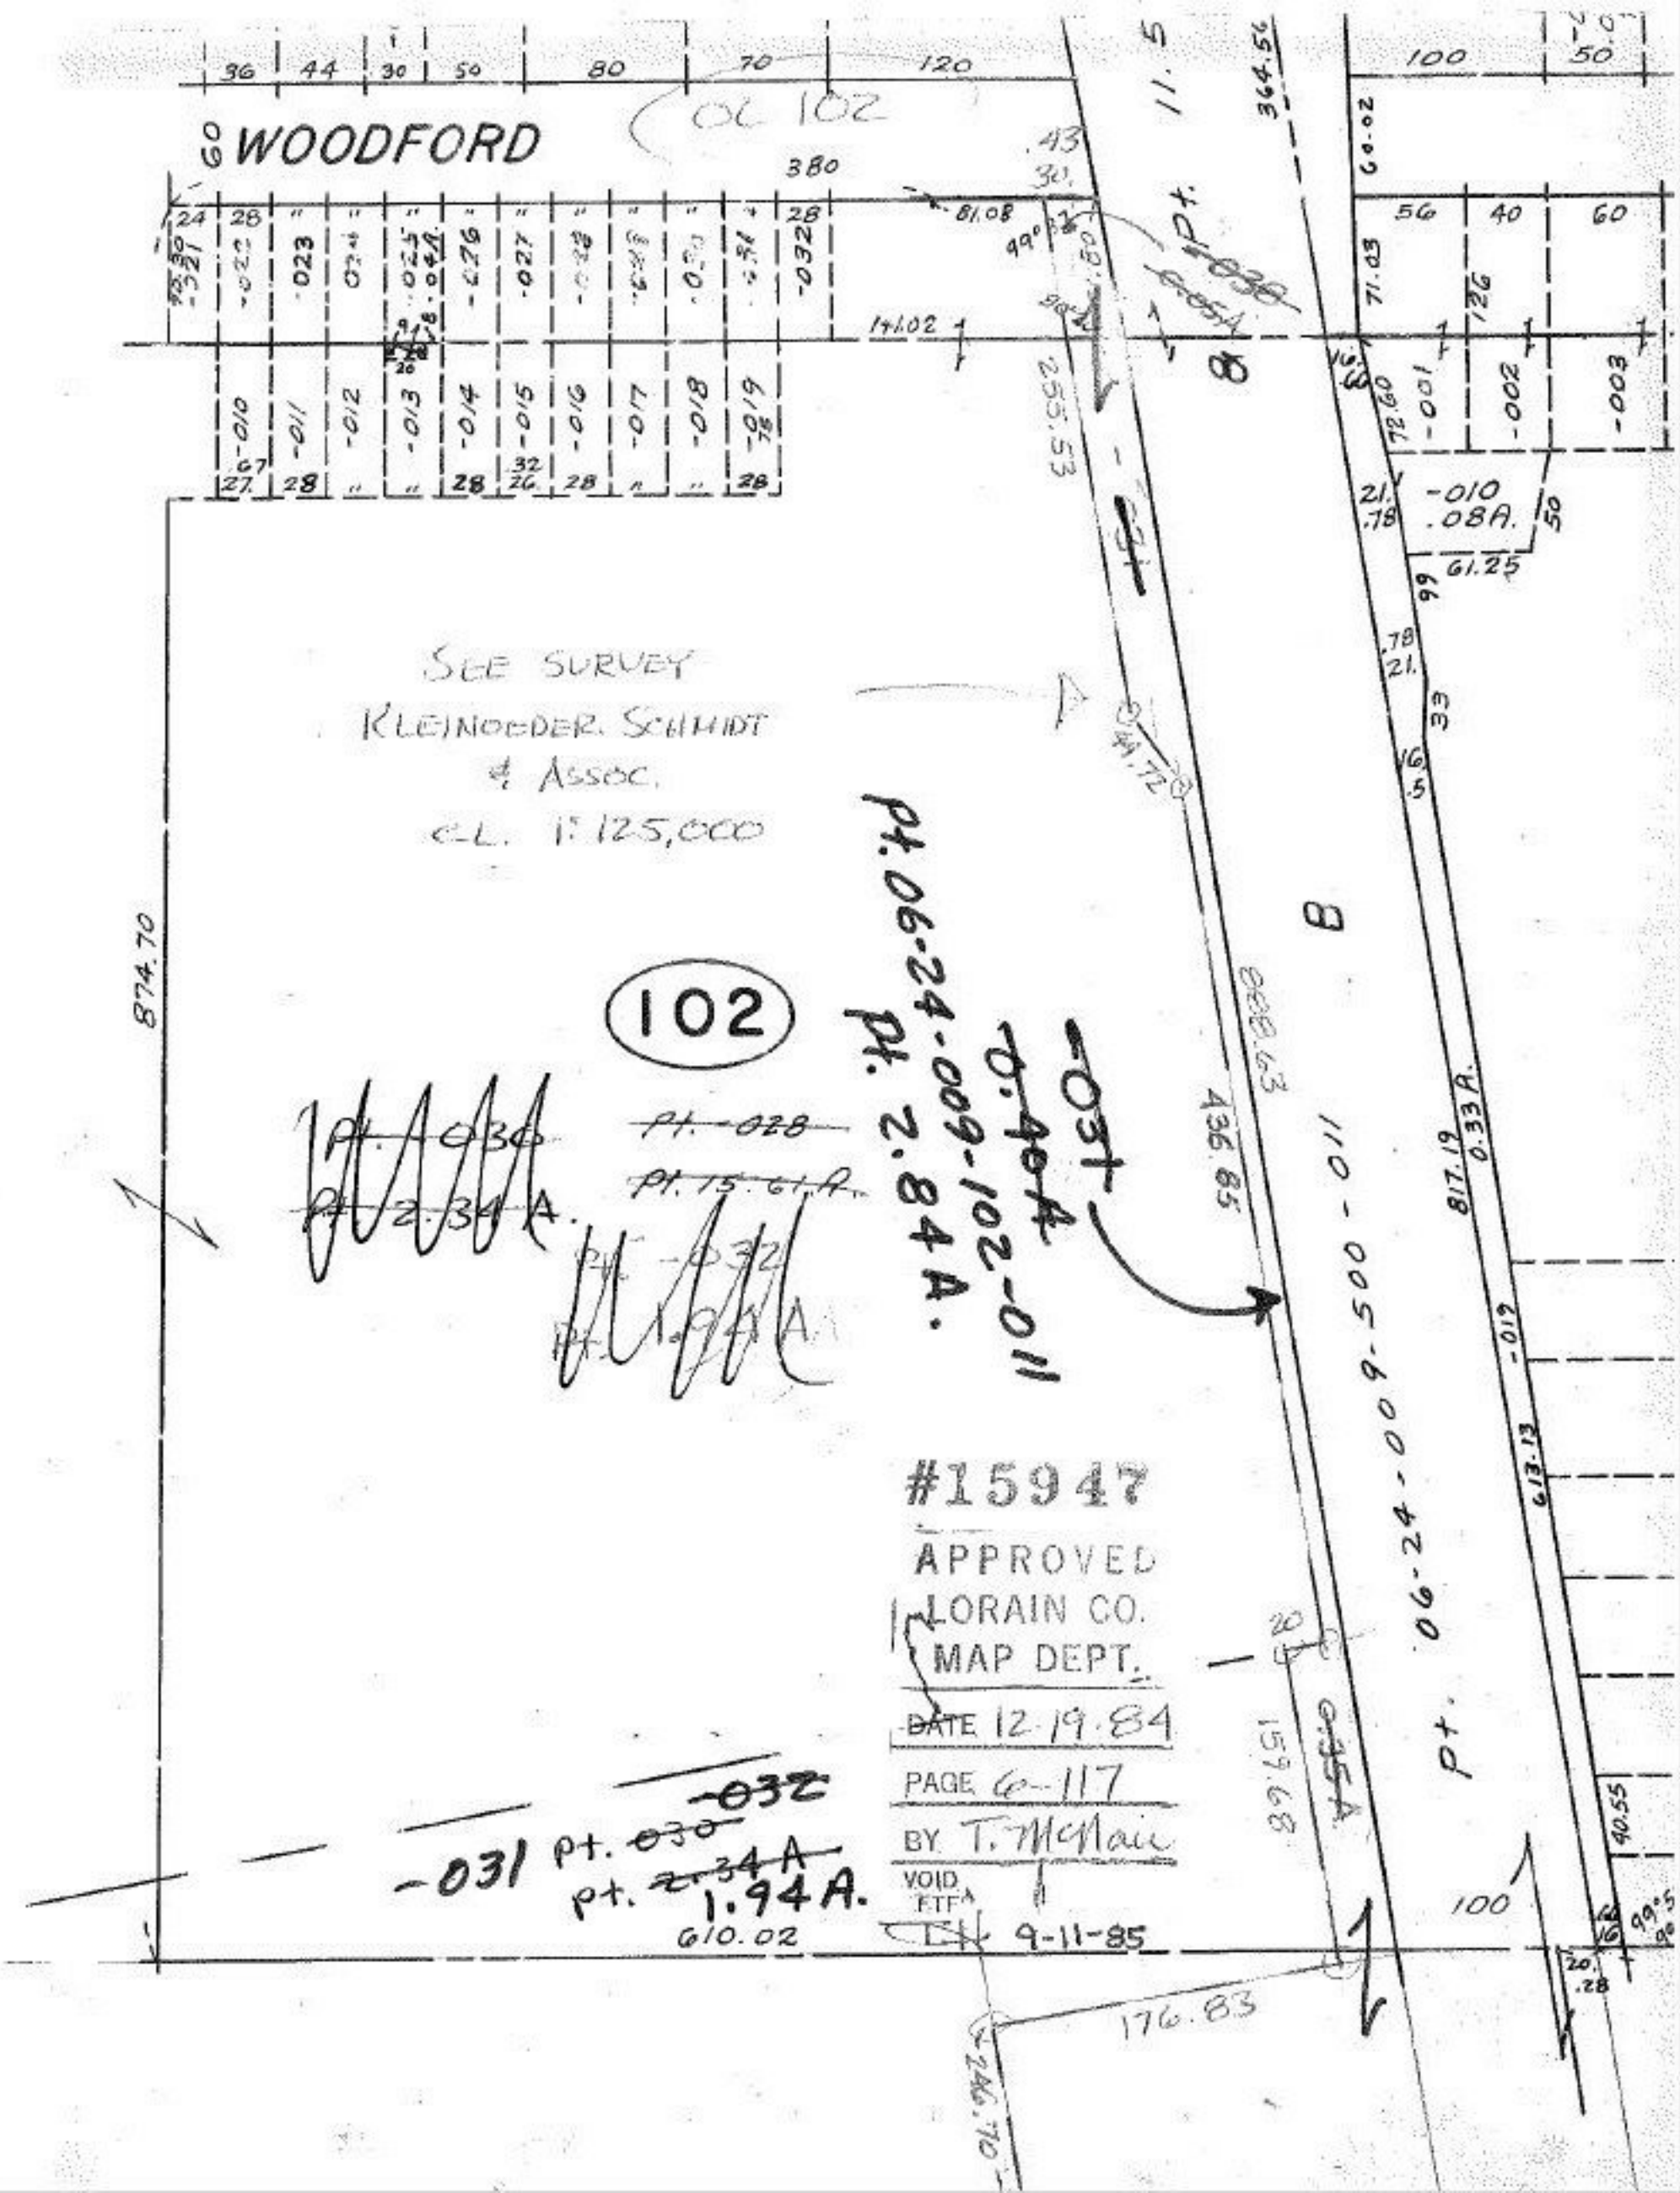
WOODFORD
SEE SURVEY
KLEINOEDER SCHMIDT
& ASSOC.
CL. 1:125,000
102
Pt. 06-24-009-500-011
Pt. 2.84 A.
-031
0.40 A
-009-102-011
Pt. 06-24-009-500-011
-031 Pt. ~~030~~ ~~-032~~
Pt. ~~2.34 A~~ 1.94 A.
#15947
APPROVED
LORAIN CO.
MAP DEPT.
DATE 12-19-84
PAGE 6-117
BY T. McNair
VOID
9-11-85
874.70
610.02
436.85
817.19
0.33 A.
613.13
159.68
176.83
246.70
364.56
255.53
141.02
380
81.08
61.25
40.55