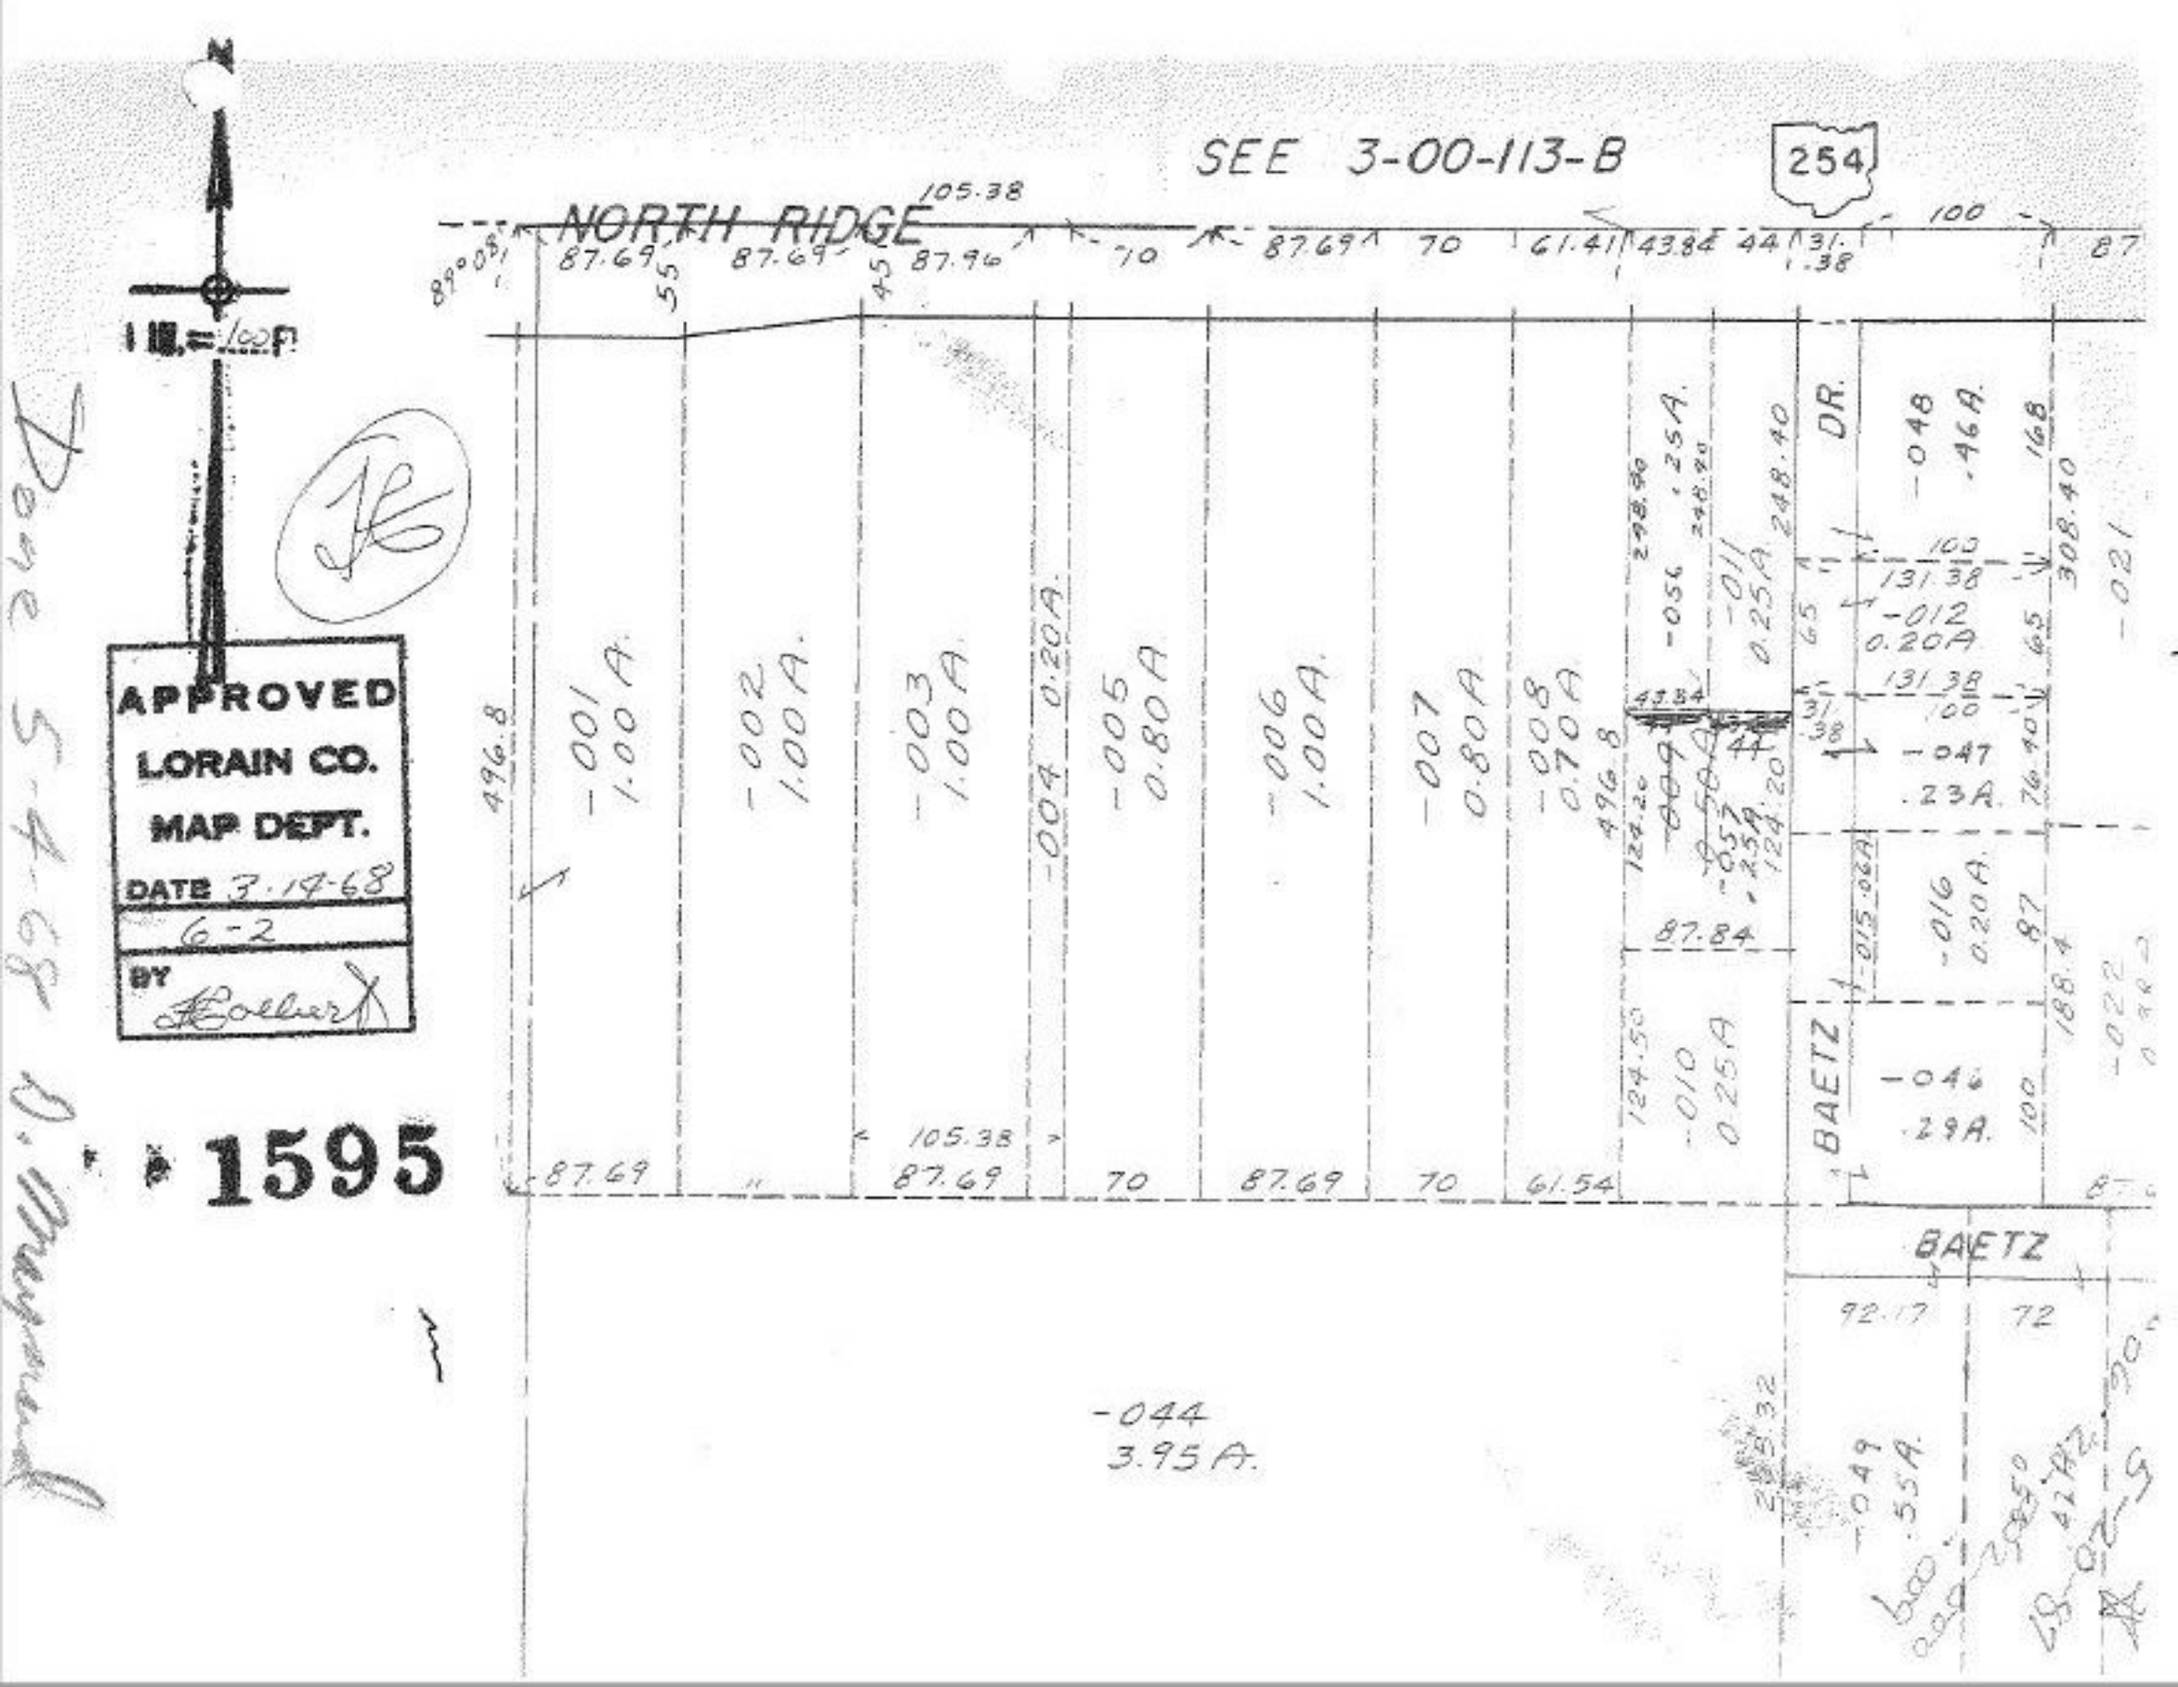
SEE 3-00-113-B
254
NORTH RIDGE
105.38
87.69
87.69
87.96
70
87.69
70
61.41
43.84
44
31.38
100
87
496.8
-001 1.00 A.
-002 1.00A.
-003 1.00A.
-004 0.20A.
-005 0.80A
-006 1.00A.
-007 0.80A.
-008 0.70A
-056 1.25A.
-011 0.25A
-012 0.20A
-048 .46A.
-047 .23A.
-016 0.20A.
-046 .29A.
-010 0.25A
-044 3.95A.
-049 .55A.
DR.
BAETZ
BAETZ
APPROVED
LORAIN CO.
MAP DEPT.
DATE 3-14-68
6-2
BY
1595