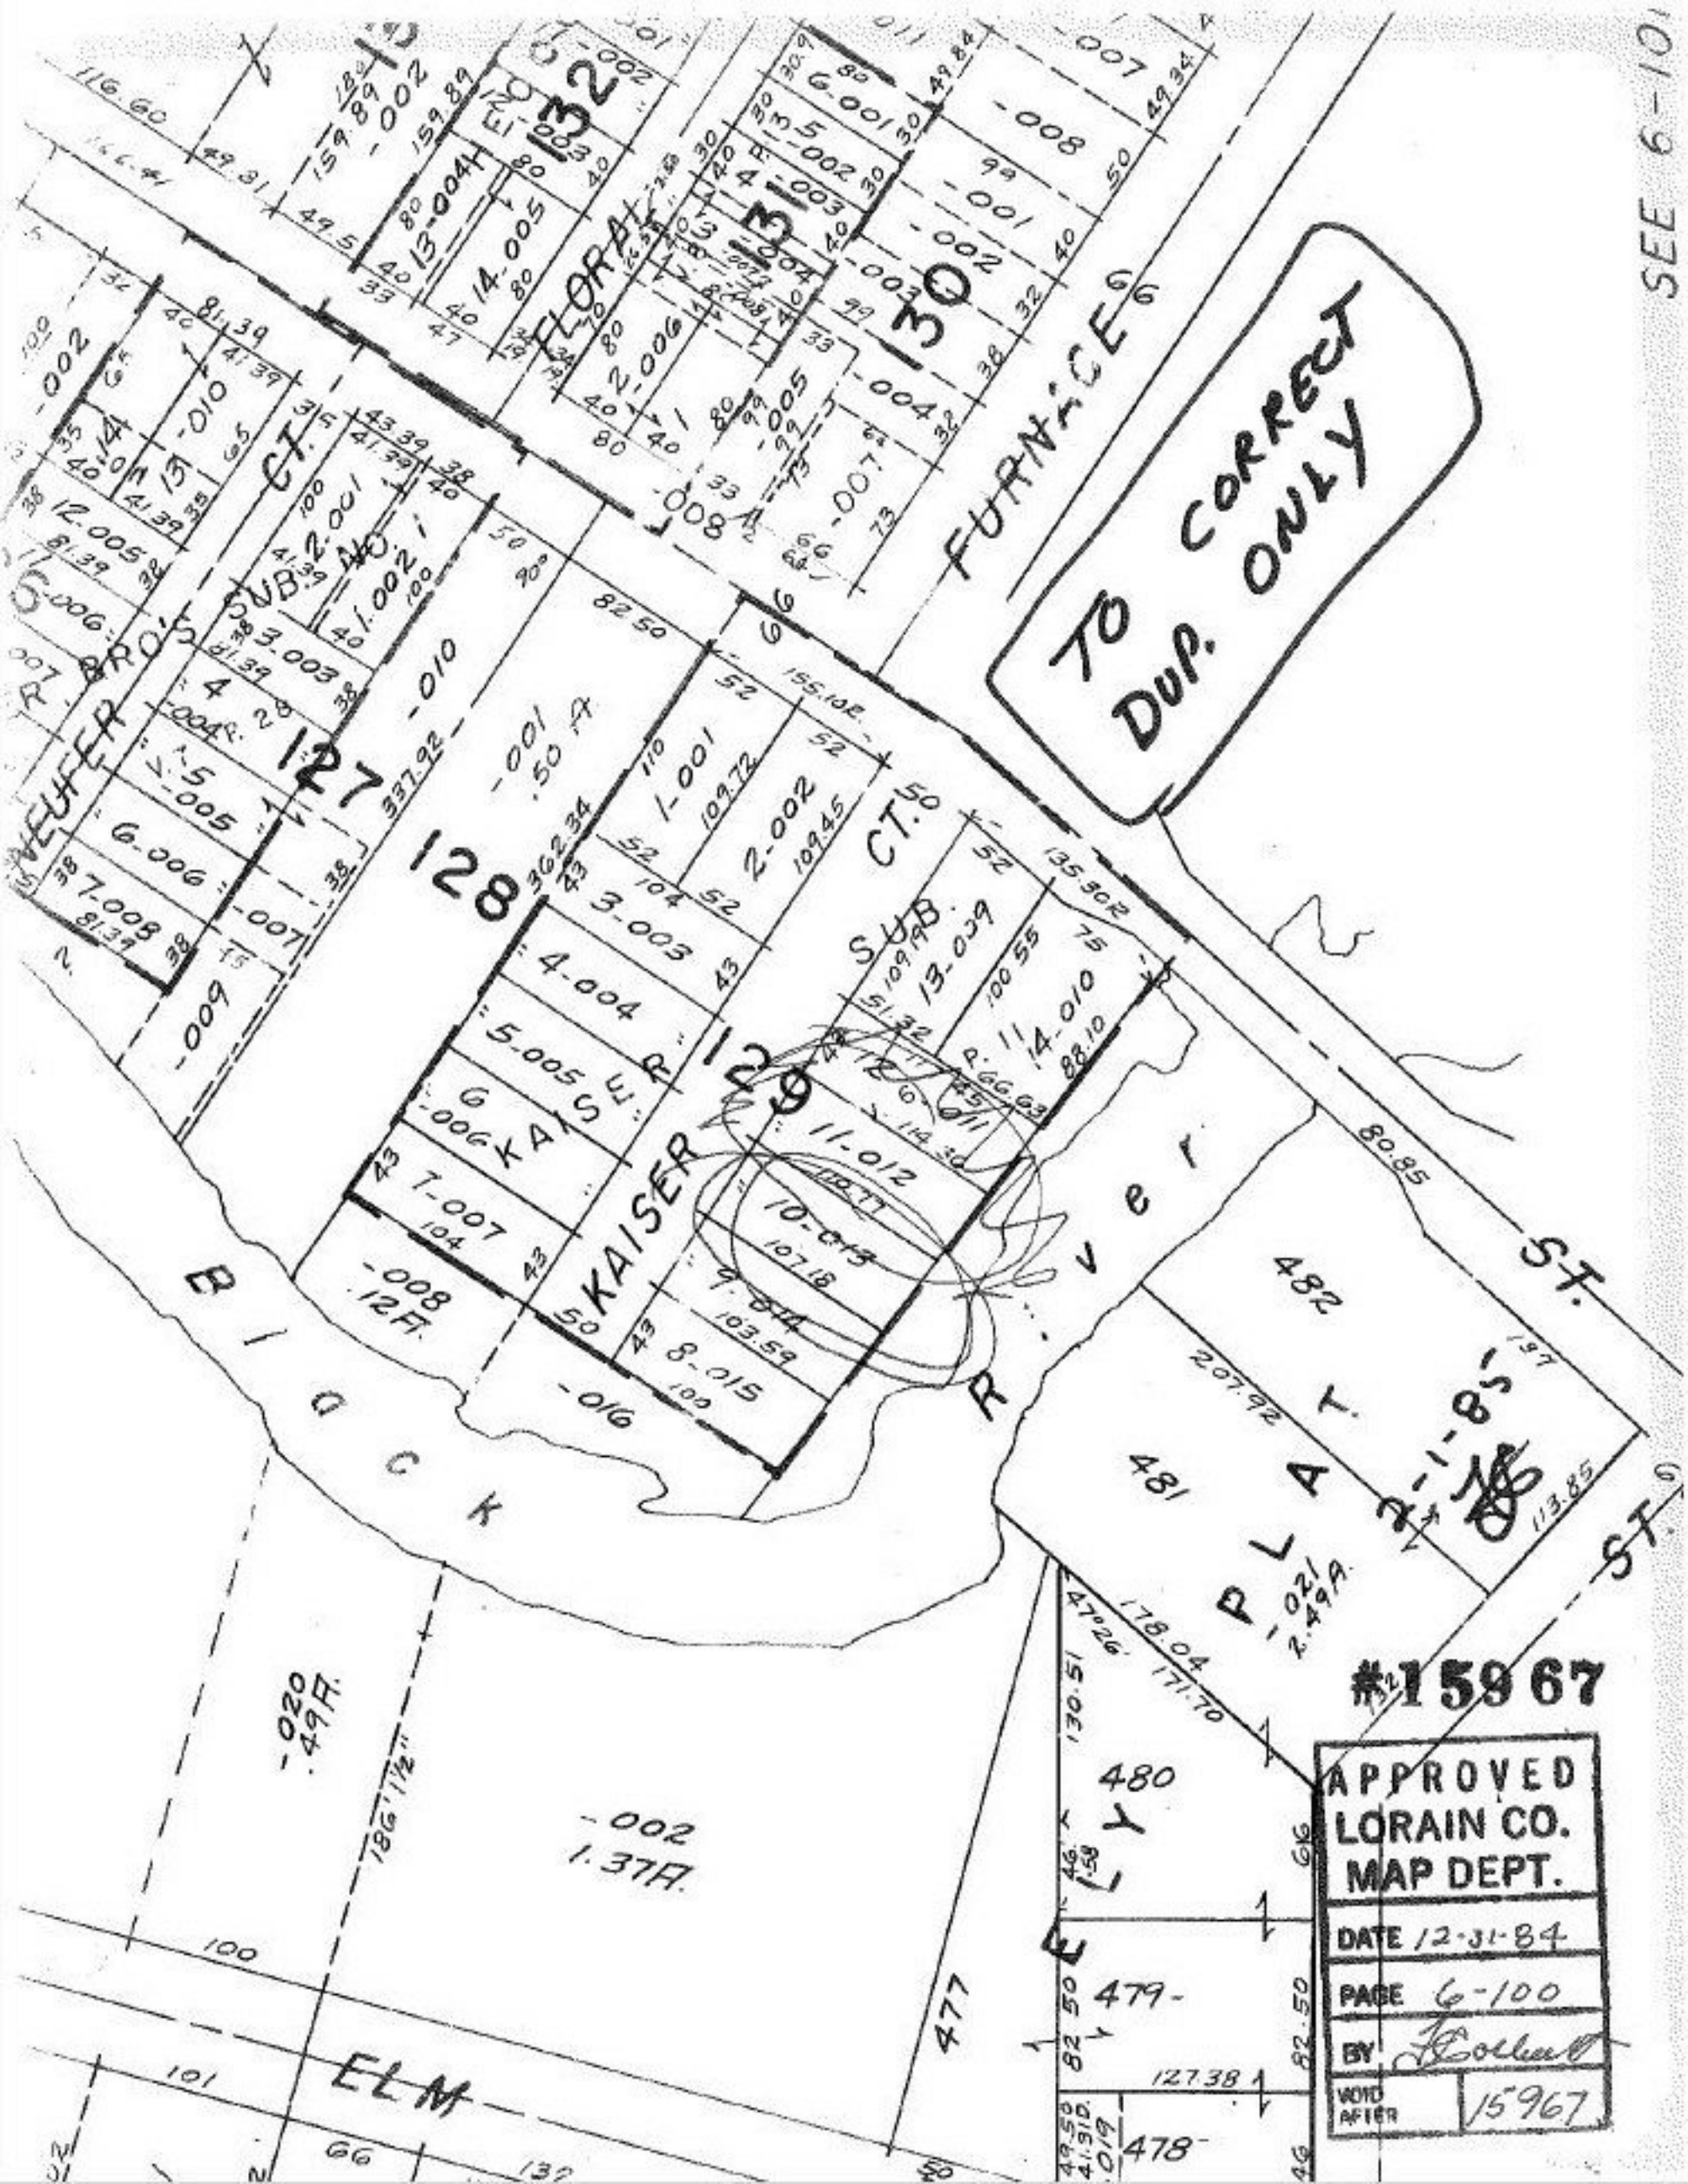

TO CORRECT DUP. ONLY
SEE 6-101
FURNACE
FLORAL
NEUFER BROS SUB. NO. 2
KAISER
KAISER SUB.
Black River
ELY PLAT
ELM
ST.
#15967
APPROVED
LORAIN CO.
MAP DEPT.
DATE 12-31-84
PAGE 6-100
BY
VOID AFTER 15967