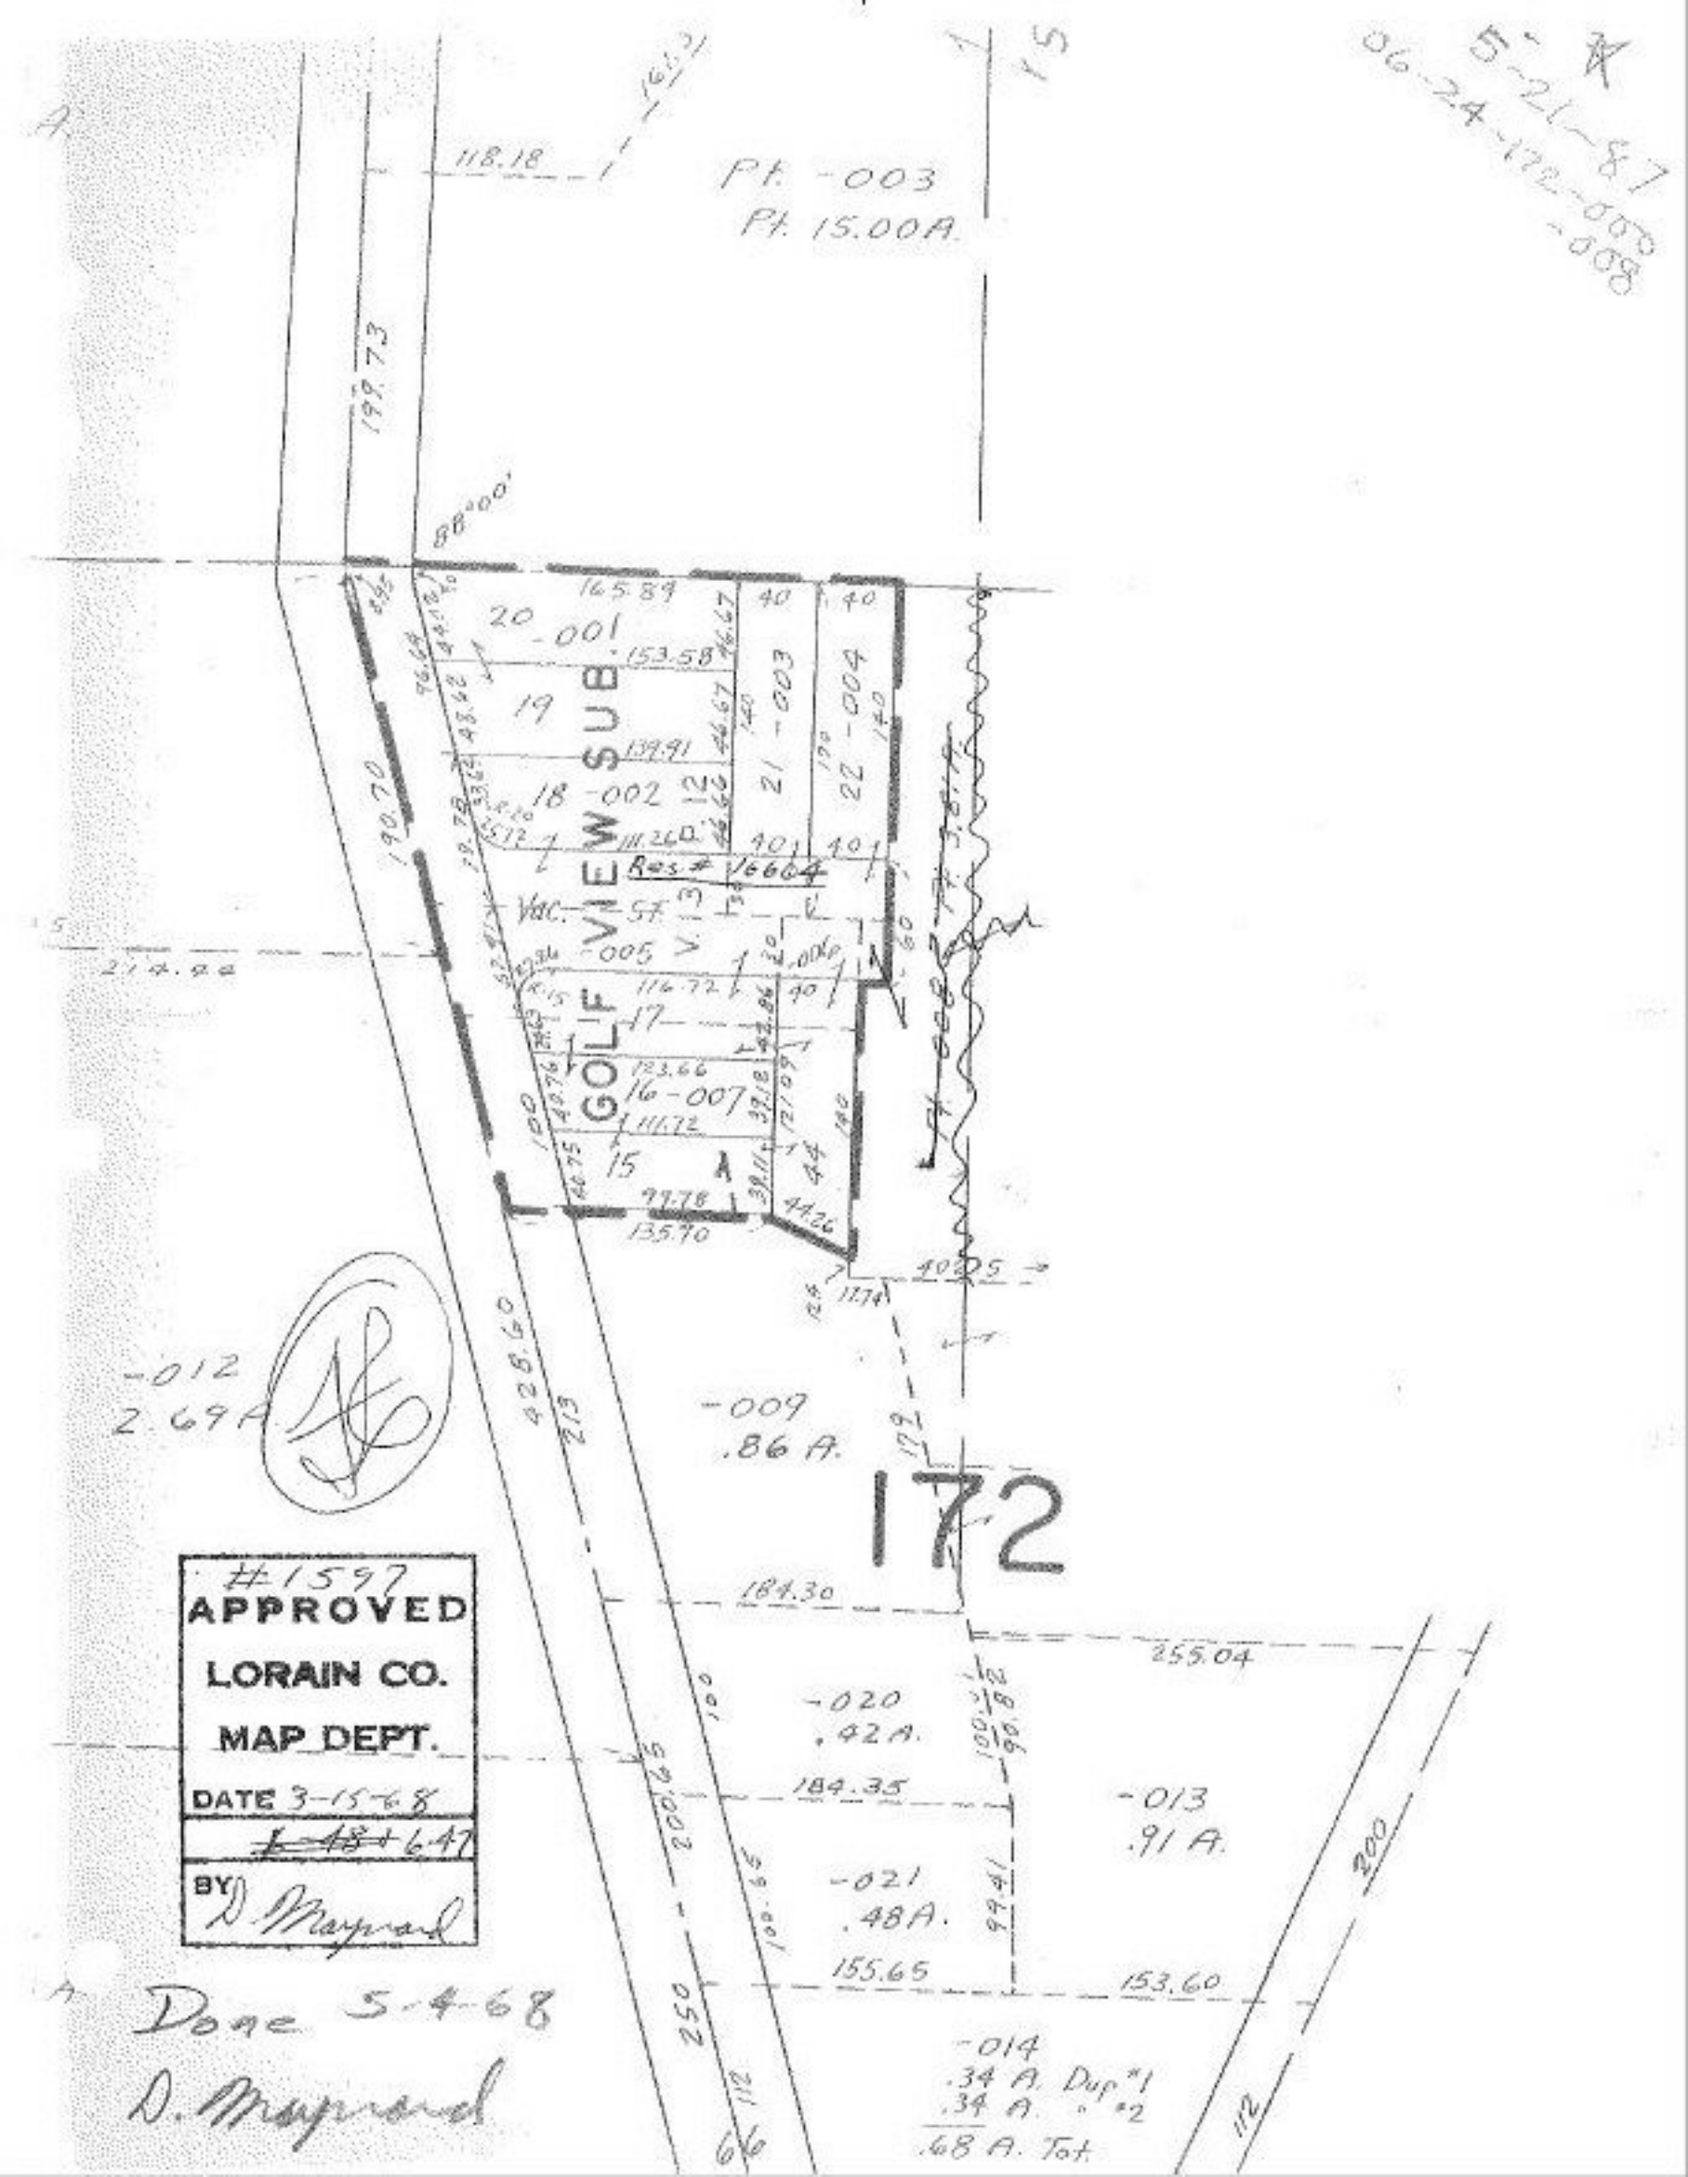
5-21-87
06-24-172-005
-008
Pt. -003
Pt. 15.00A.
118.18
199.73
88°00'
GOLF VIEW SUB.
20 -001
19
18 -002
21 -003
22 -004
Res # 16664
Vac. -005
17
16 -007
15 A
-012
2.69A
-009
.86 A.
172
#1597
APPROVED
LORAIN CO.
MAP DEPT.
DATE 3-15-68
BY D. Maynard
-020
.42A.
-021
.48A.
-013
.91 A.
-014
.34 A. Dup #1
.34 A. " #2
.68 A. Tot
Done 5-4-68
D. Maynard