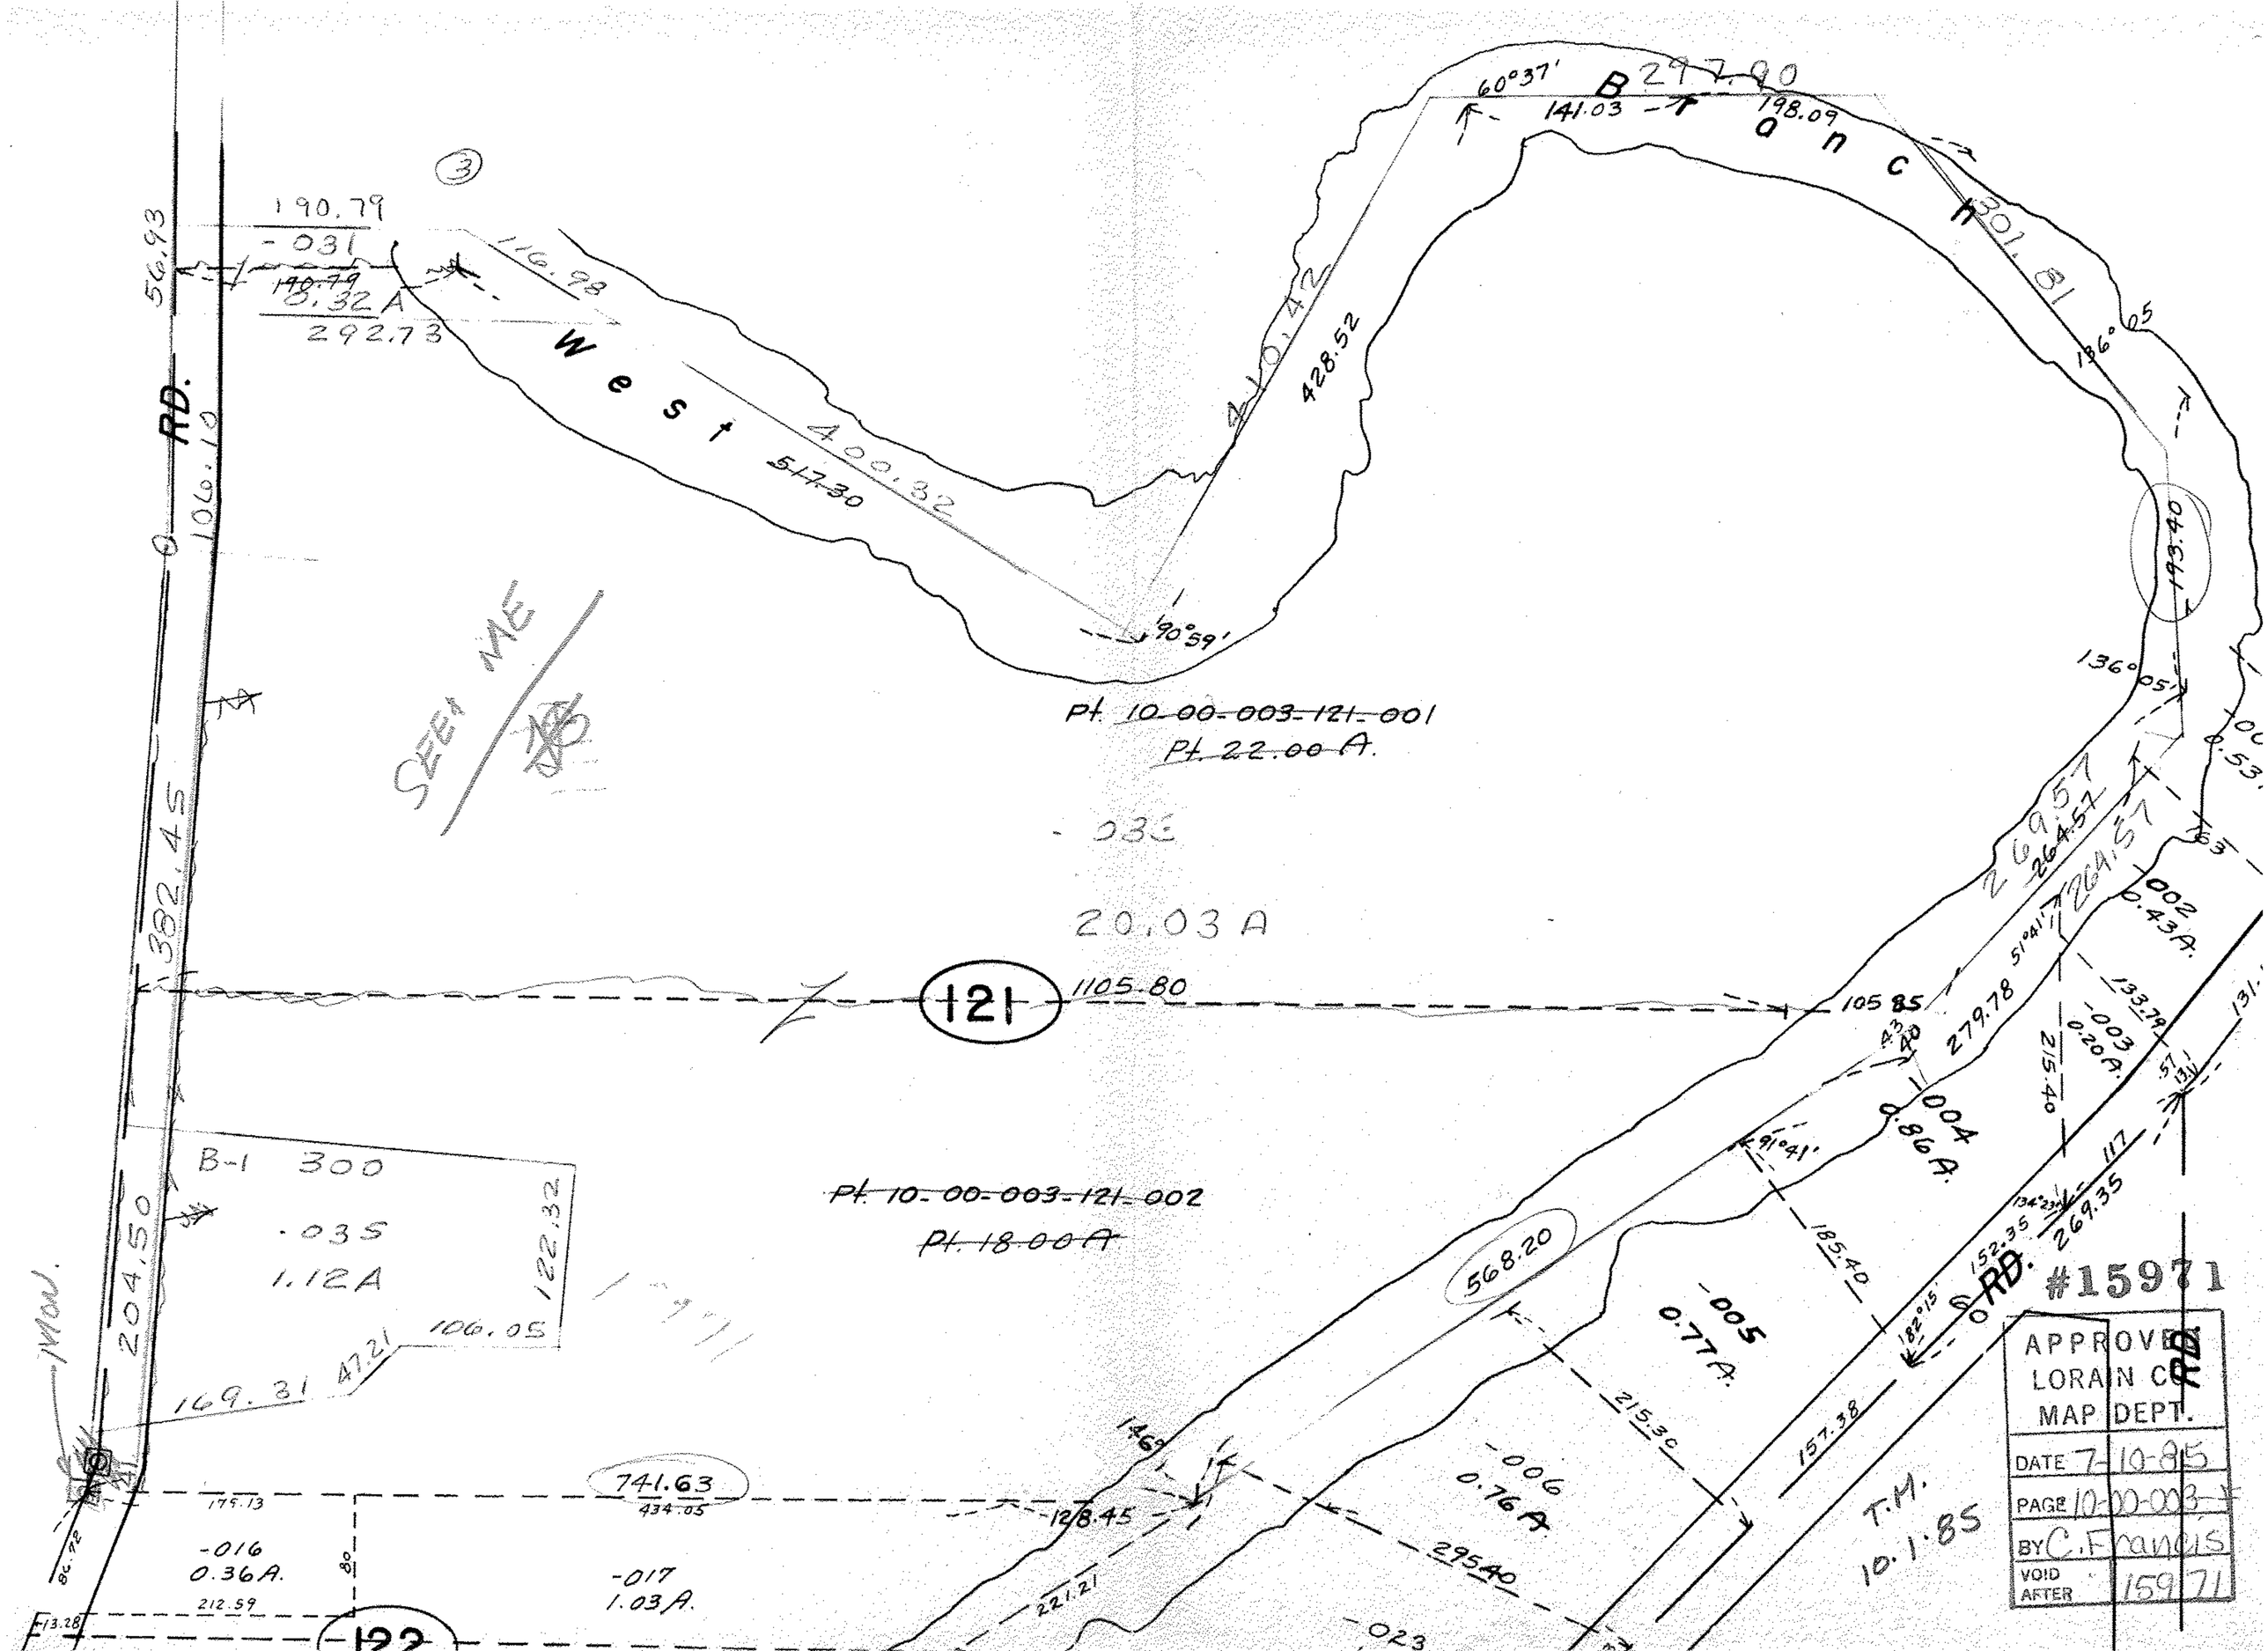

West
Branch
RD.
121
122
Pt. 10-00-003-121-001
Pt. 22.00 A.
Pt. 10-00-003-121-002
Pt. 18.00 A
20.03 A
SEE ME
B-1 300
.035
1.12A
-016
0.36A.
-017
1.03A.
-005
0.77A.
-006
0.76A.
-004
0.86A.
-003
0.20A.
-002
0.43A.
-023
T.M.
10.1.85
#15971
APPROVED
LORAIN CO
MAP DEPT.
DATE 7-10-85
PAGE 10-00-003-
BY C. Francis
VOID AFTER 15971