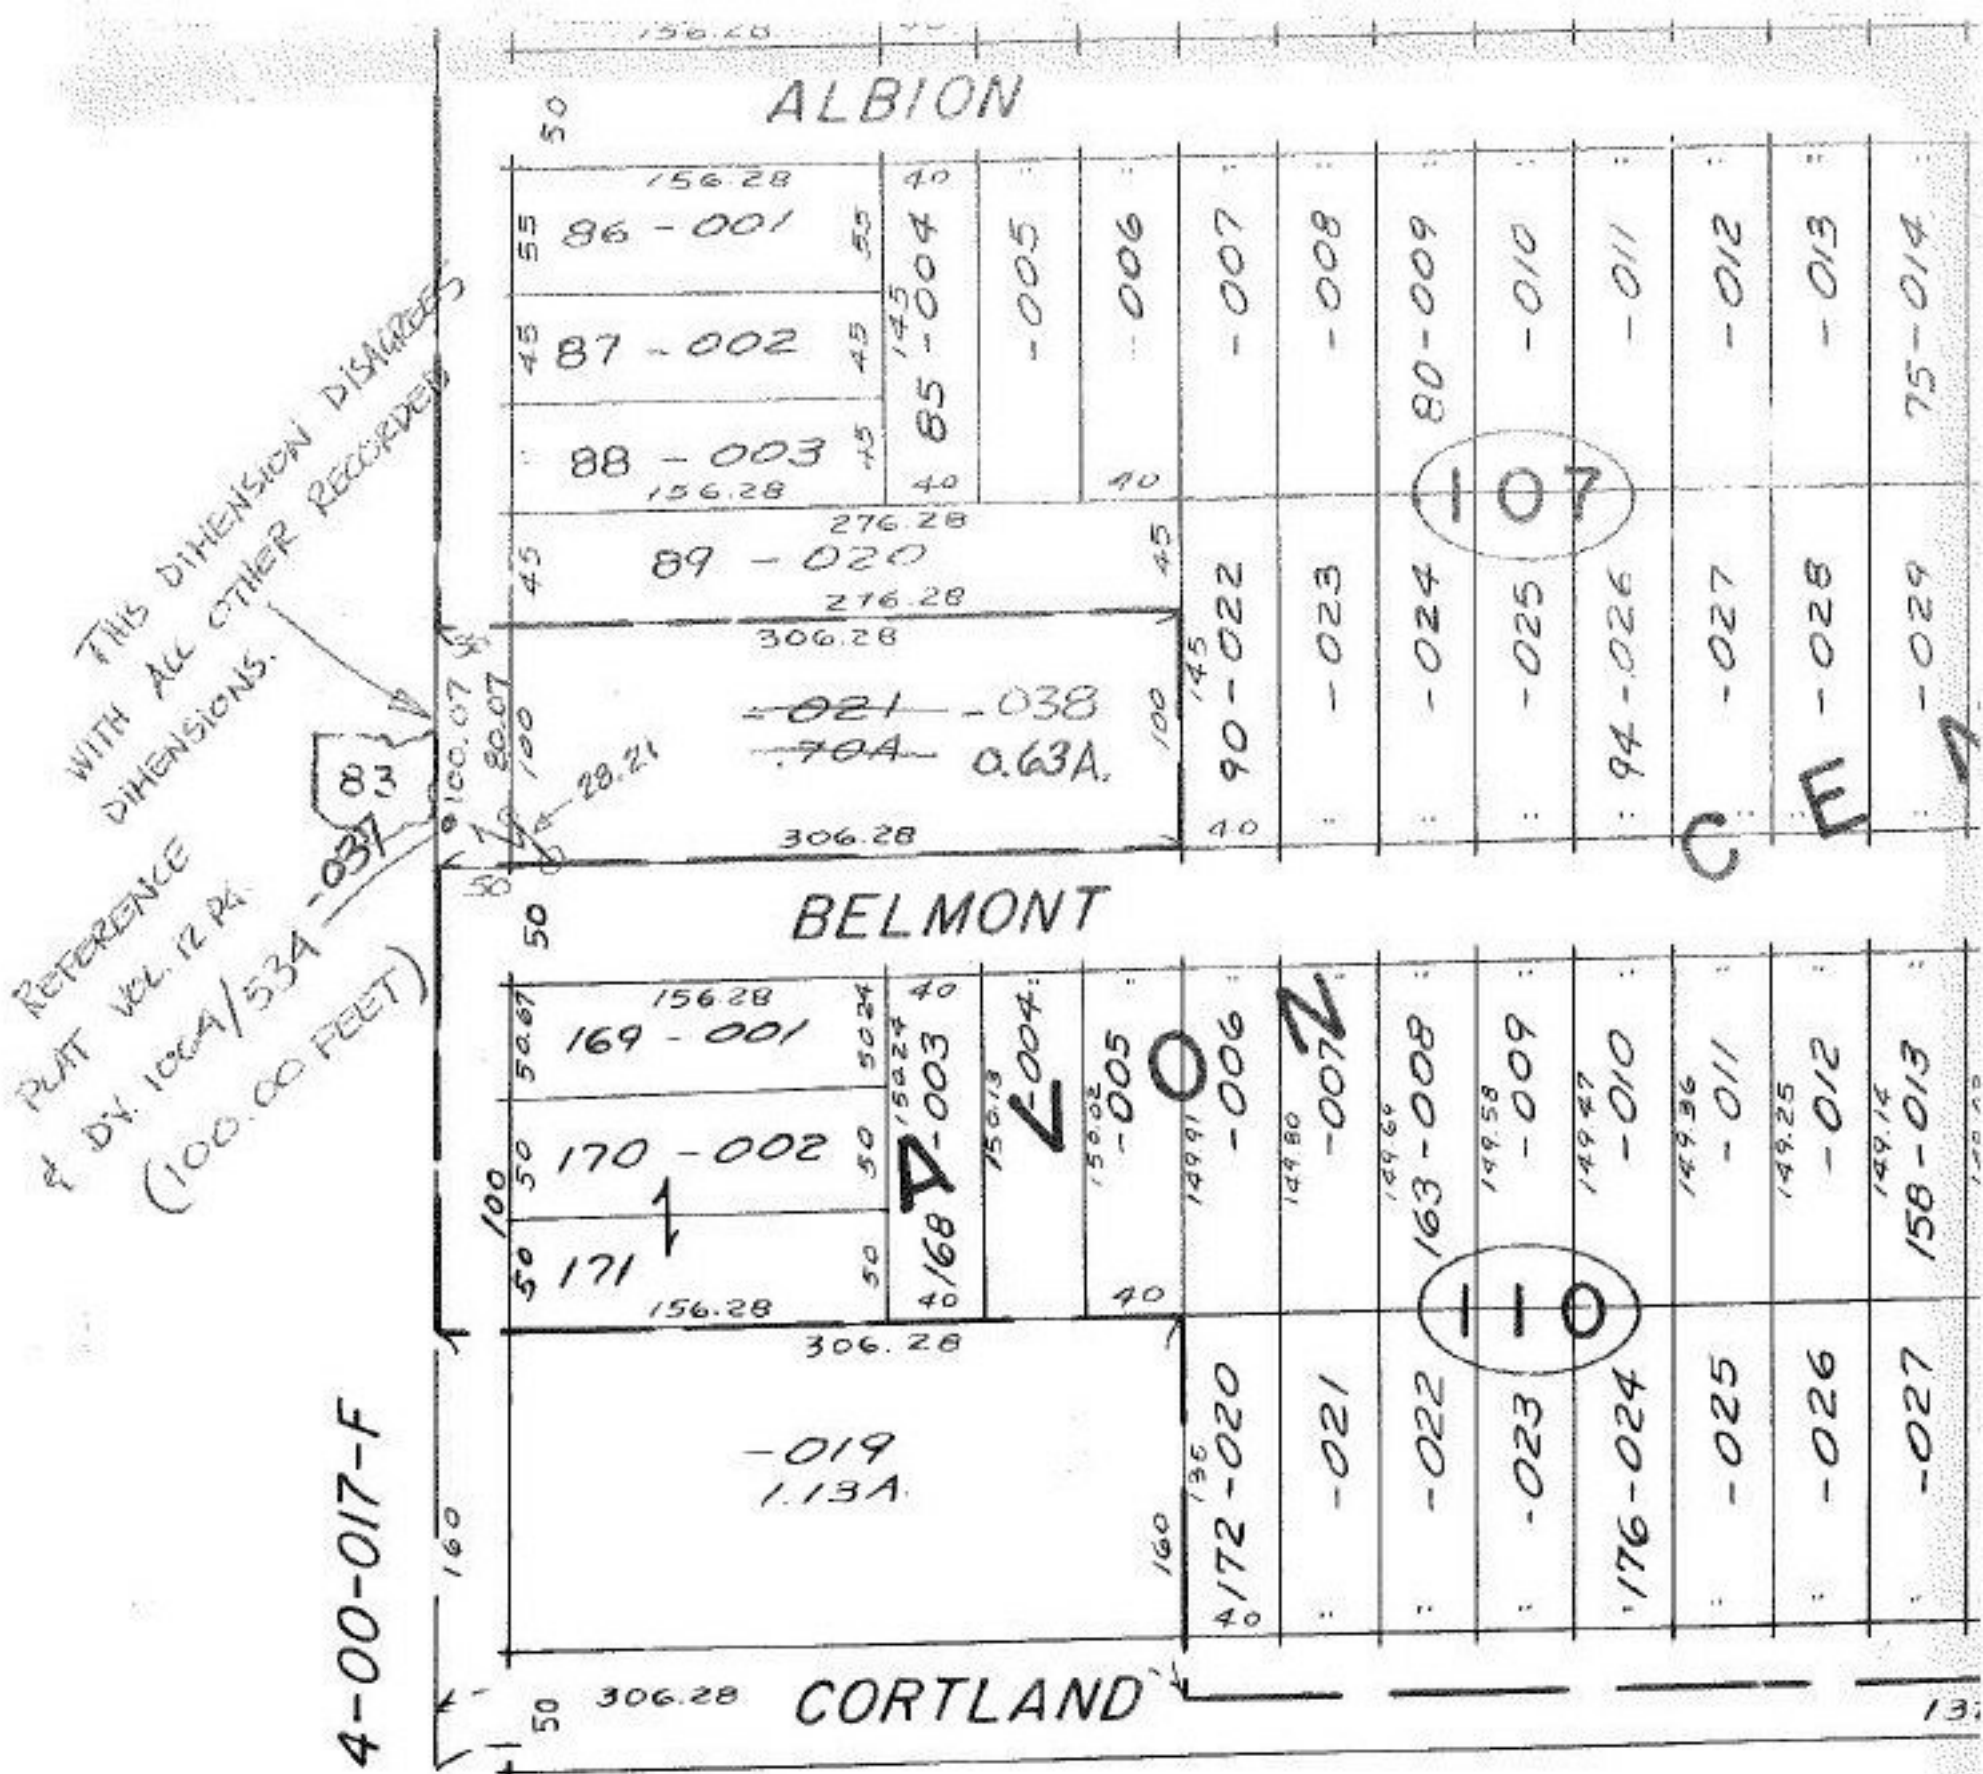
ALBION
BELMONT
CORTLAND
THIS DIMENSION DISAGREES WITH ALL OTHER RECORDED DIMENSIONS.
REFERENCE PLAT VOL. 12 PG. & DY. 1064/534 -037 (100.00 FEET)
83
86 - 001
87 - 002
88 - 003
89 - 020
~~-021~~ -038
~~.70A~~ 0.63A.
85 - 004
-005
-006
-007
-008
80 - 009
-010
-011
-012
-013
75 - 014
90 - 022
-023
-024
-025
94 - 026
-027
-028
-029
107
169 - 001
170 - 002
171
168 - 003
-004
-005
-006
-007
163 - 008
-009
-010
-011
-012
158 - 013
-019
1.13A.
172 - 020
-021
-022
-023
176 - 024
-025
-026
-027
110
SEE 4-00-017-F
RICHLAND ENG.
0.003111
-0.002997
288.35
0.073506 Ac.
1/66,666
#15979
APPROVED
LORAIN CO.
MAP DEPT.
DATE 1-4-85
PAGE 4-00-017-G
BY T. McNair
VOID
T. H. 3/20/85