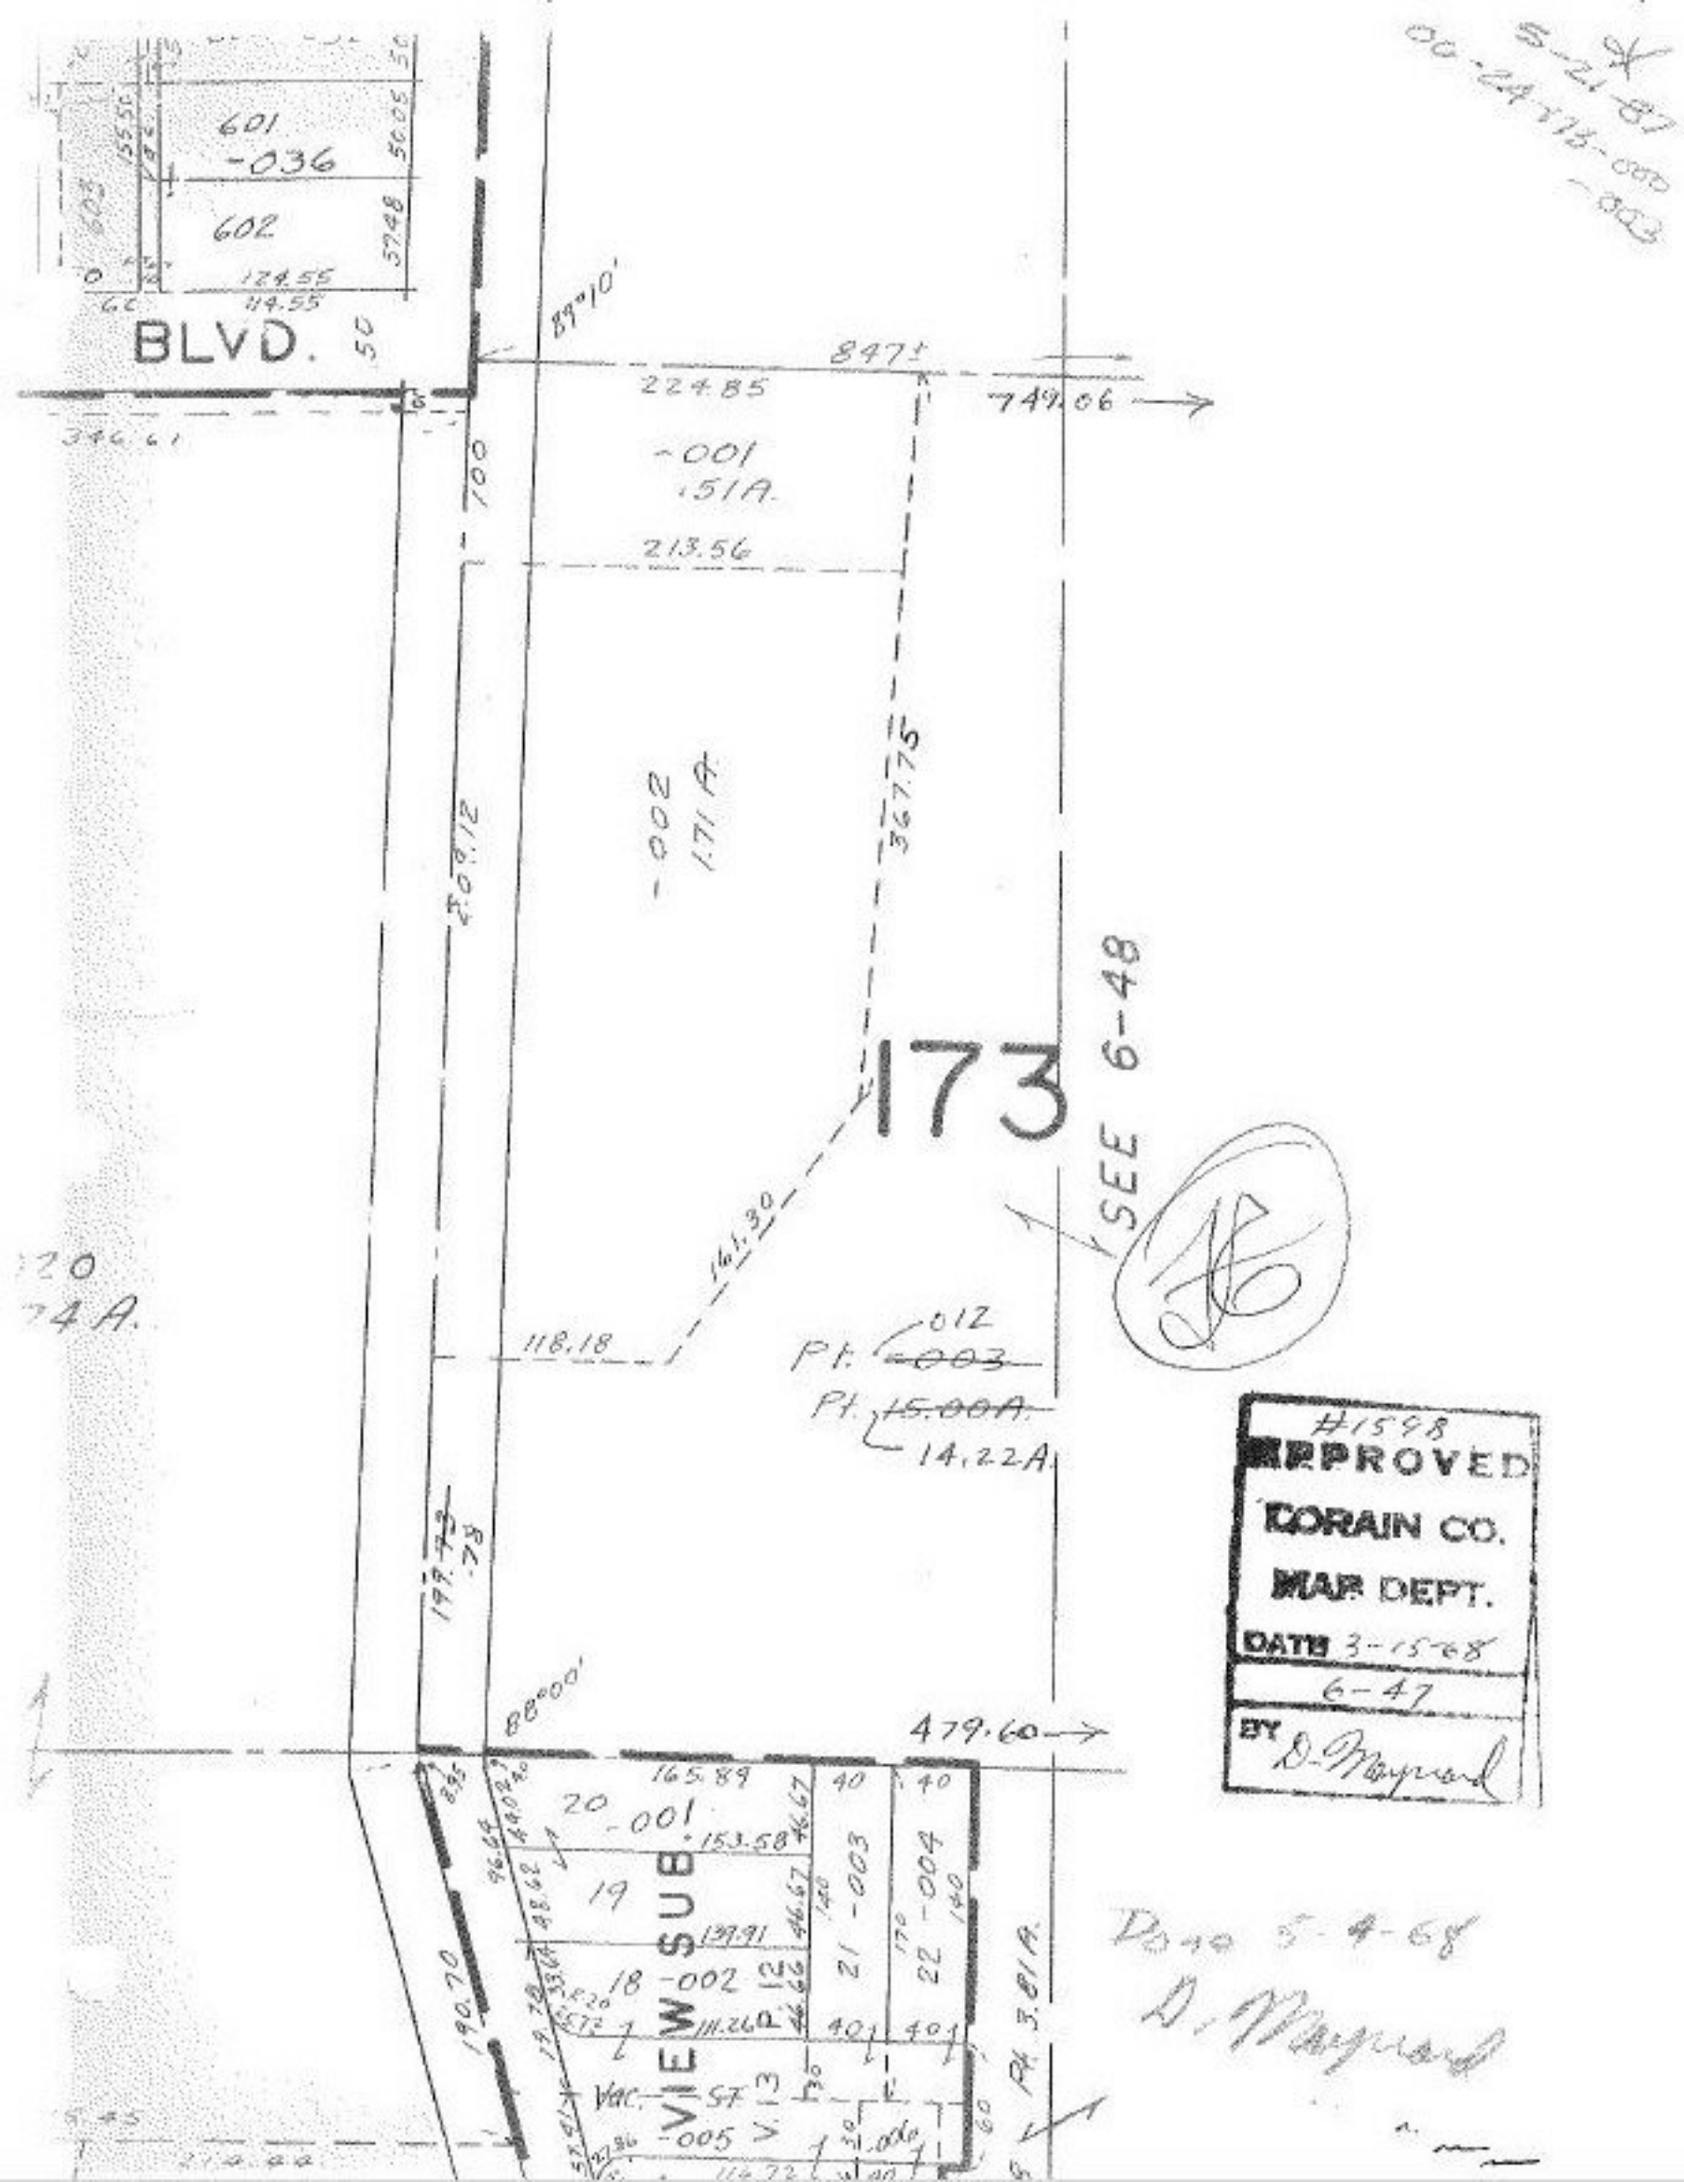

5-21-87
00-24-173-000
-003
601
-036
602
124.55
114.55
BLVD.
50
89°10'
847±
224.85
749.06
346.61
-001
.51A.
213.56
-002
1.71 A.
367.75
173
SEE 6-48
161.30
118.18
Pt. -012
Pt. 15.00A.
14.22A.
#1598
APPROVED
LORAIN CO.
MAP DEPT.
DATE 3-15-68
6-47
BY D. Maynard
88°00'
479.60
165.89
20
-001
153.58
19
139.91
18
-002
111.26
21
-003
22
-004
VIEW SUB
Vac. ST.
-005
Pt. 3.81 A.
190.70
Done 5-4-68
D. Maynard