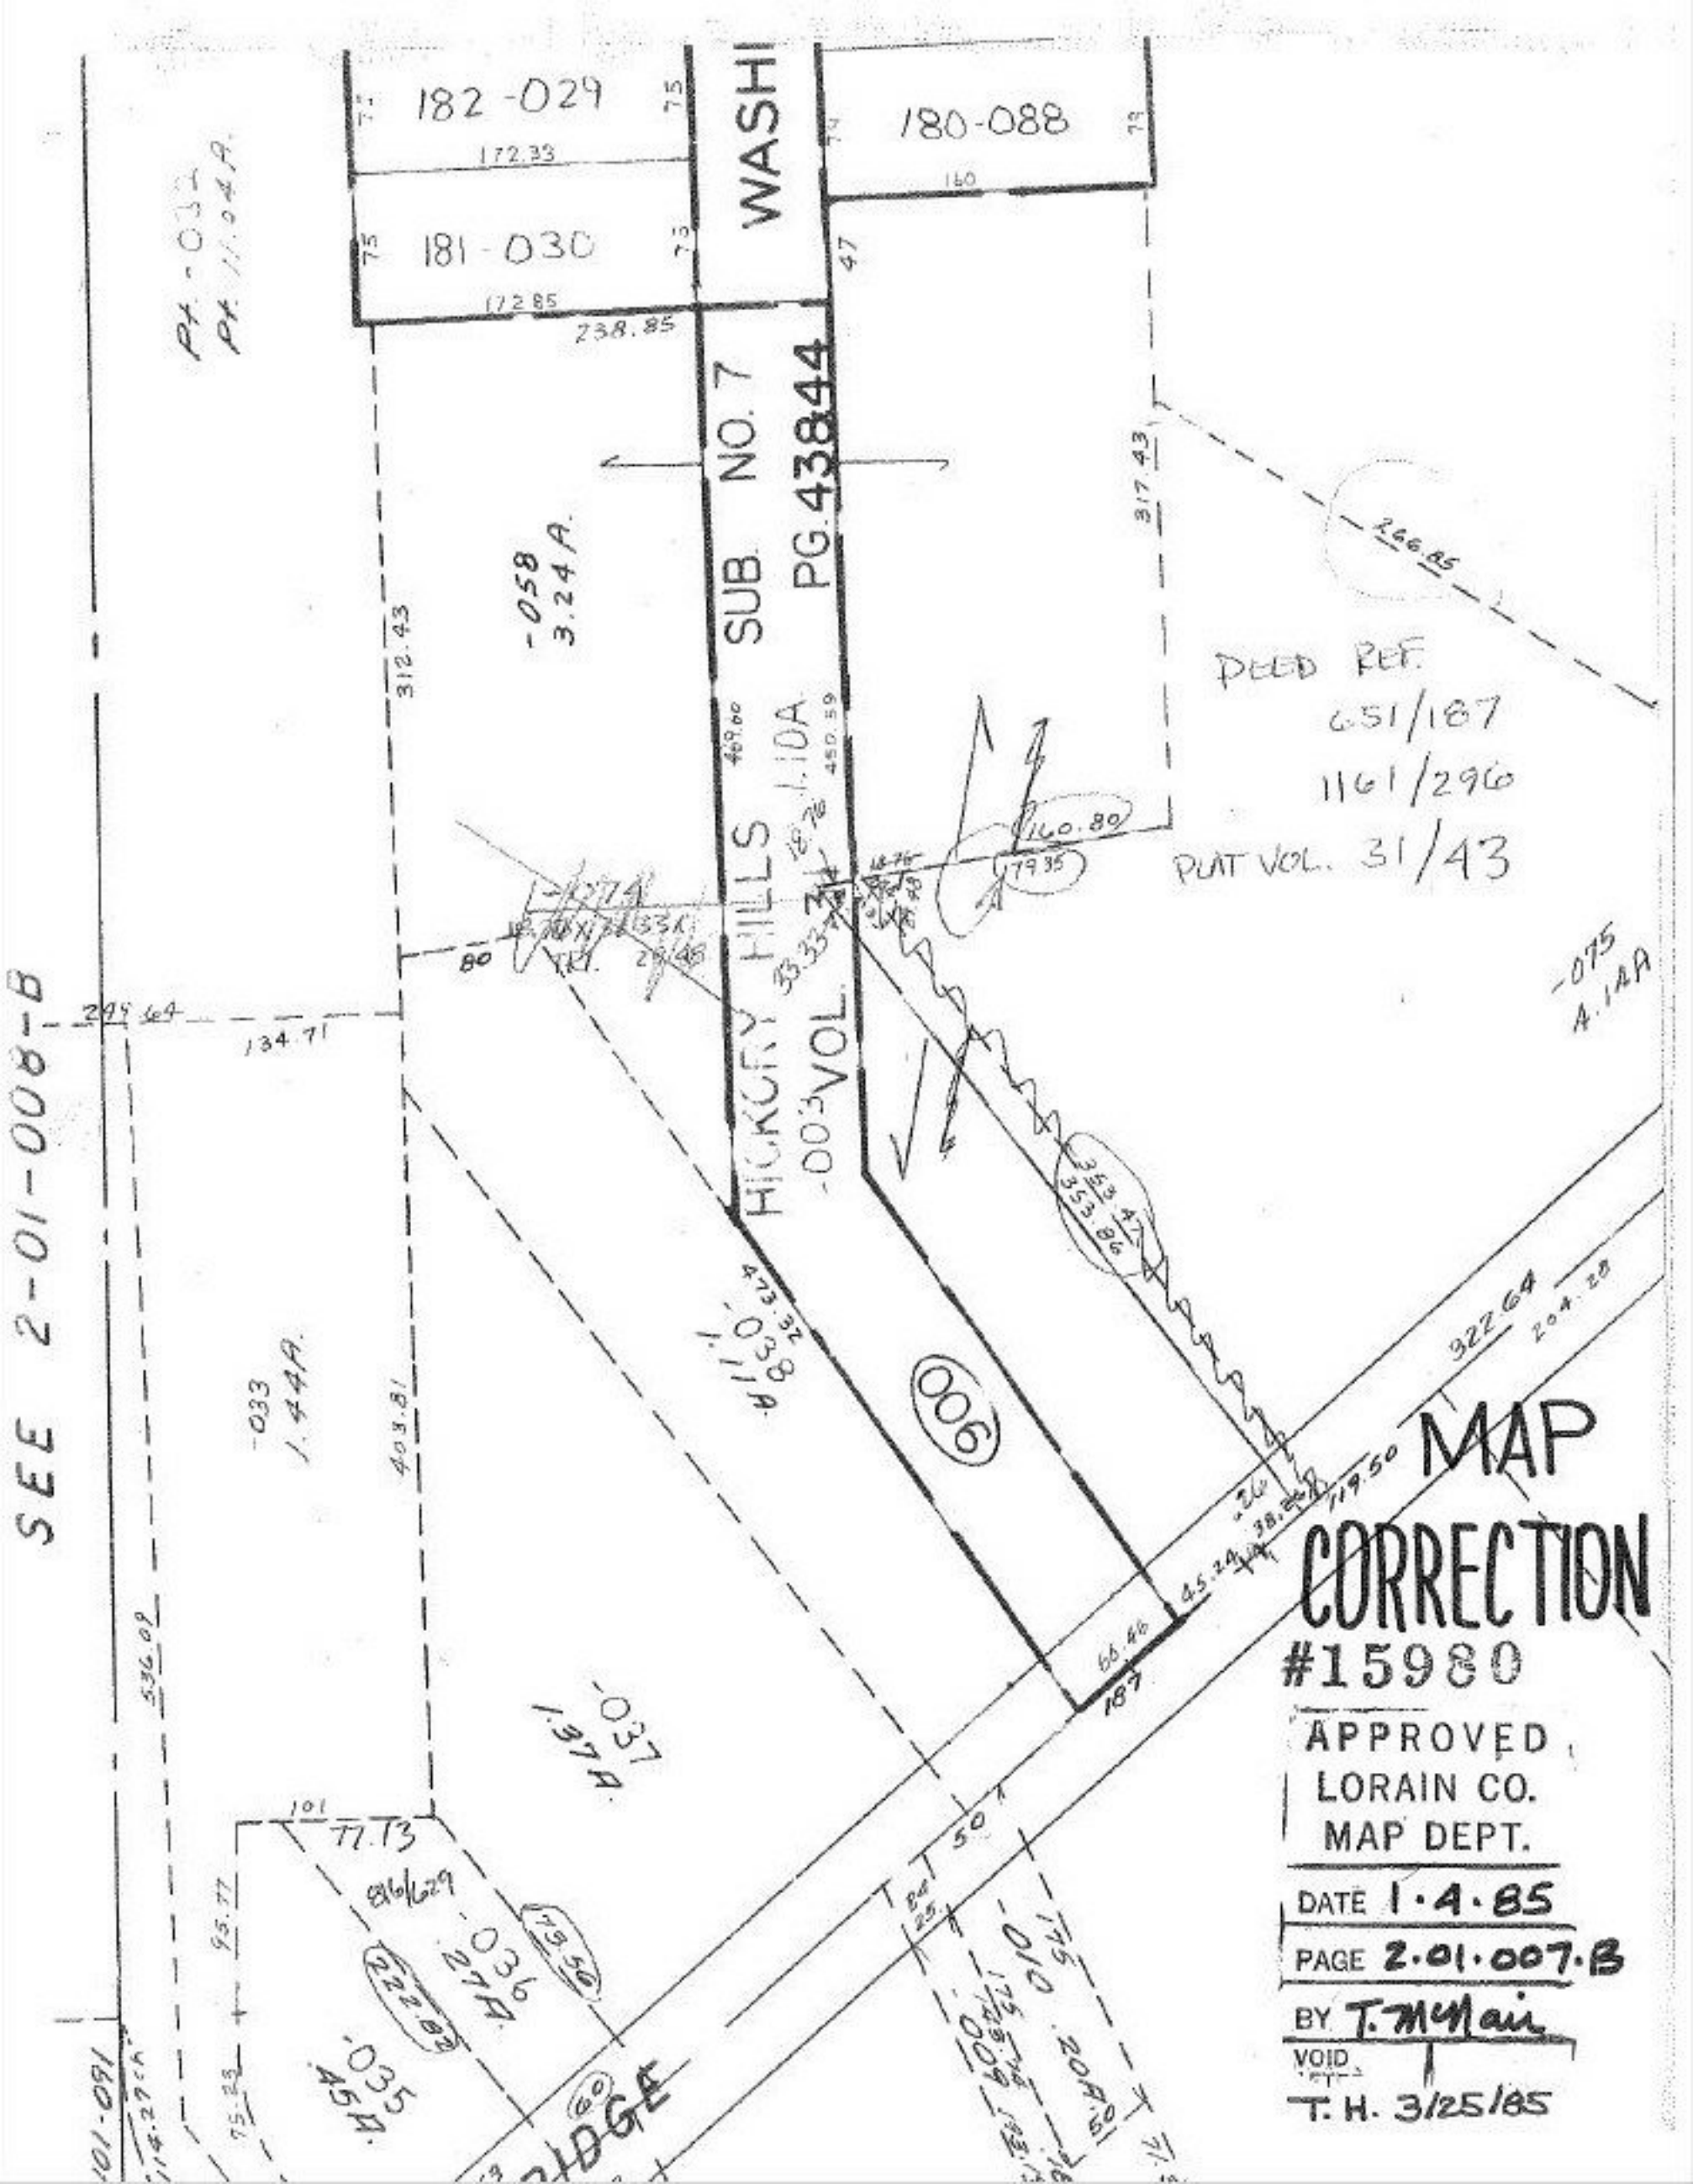

182-029
172.33
181-030
172.85
238.85
180-088
160
WASHI
SUB. NO. 7
PG. 43844
HICKORY HILLS
-003 VOL. 31
1.10A
-058
3.24A.
312.43
317.43
266.85
DEED REF.
651/187
1161/296
PLAT VOL. 31/43
160.80
179.35
-074
-075
A.14A
249.64
134.71
SEE 2-01-008-B
-033
1.44A.
403.81
-038
1.11A.
473.32
006
322.64
204.28
119.50
45.24
66.46
187
-037
1.37A.
536.09
77.13
-036
.27A.
222.82
-035
.45A.
-010
.20A.
-009
MAP
CORRECTION
#15980
APPROVED
LORAIN CO.
MAP DEPT.
DATE 1·4·85
PAGE 2.01.007.B
BY T. McNair
VOID
T. H. 3/25/85