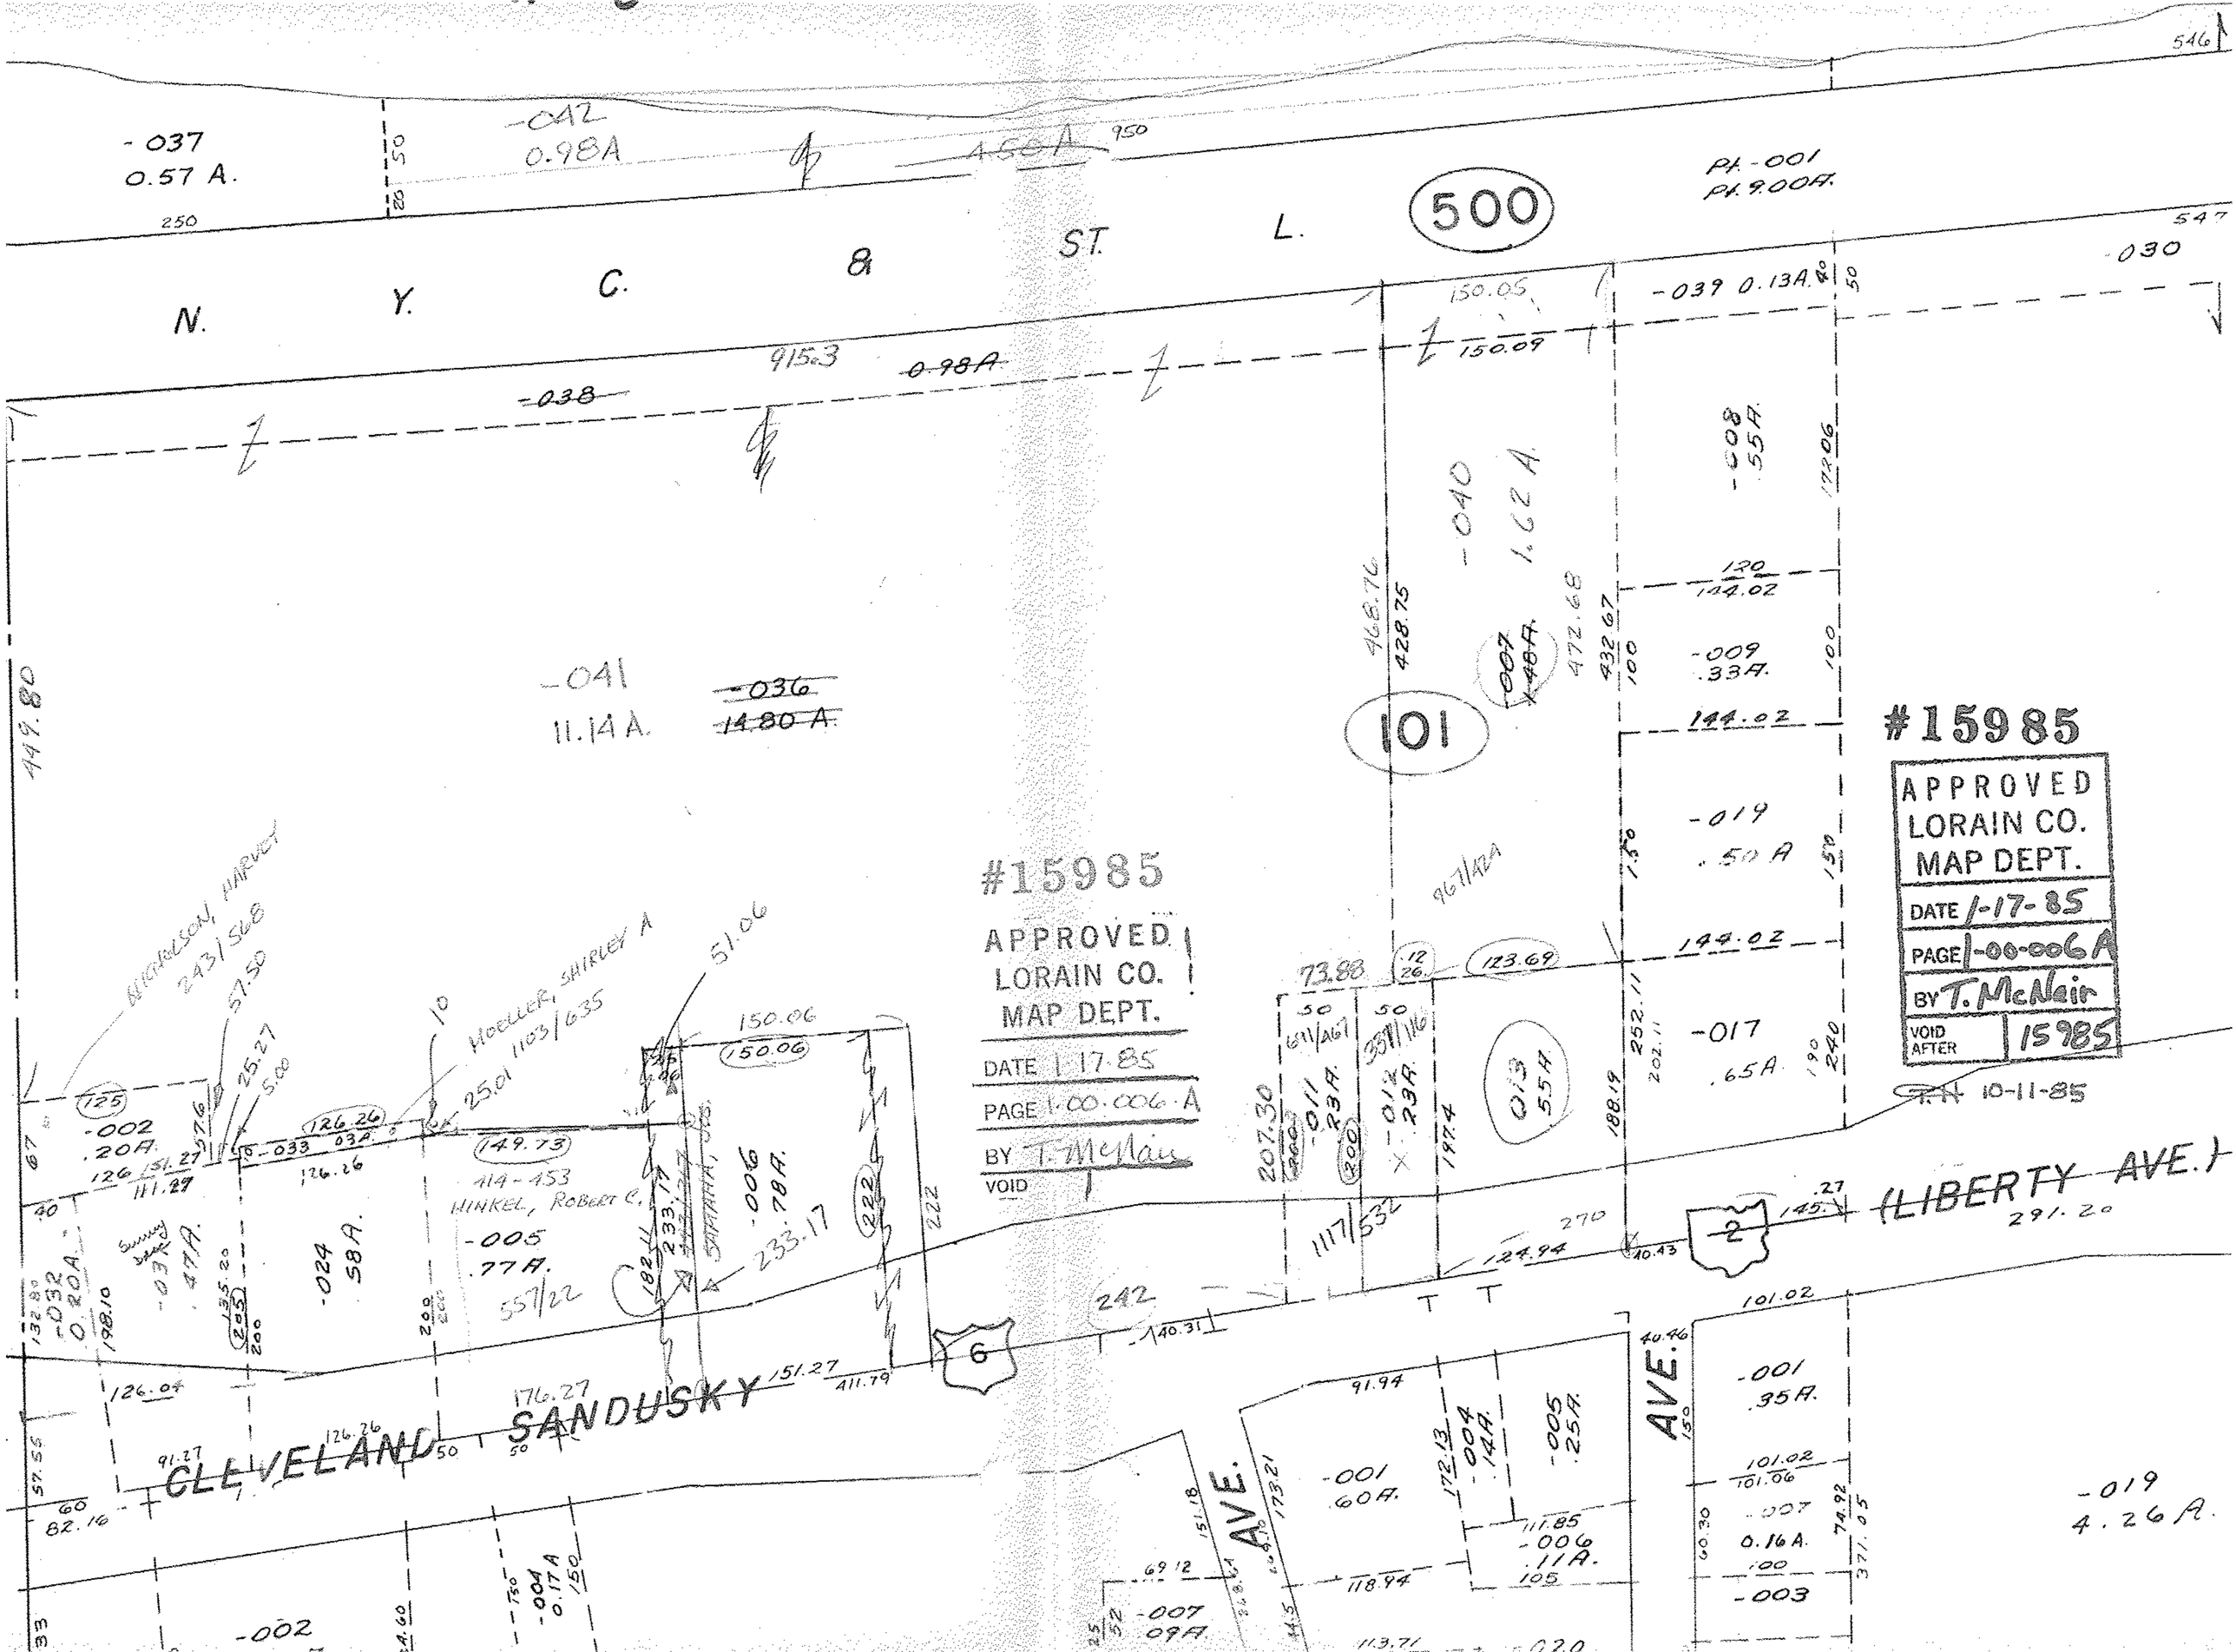

#15985
APPROVED
LORAIN CO.
MAP DEPT.
DATE 1-17-85
PAGE 1-00-006A
BY T. McNair
VOID AFTER 15985
T.N. 10-11-85

#15985
APPROVED
LORAIN CO.
MAP DEPT.
DATE 1-17-85
PAGE 1-00-006A
BY T. McNair
VOID