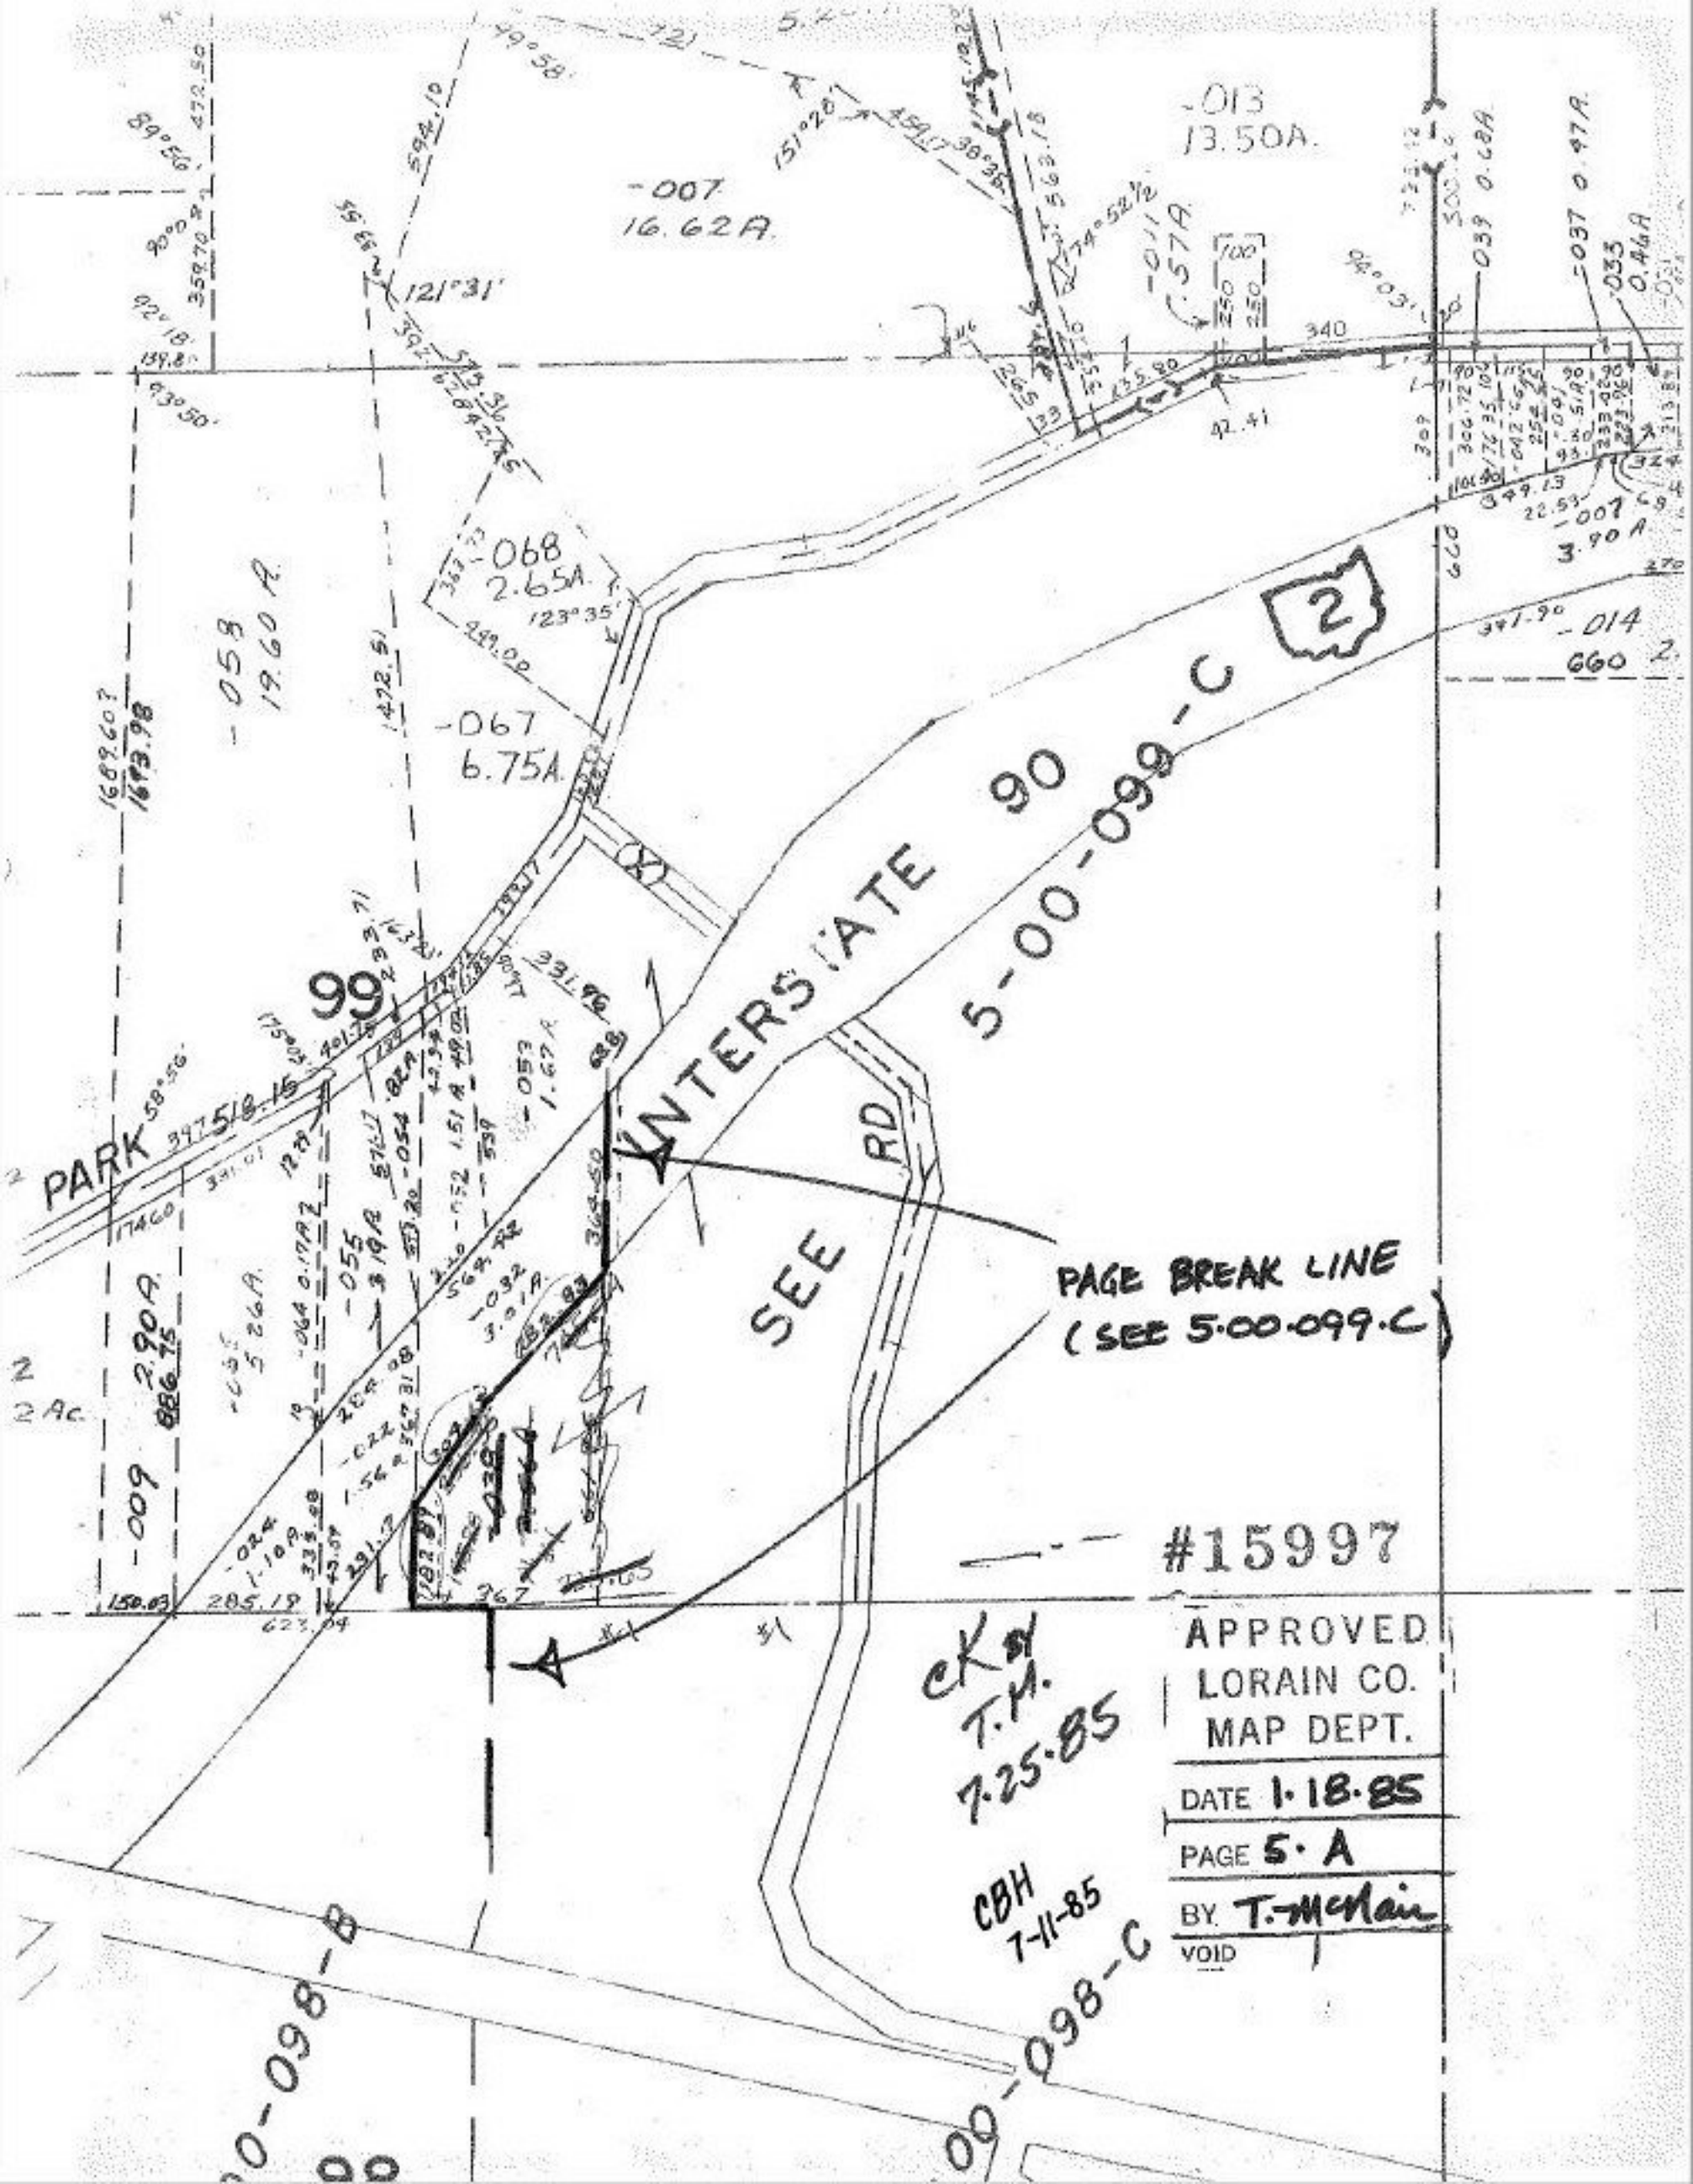

-007
16.62A.
-013
13.50A.
-068
2.65A.
-067
6.75A.
-058
19.60 A.
-014
660
-007
3.90 A.
INTERSTATE 90
5-00-099-C
2
99
PARK
SEE RD
PAGE BREAK LINE
(SEE 5.00.099.C)
#15997
APPROVED
LORAIN CO.
MAP DEPT.
DATE 1.18.85
PAGE 5.A
BY T. McNair
VOID
CK BY
T.M.
7.25.85
CBH
7-11-85
00-098-B
00-098-C