PARENT PARCEL: 09-00-095-107-006
CHILD PARCEL: 09-00-095-107-035, -036
STARTING POINT: INTERSECTION OF C/L OF LINCOLN ST. AND C/L OF S.PROFESSOR ST.

16-00751

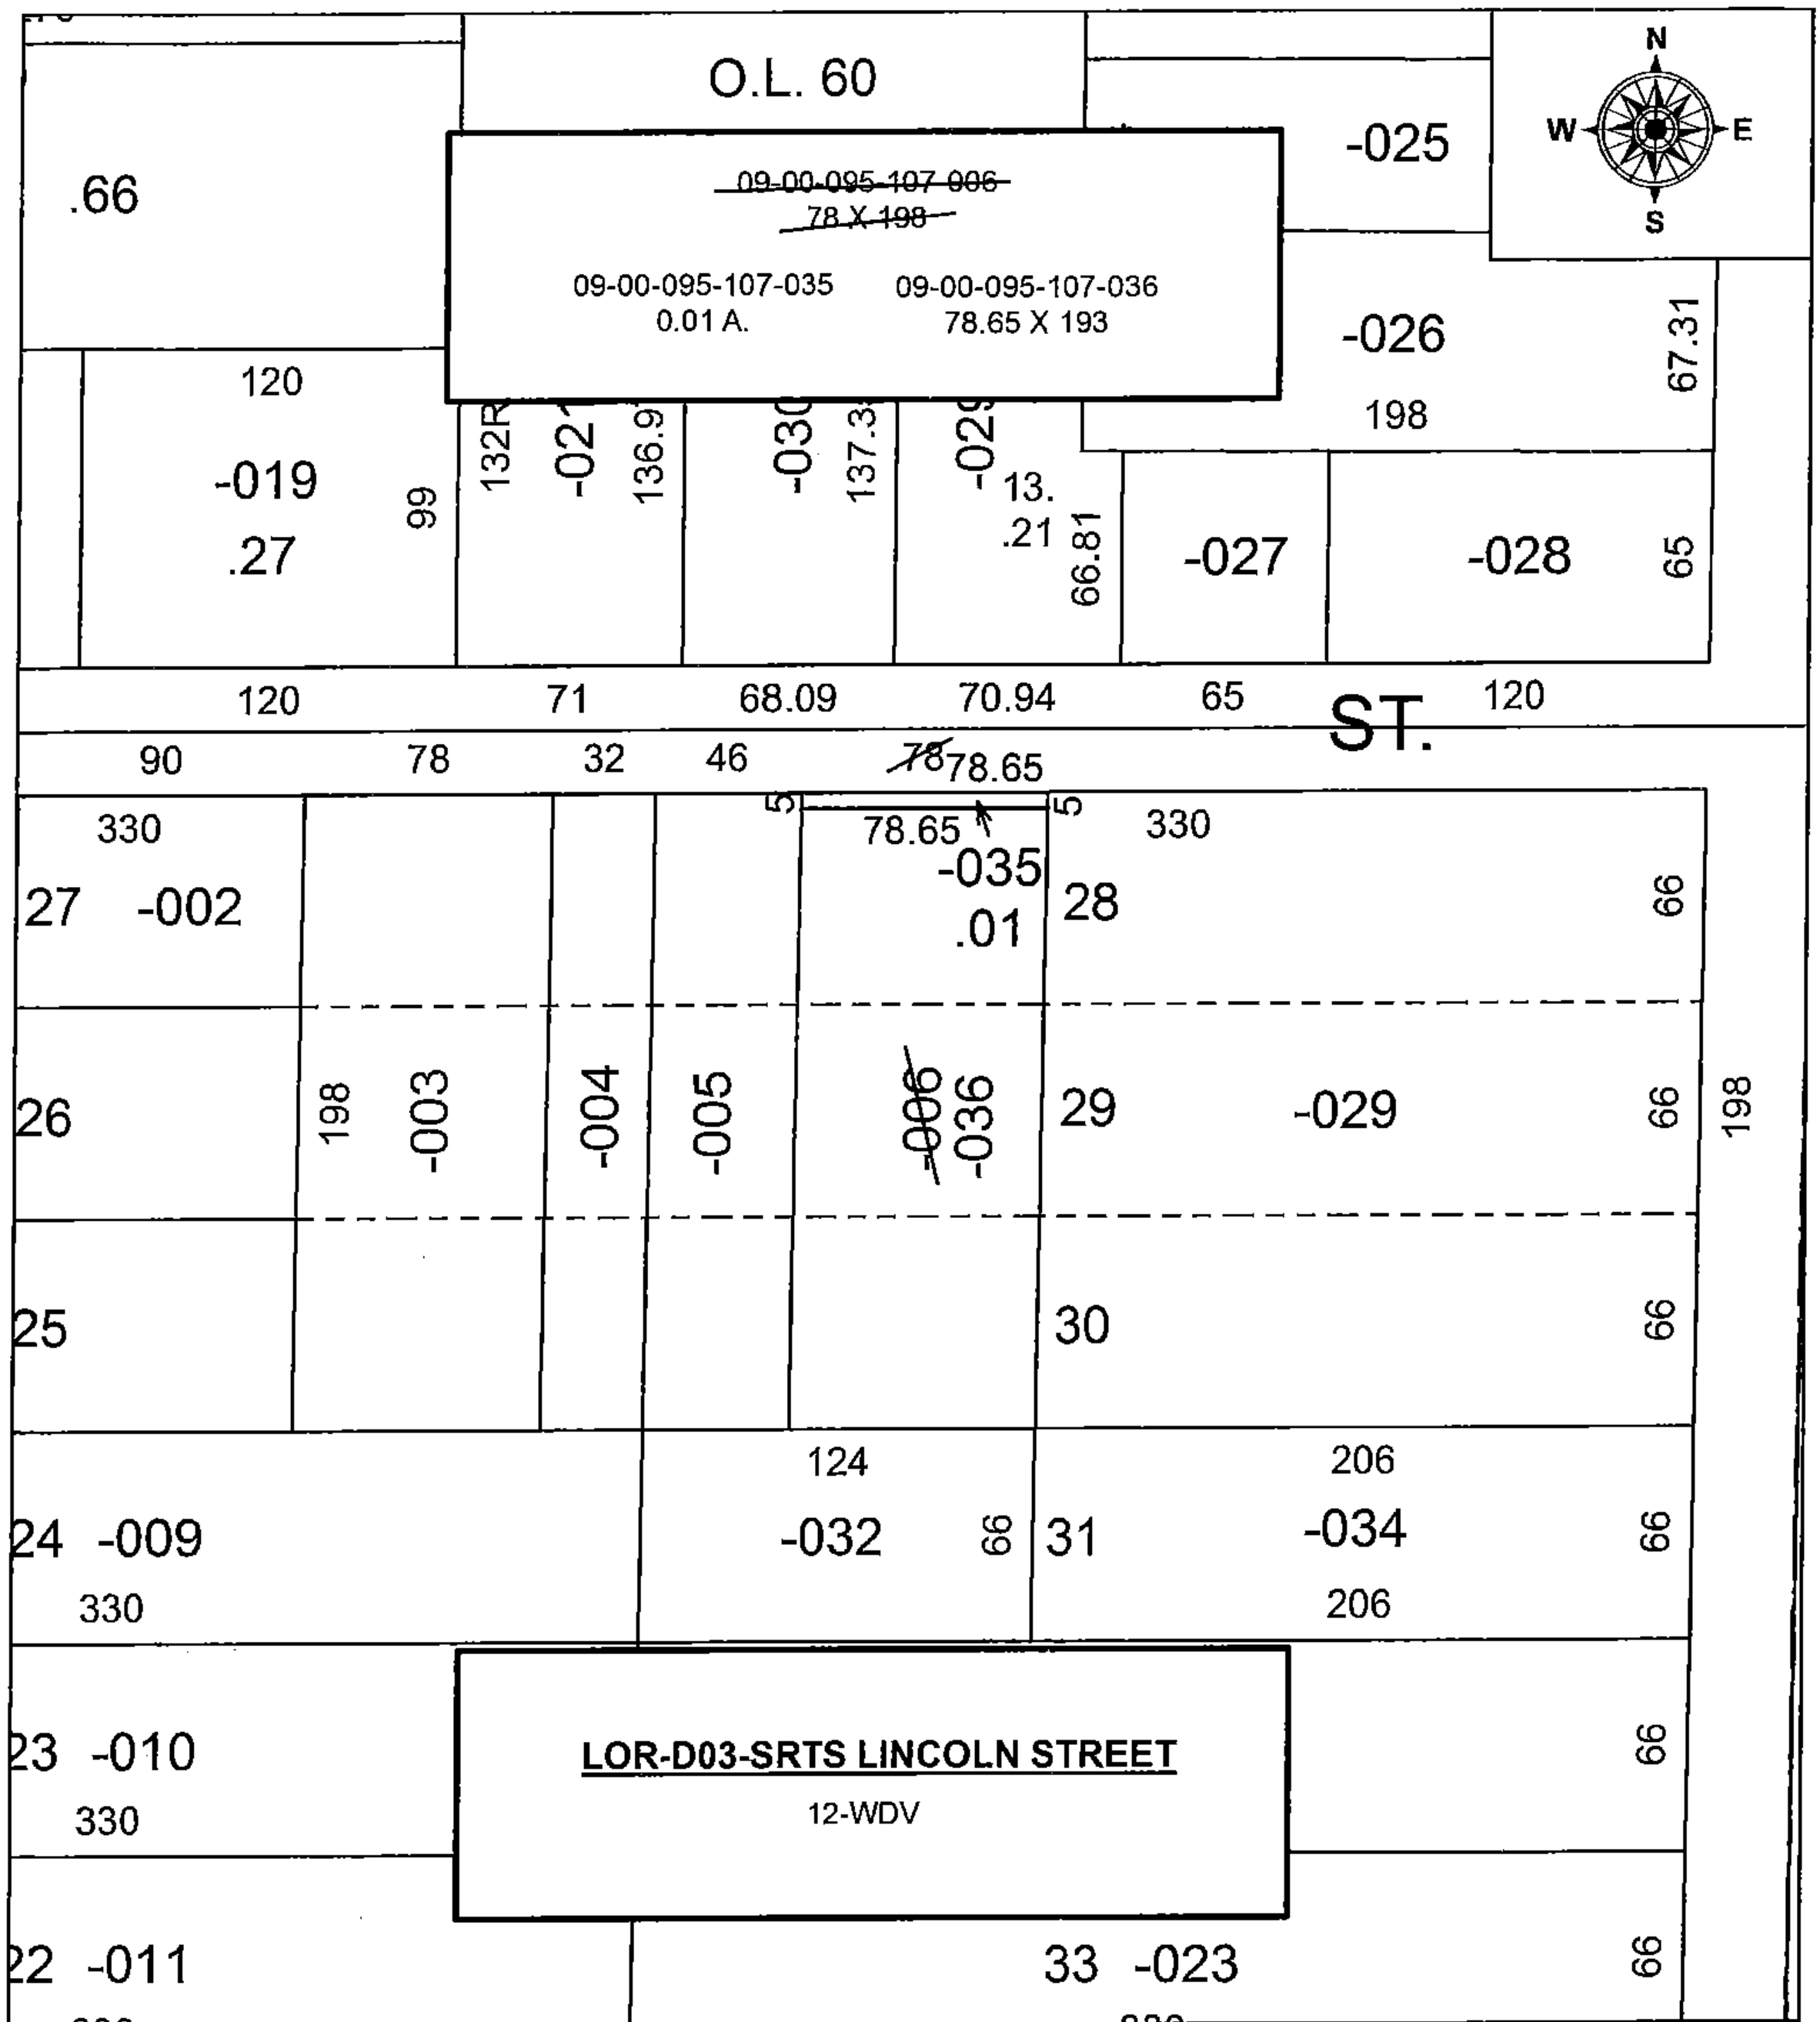

SPLITS/DEEDS PROCESSED
LORAIN COUNTY TAX MAP DEPARTMENT
226 MIDDLE AVE. ELYRIA, OH

SURVEYED BY: TREVOR A. BIXLER
CLOSURE: 1: 146,251
MAP PAGE(S): 9-00-095
APPOVED BY: RRM **DATE:** 10-18-16
SCALE: 1" = 70 **PRIOR INSTRUMENT:** 20100343537