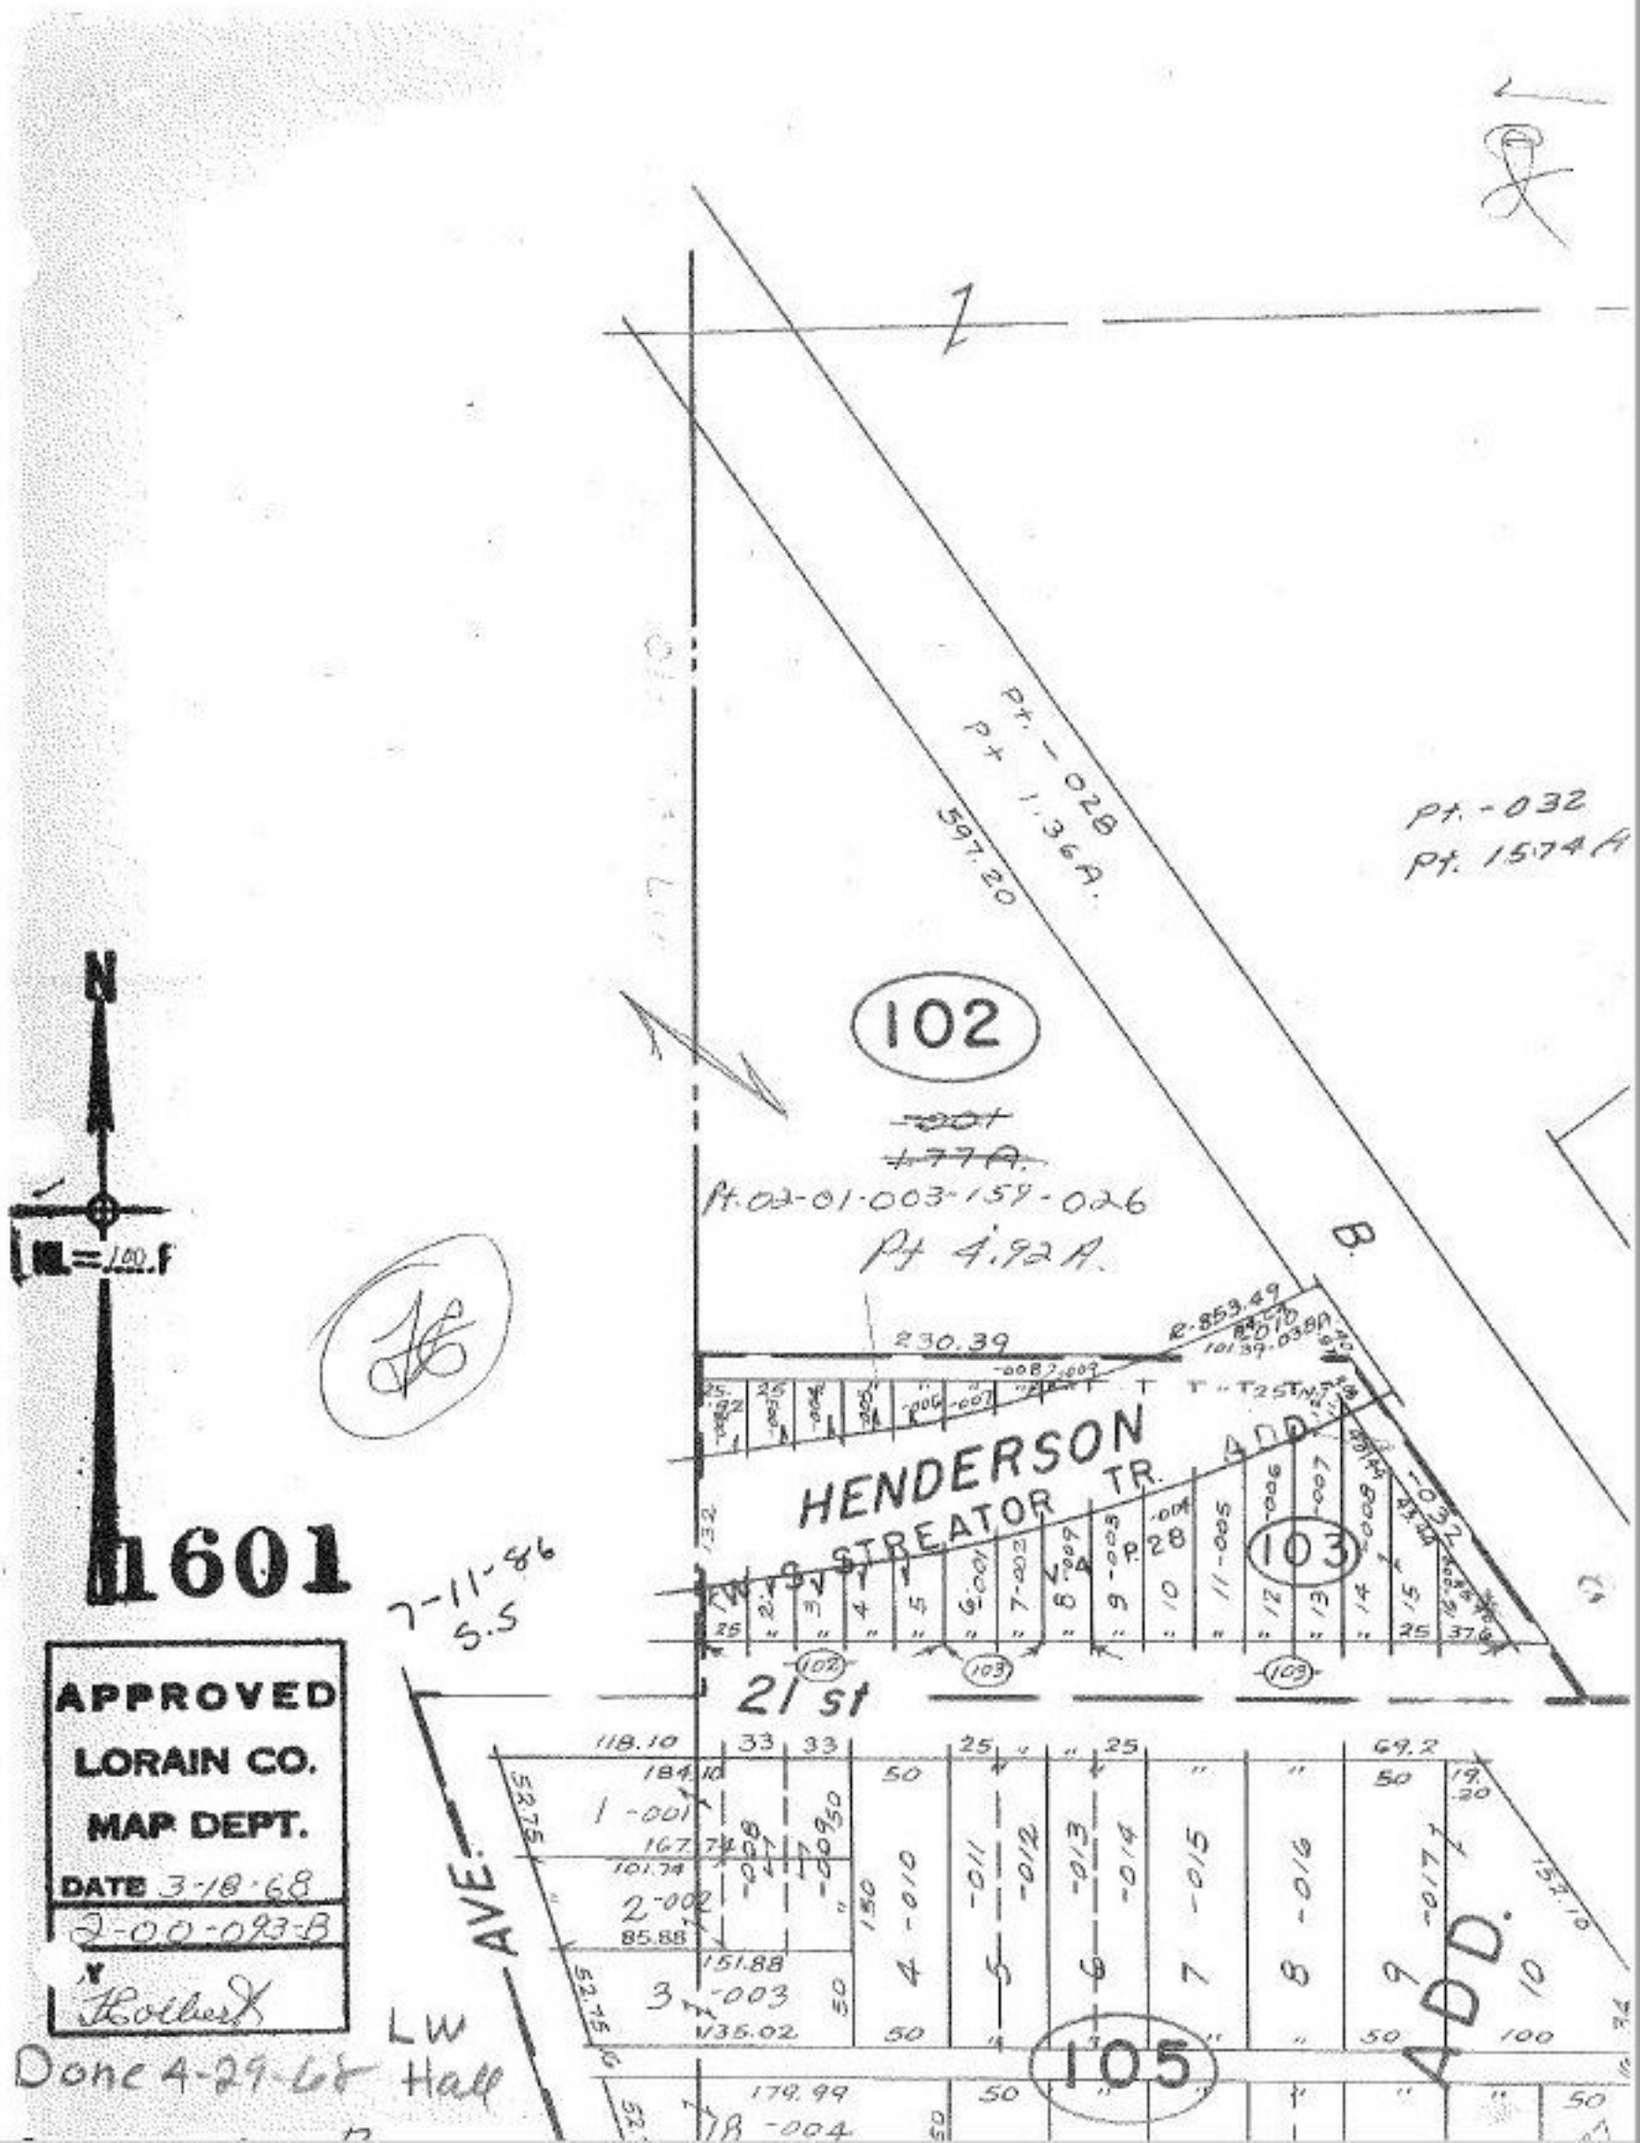

N
1601
APPROVED
LORAIN CO.
MAP DEPT.
DATE 3-18-68
2-00-093-B
Done 4-29-68
LW Hall
7-11-86
S.S
102
103
105
HENDERSON
STREATOR TR.
ADD.
21 st
AVE.
Pt. -028
Pt 1.36A.
597.20
Pt. -032
Pt. 1.574A
Pt. 02-01-003-159-026
Pt 4.92A.
230.39
R-853.49