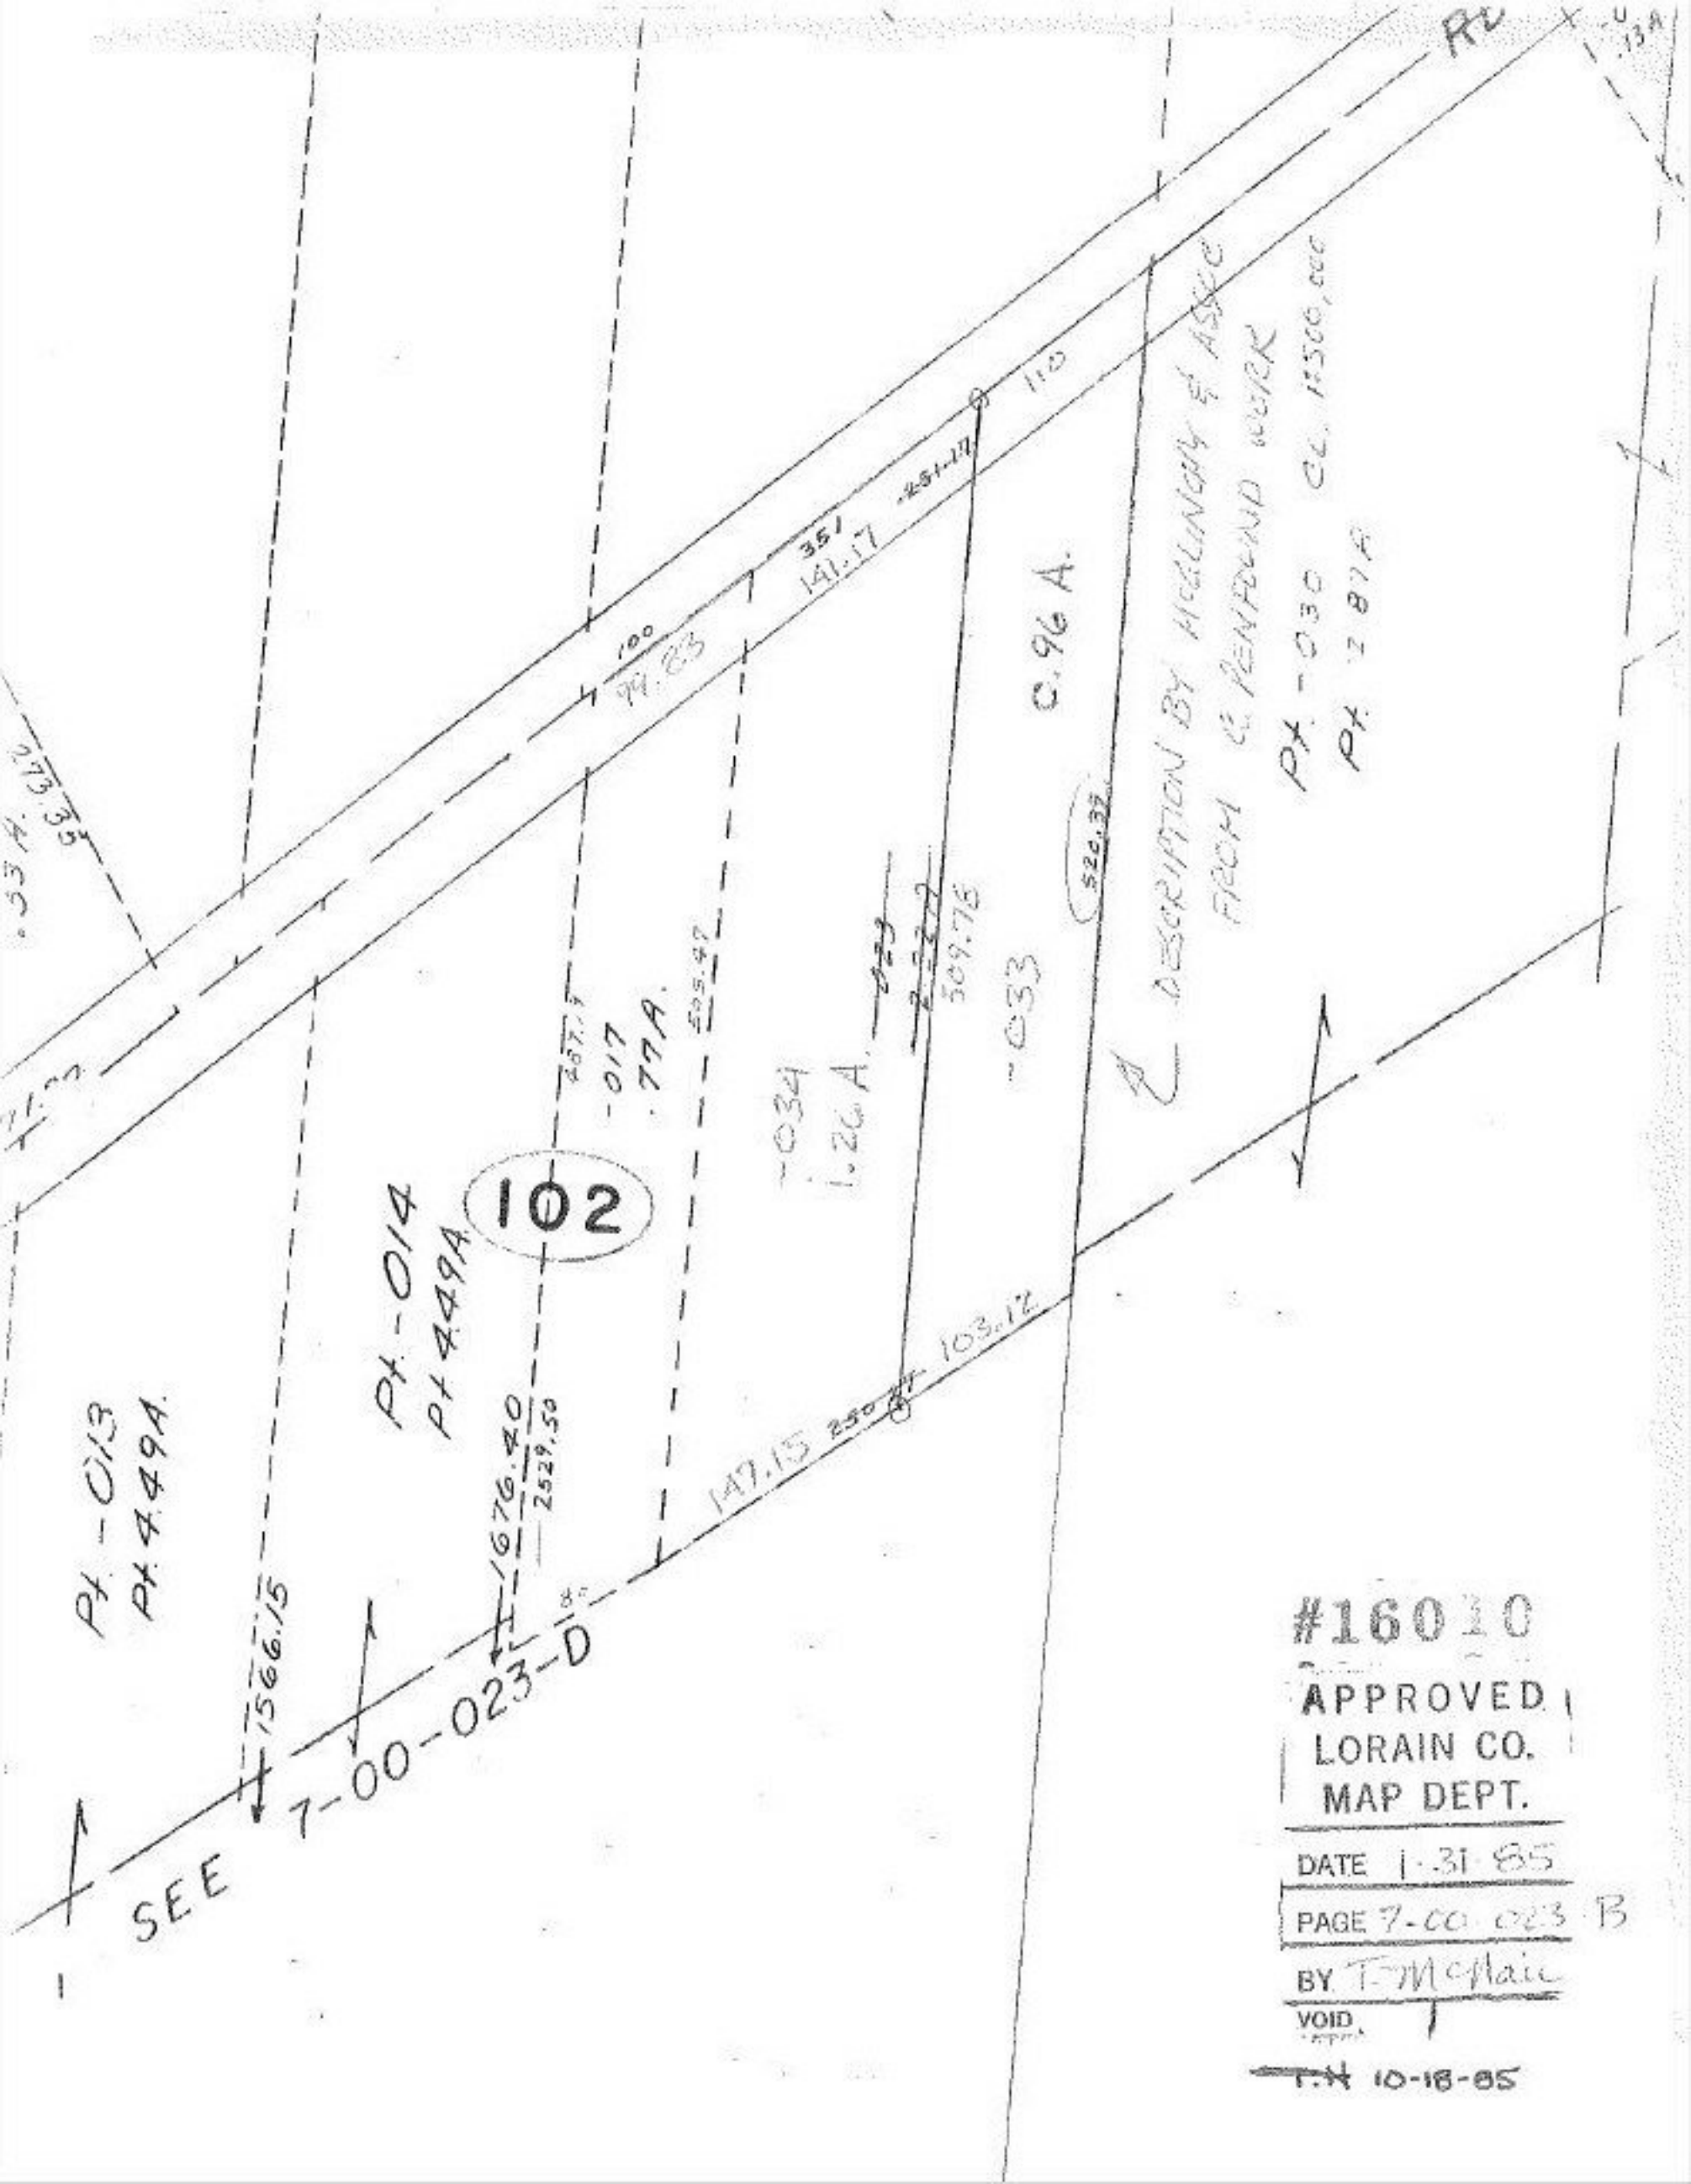

#16010
APPROVED
LORAIN CO.
MAP DEPT.
DATE 1-31-85
PAGE 7-00-023 B
BY T. McHale
VOID

T.N 10-18-85