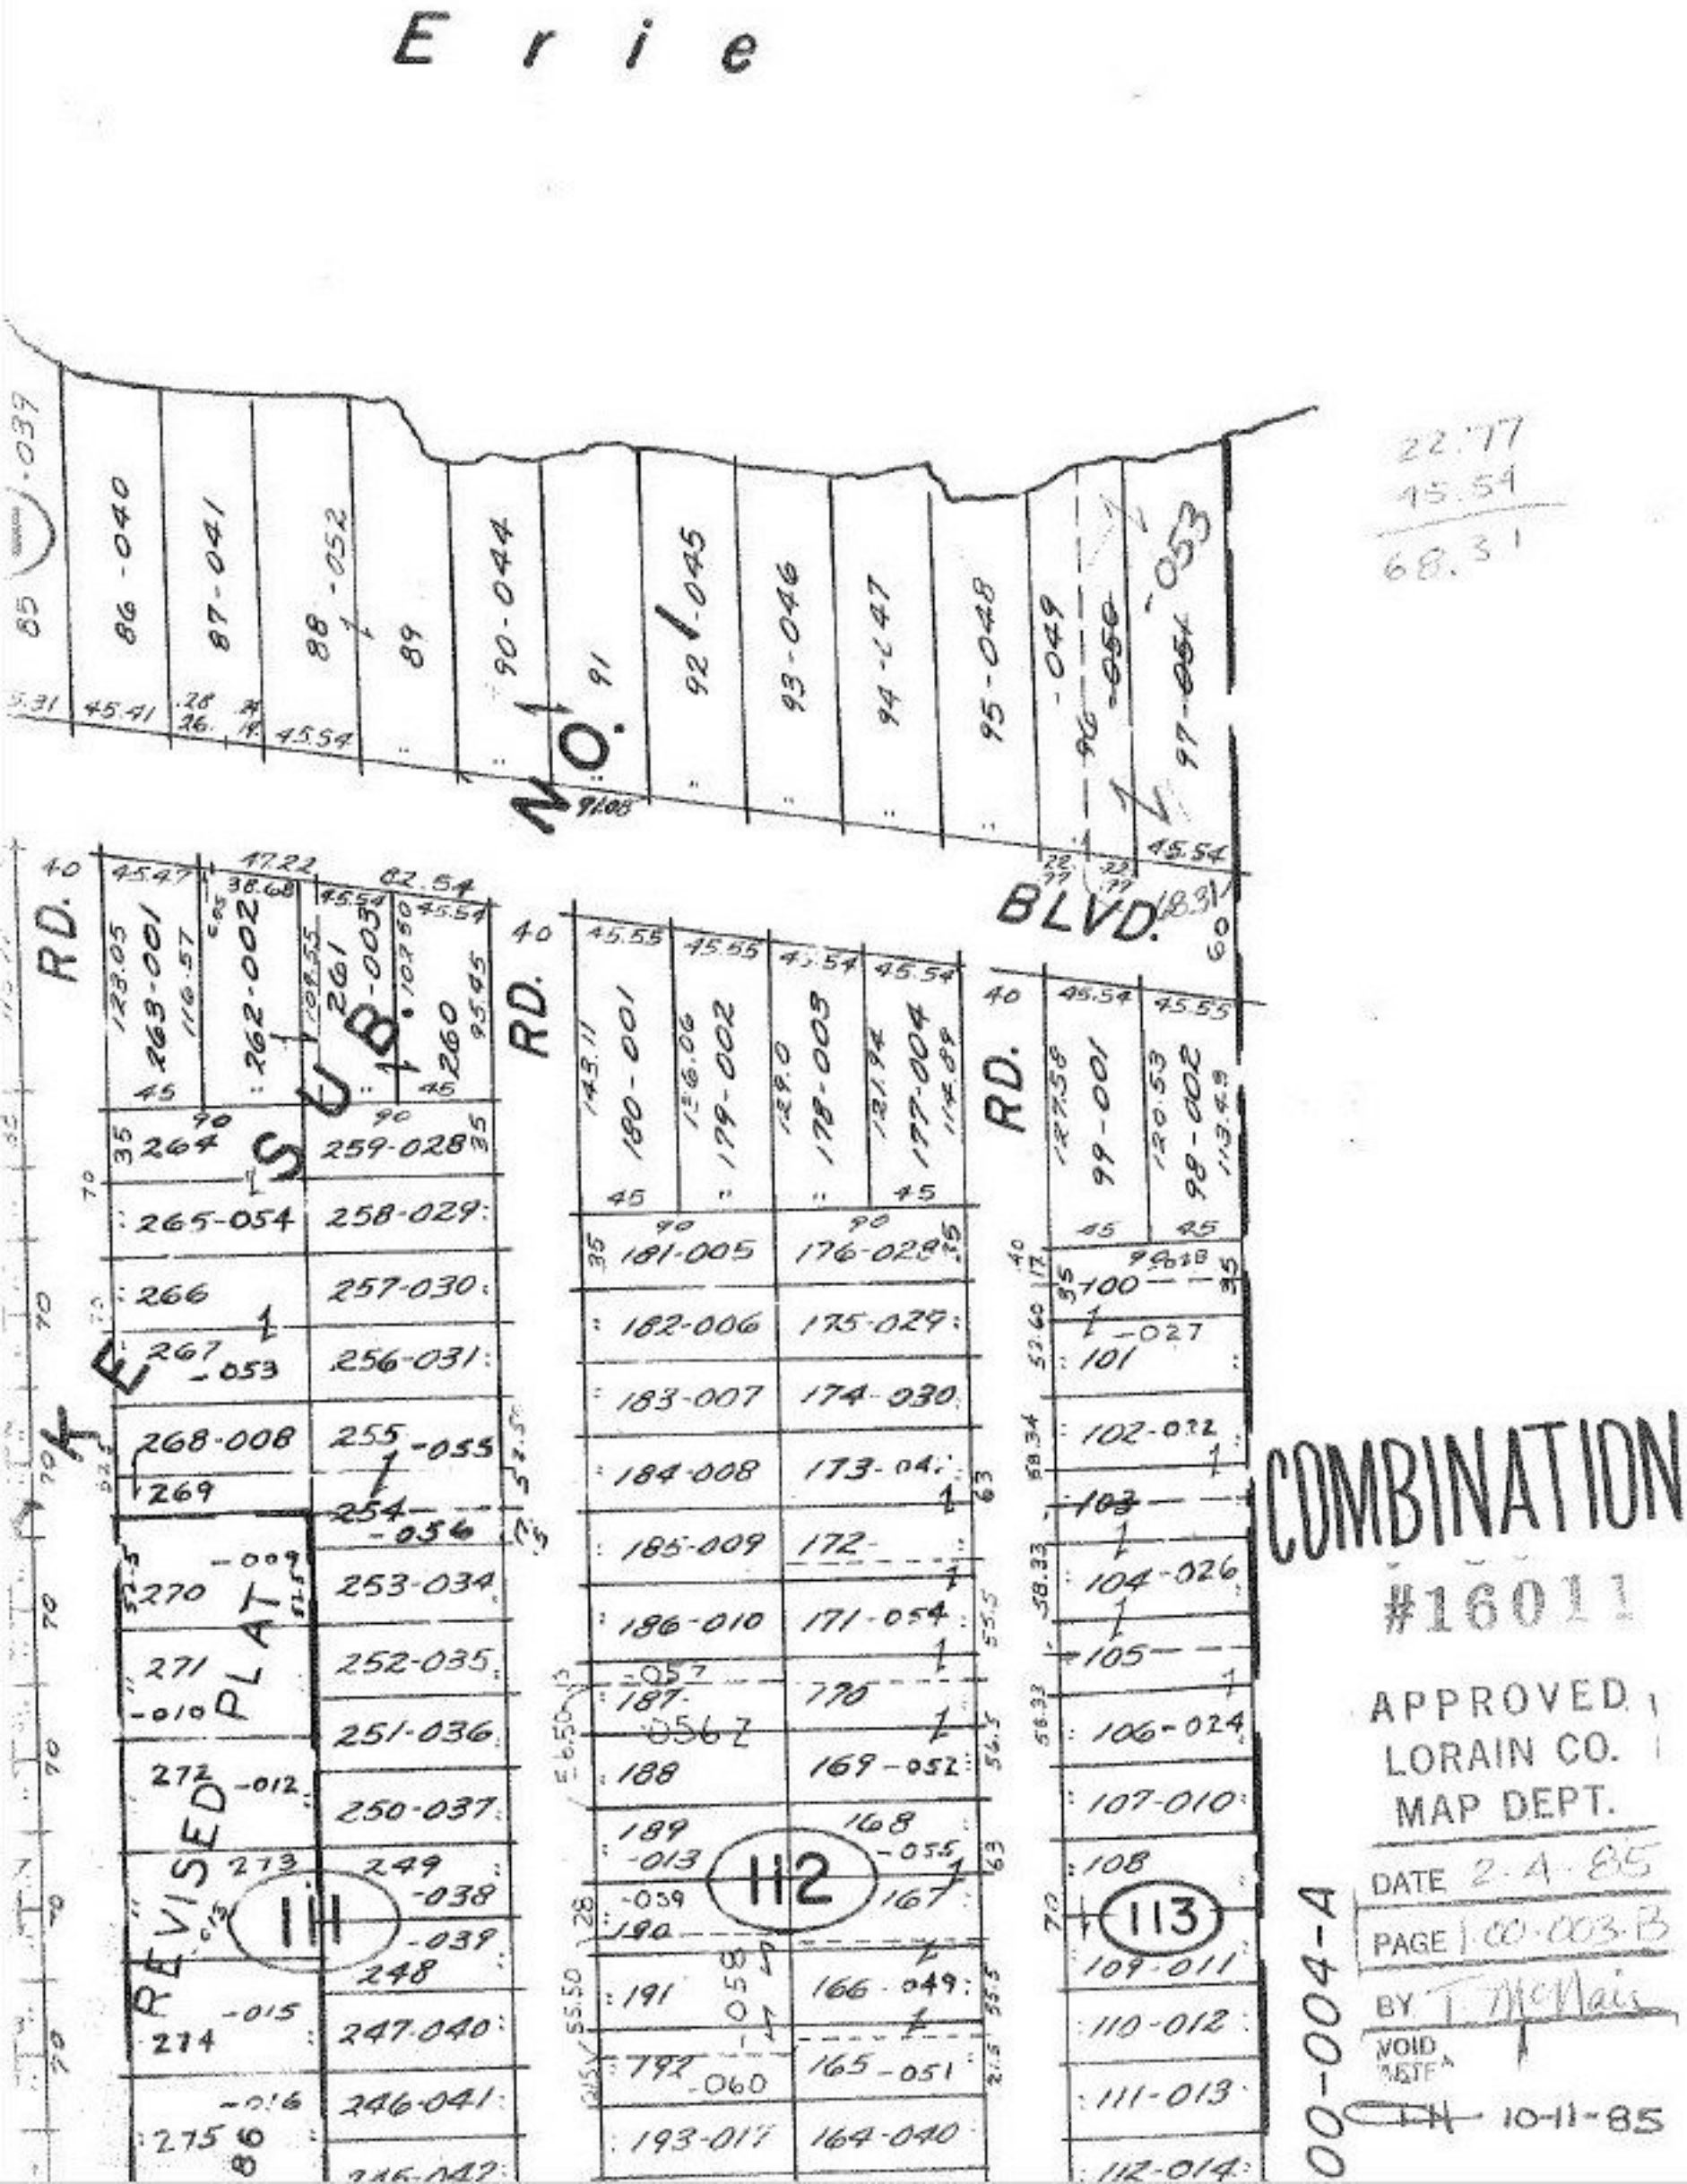
Erie
22.77
45.54
68.31
NO.
BLVD.
RD.
RD.
RD.
SUB.
KEY
REVISED PLAT
111
112
113
COMBINATION
#16011
APPROVED
LORAIN CO.
MAP DEPT.
DATE 2-4-85
PAGE 1-00-003-B
BY T. McNair
VOID
10-11-85
00-004-A