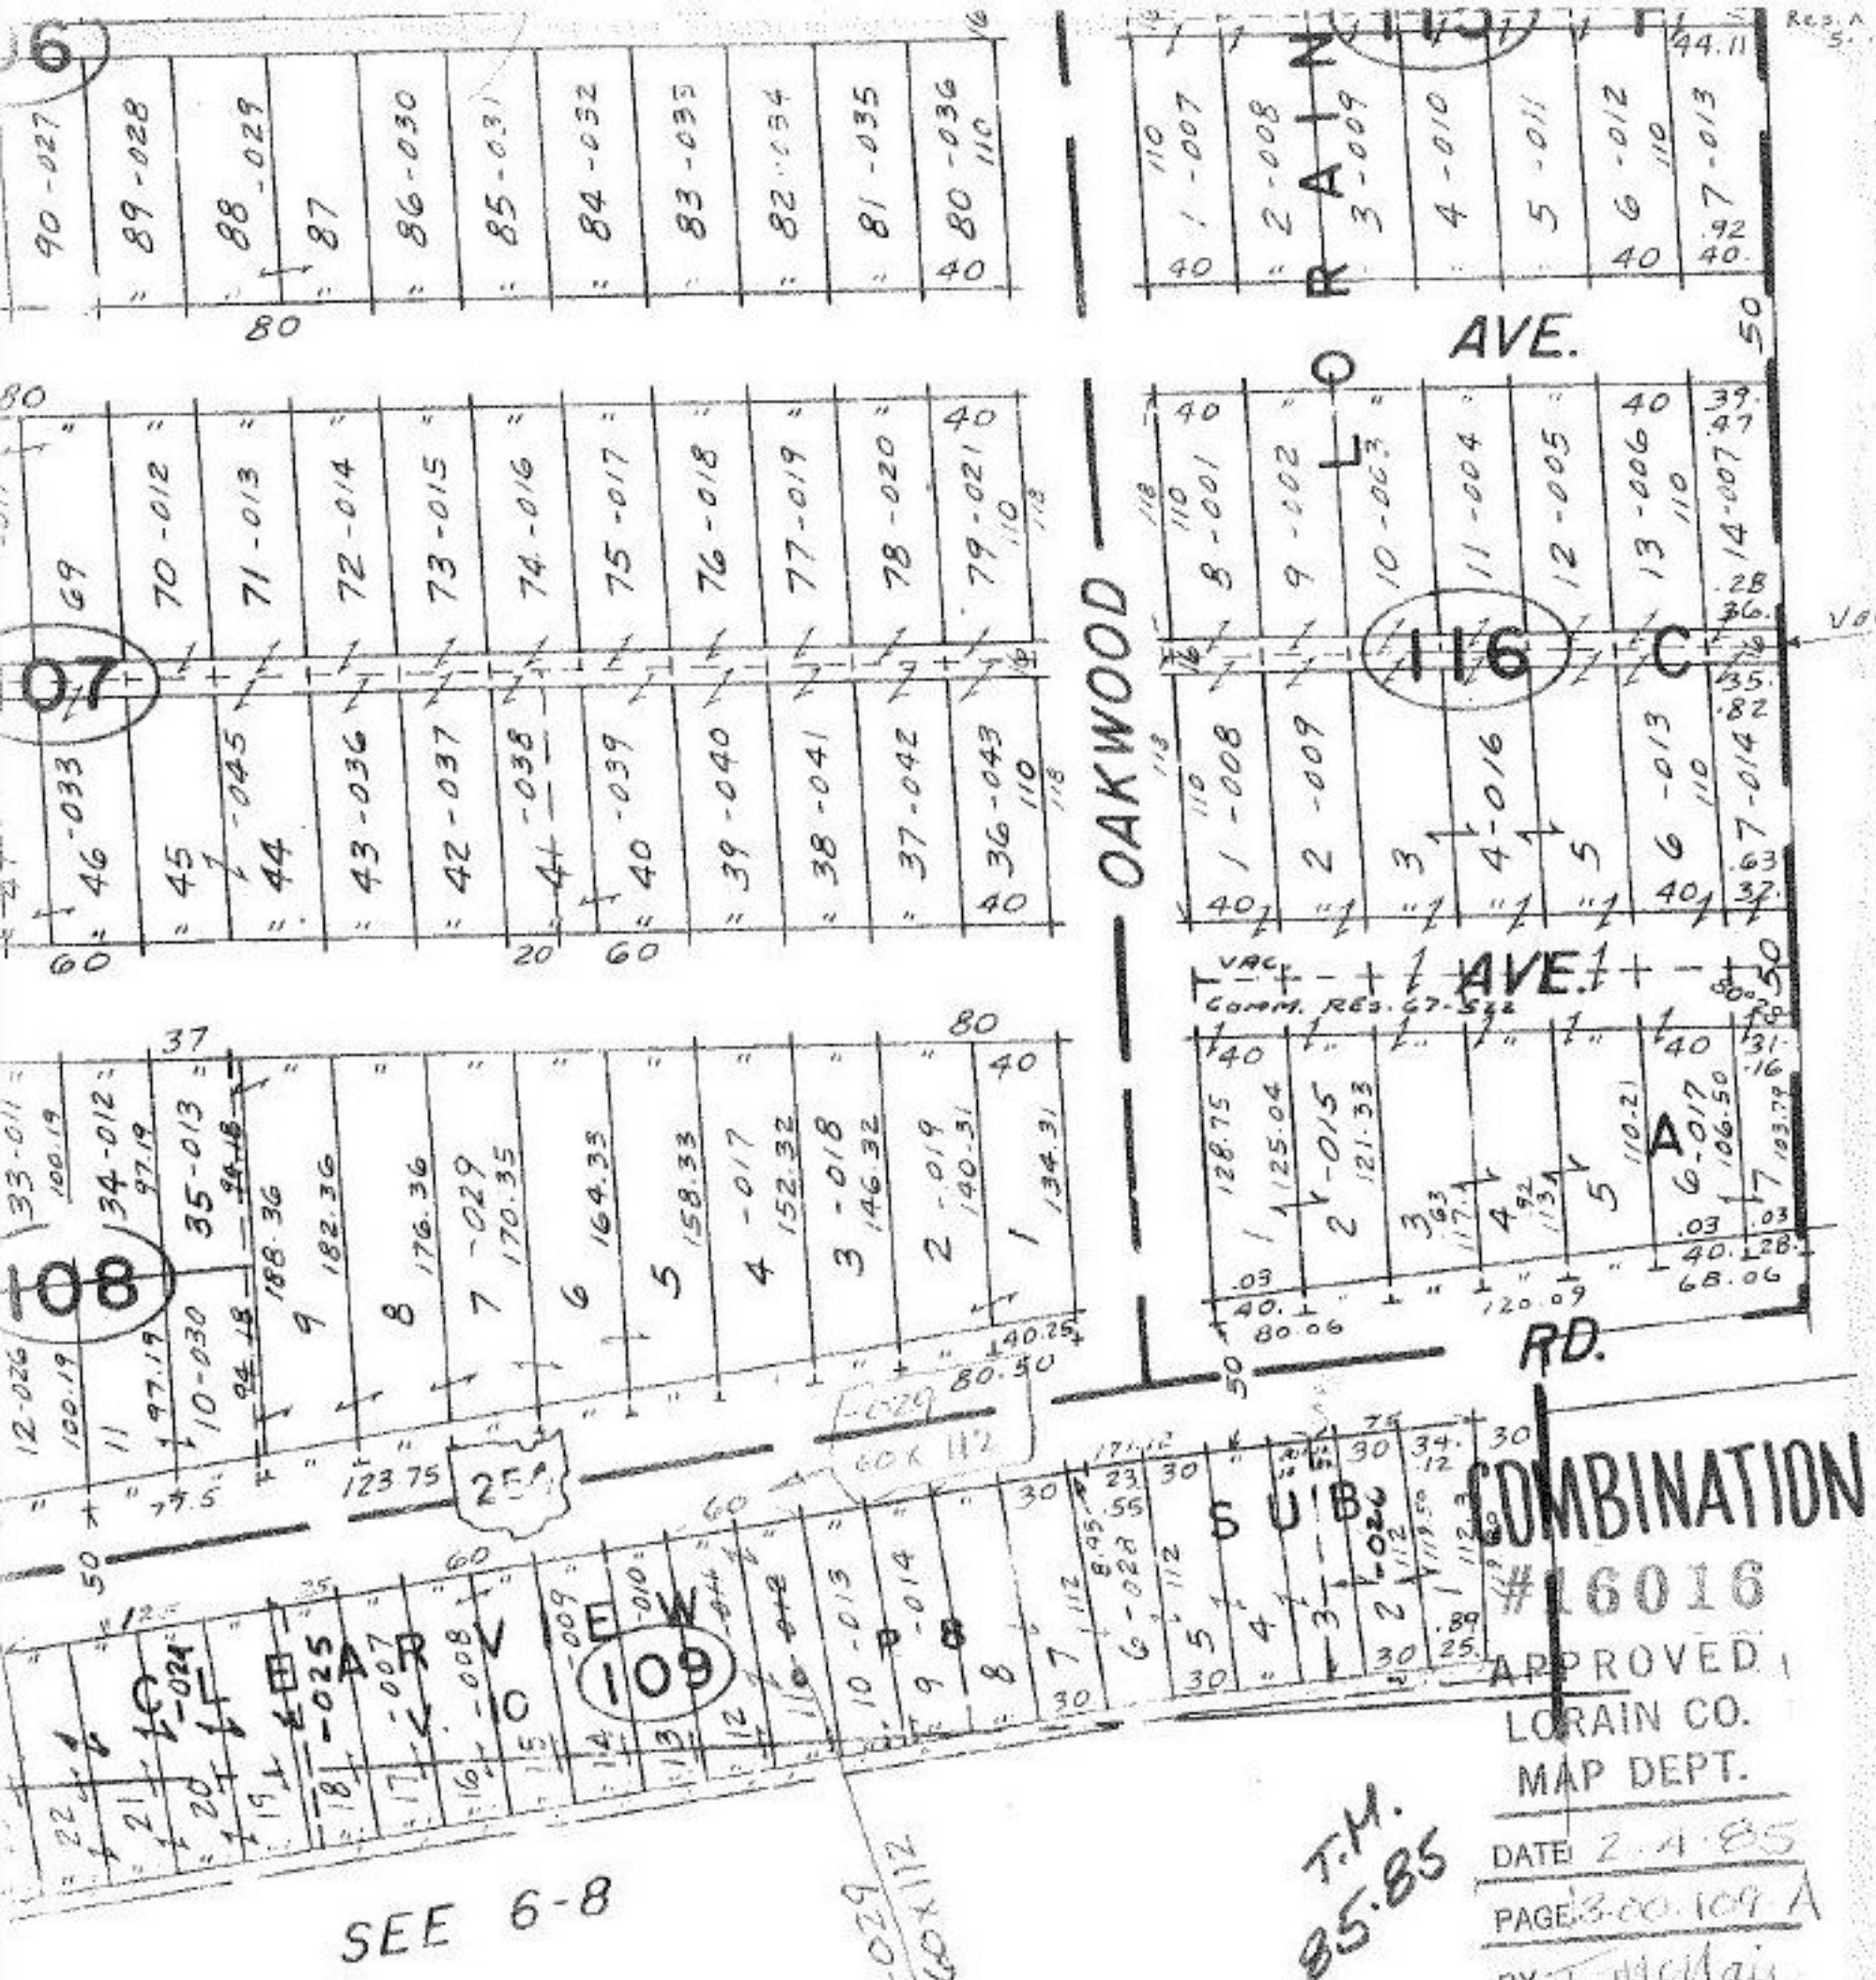

SHEFFIELD

SCALE 1" = 100'