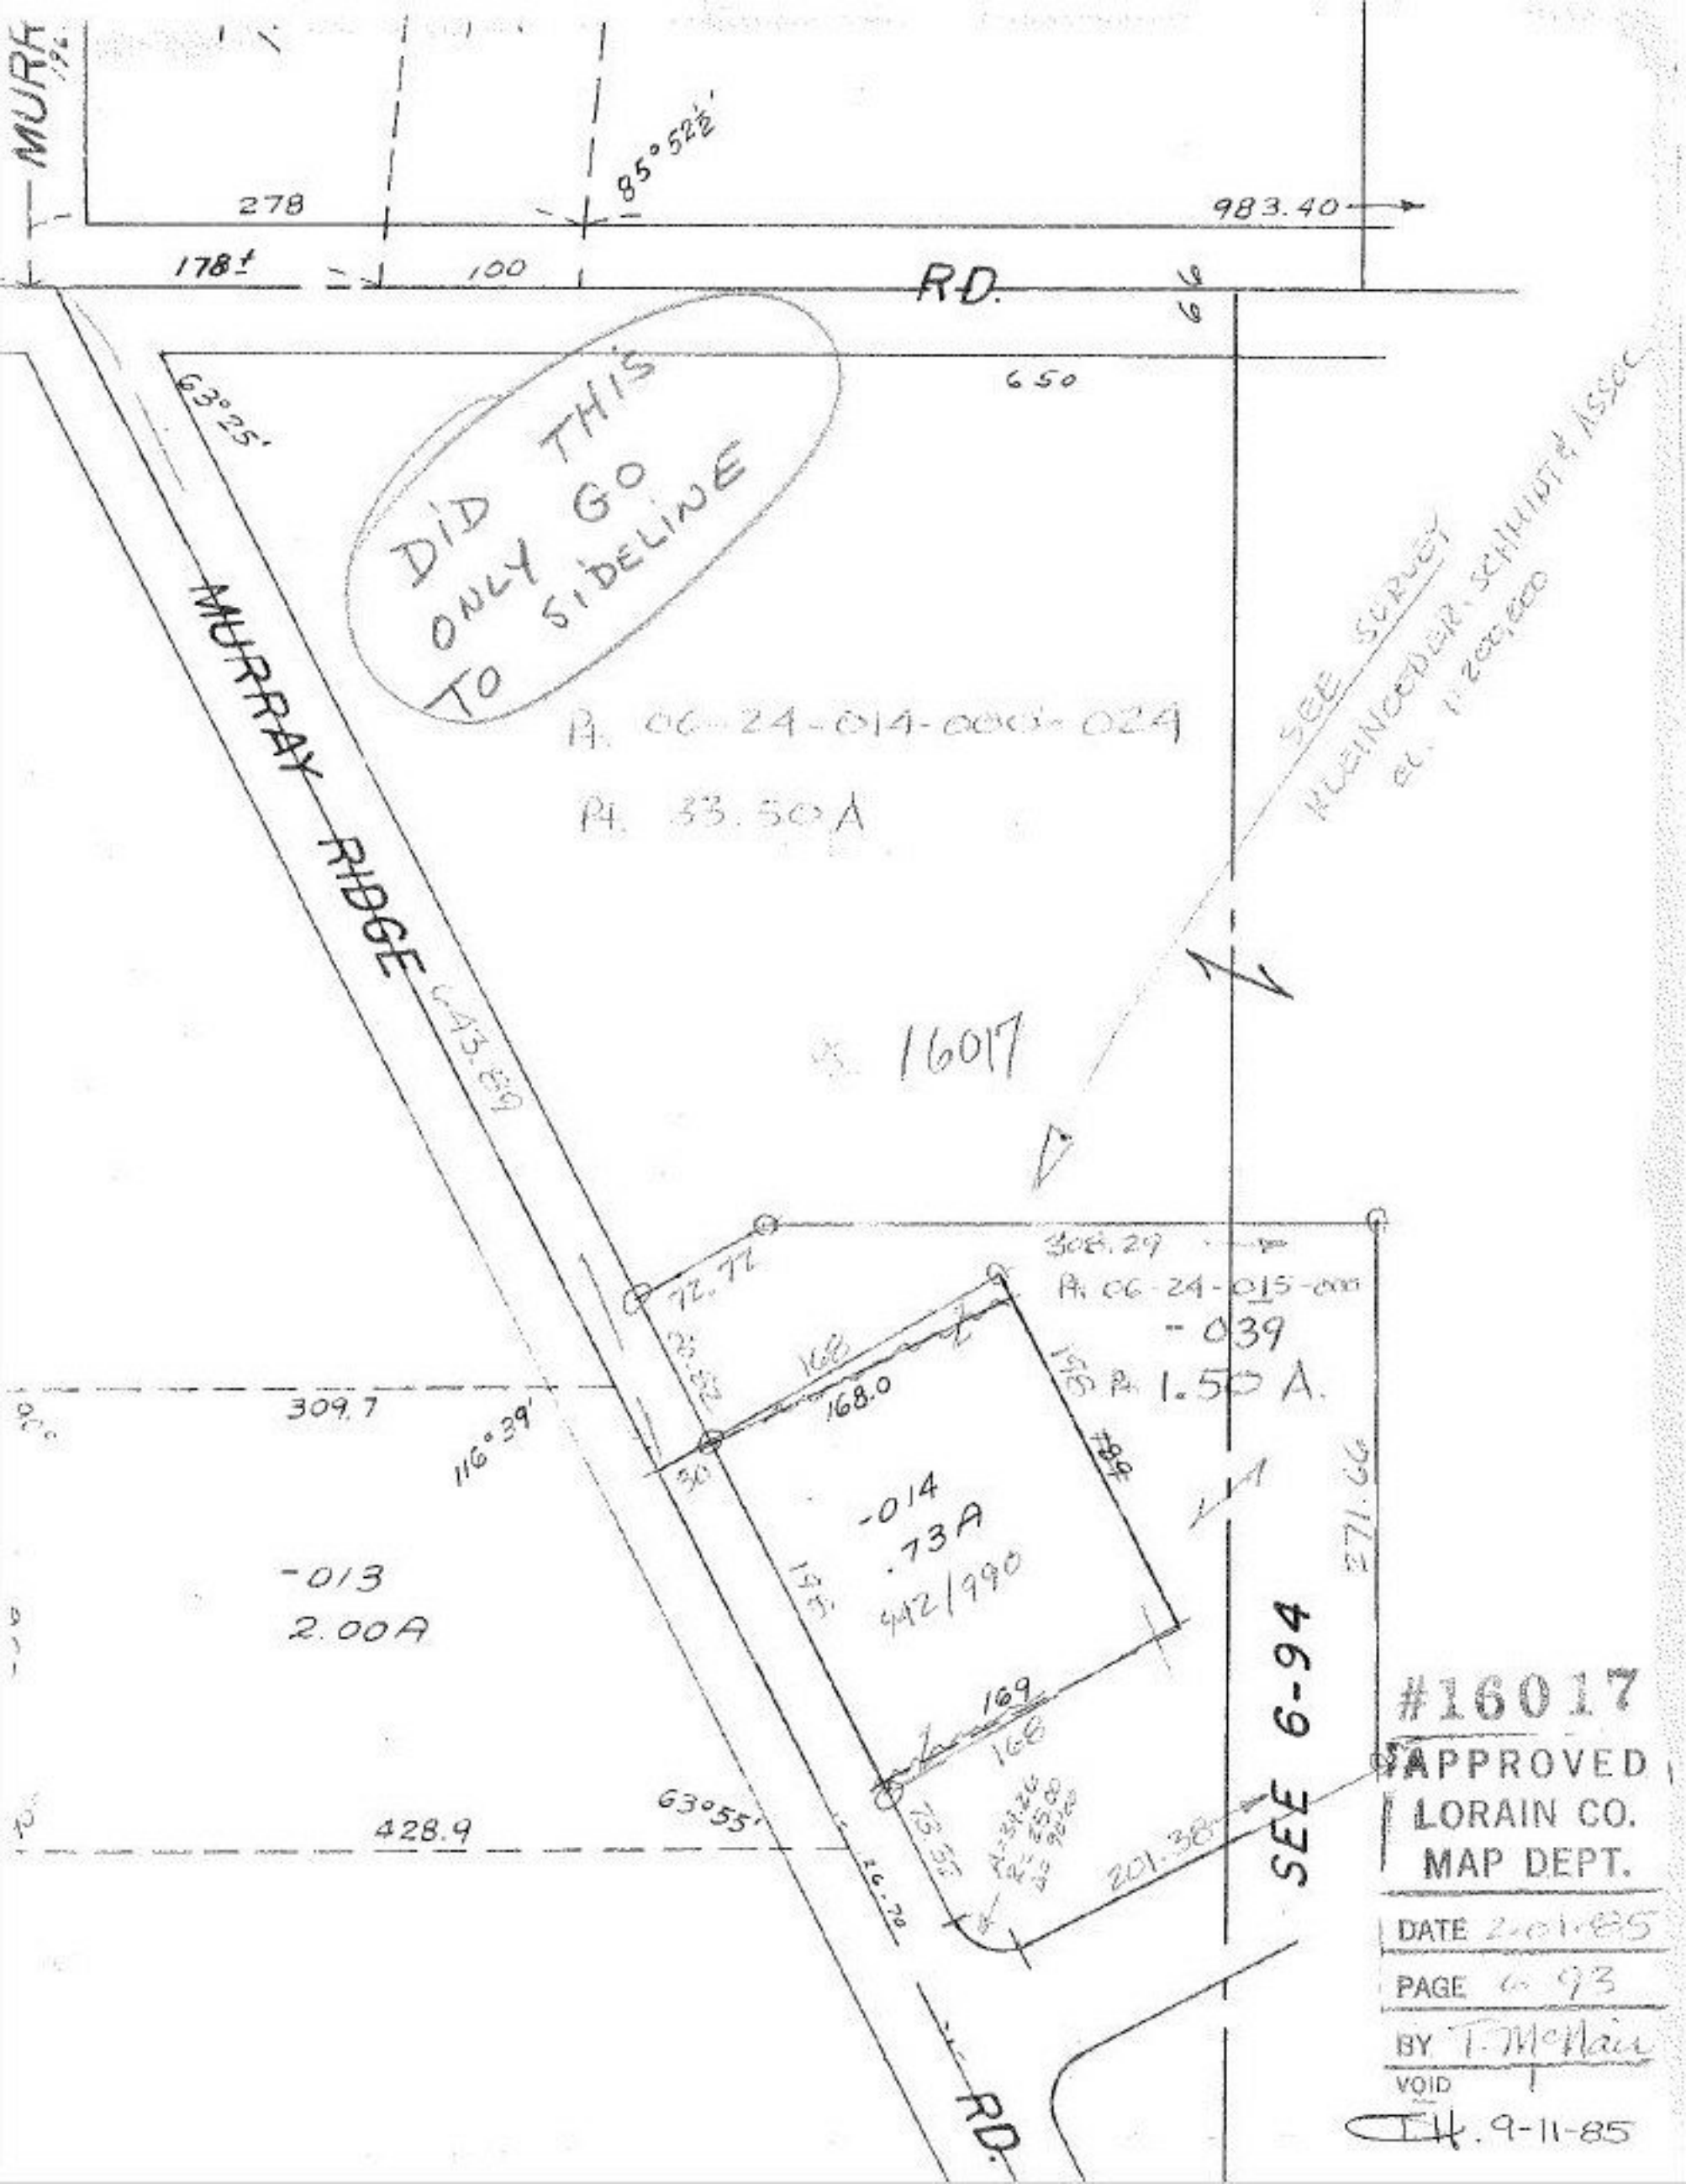
MURR
278
85°52½'
983.40
178±
100
RD.
66
650
63°25'
DID THIS ONLY GO TO SIDELINE
MURRAY RIDGE
Pt. 06-24-014-000-024
Pt. 33.50 A
SEE SURVEY
KLEINOEDER, SCHMIDT & ASSOC.
Pt. 16017
308.29
Pt. 06-24-015-000
-039
Pt. 1.50 A.
72.72
168
168.0
309.7
116°39'
-014
.73A
942/990
-013
2.00A
271.66
169
168
SEE 6-94
63°55'
428.9
201.38
RD.
#16017
APPROVED
LORAIN CO.
MAP DEPT.
DATE 2-01-85
PAGE 6-93
BY T. McNair
VOID
9-11-85