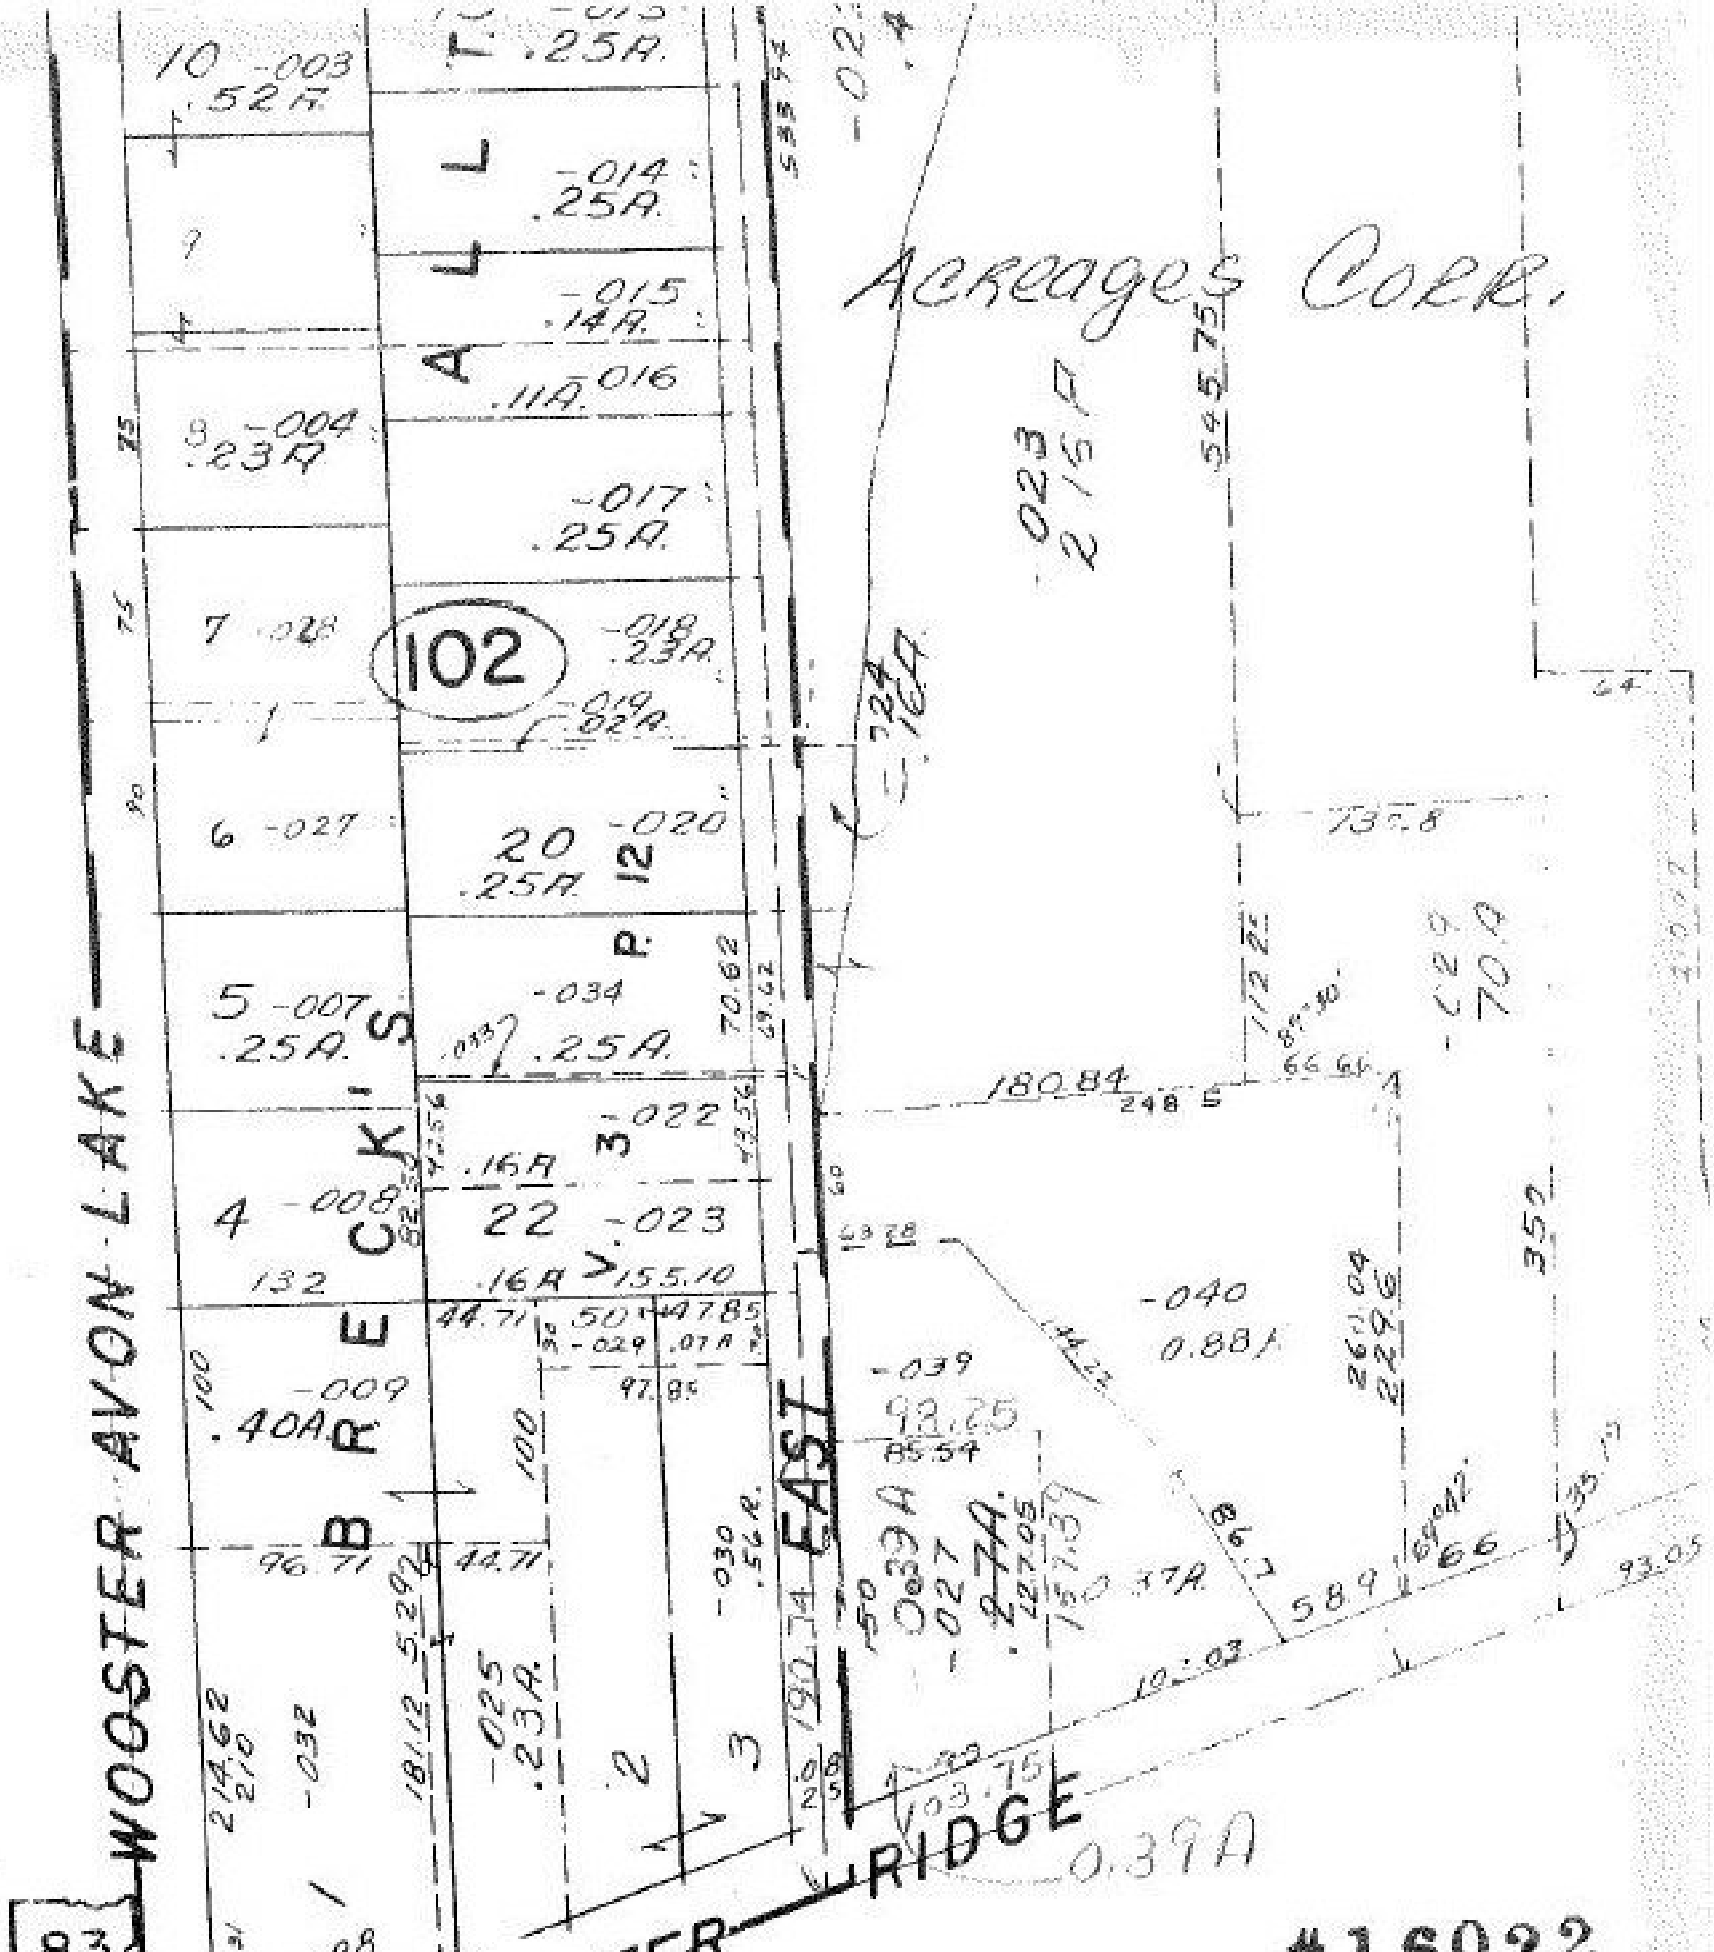

Acreages Corr. Per.
Survey Deed by
Foor & Assoc.
4/75

#16022

APPROVED
LORAIN CO.
MAP DEPT.
DATE 2/16/85
7-00-021-A
B. Carolyn Franc
VOID AFTER

FH 10-18-85