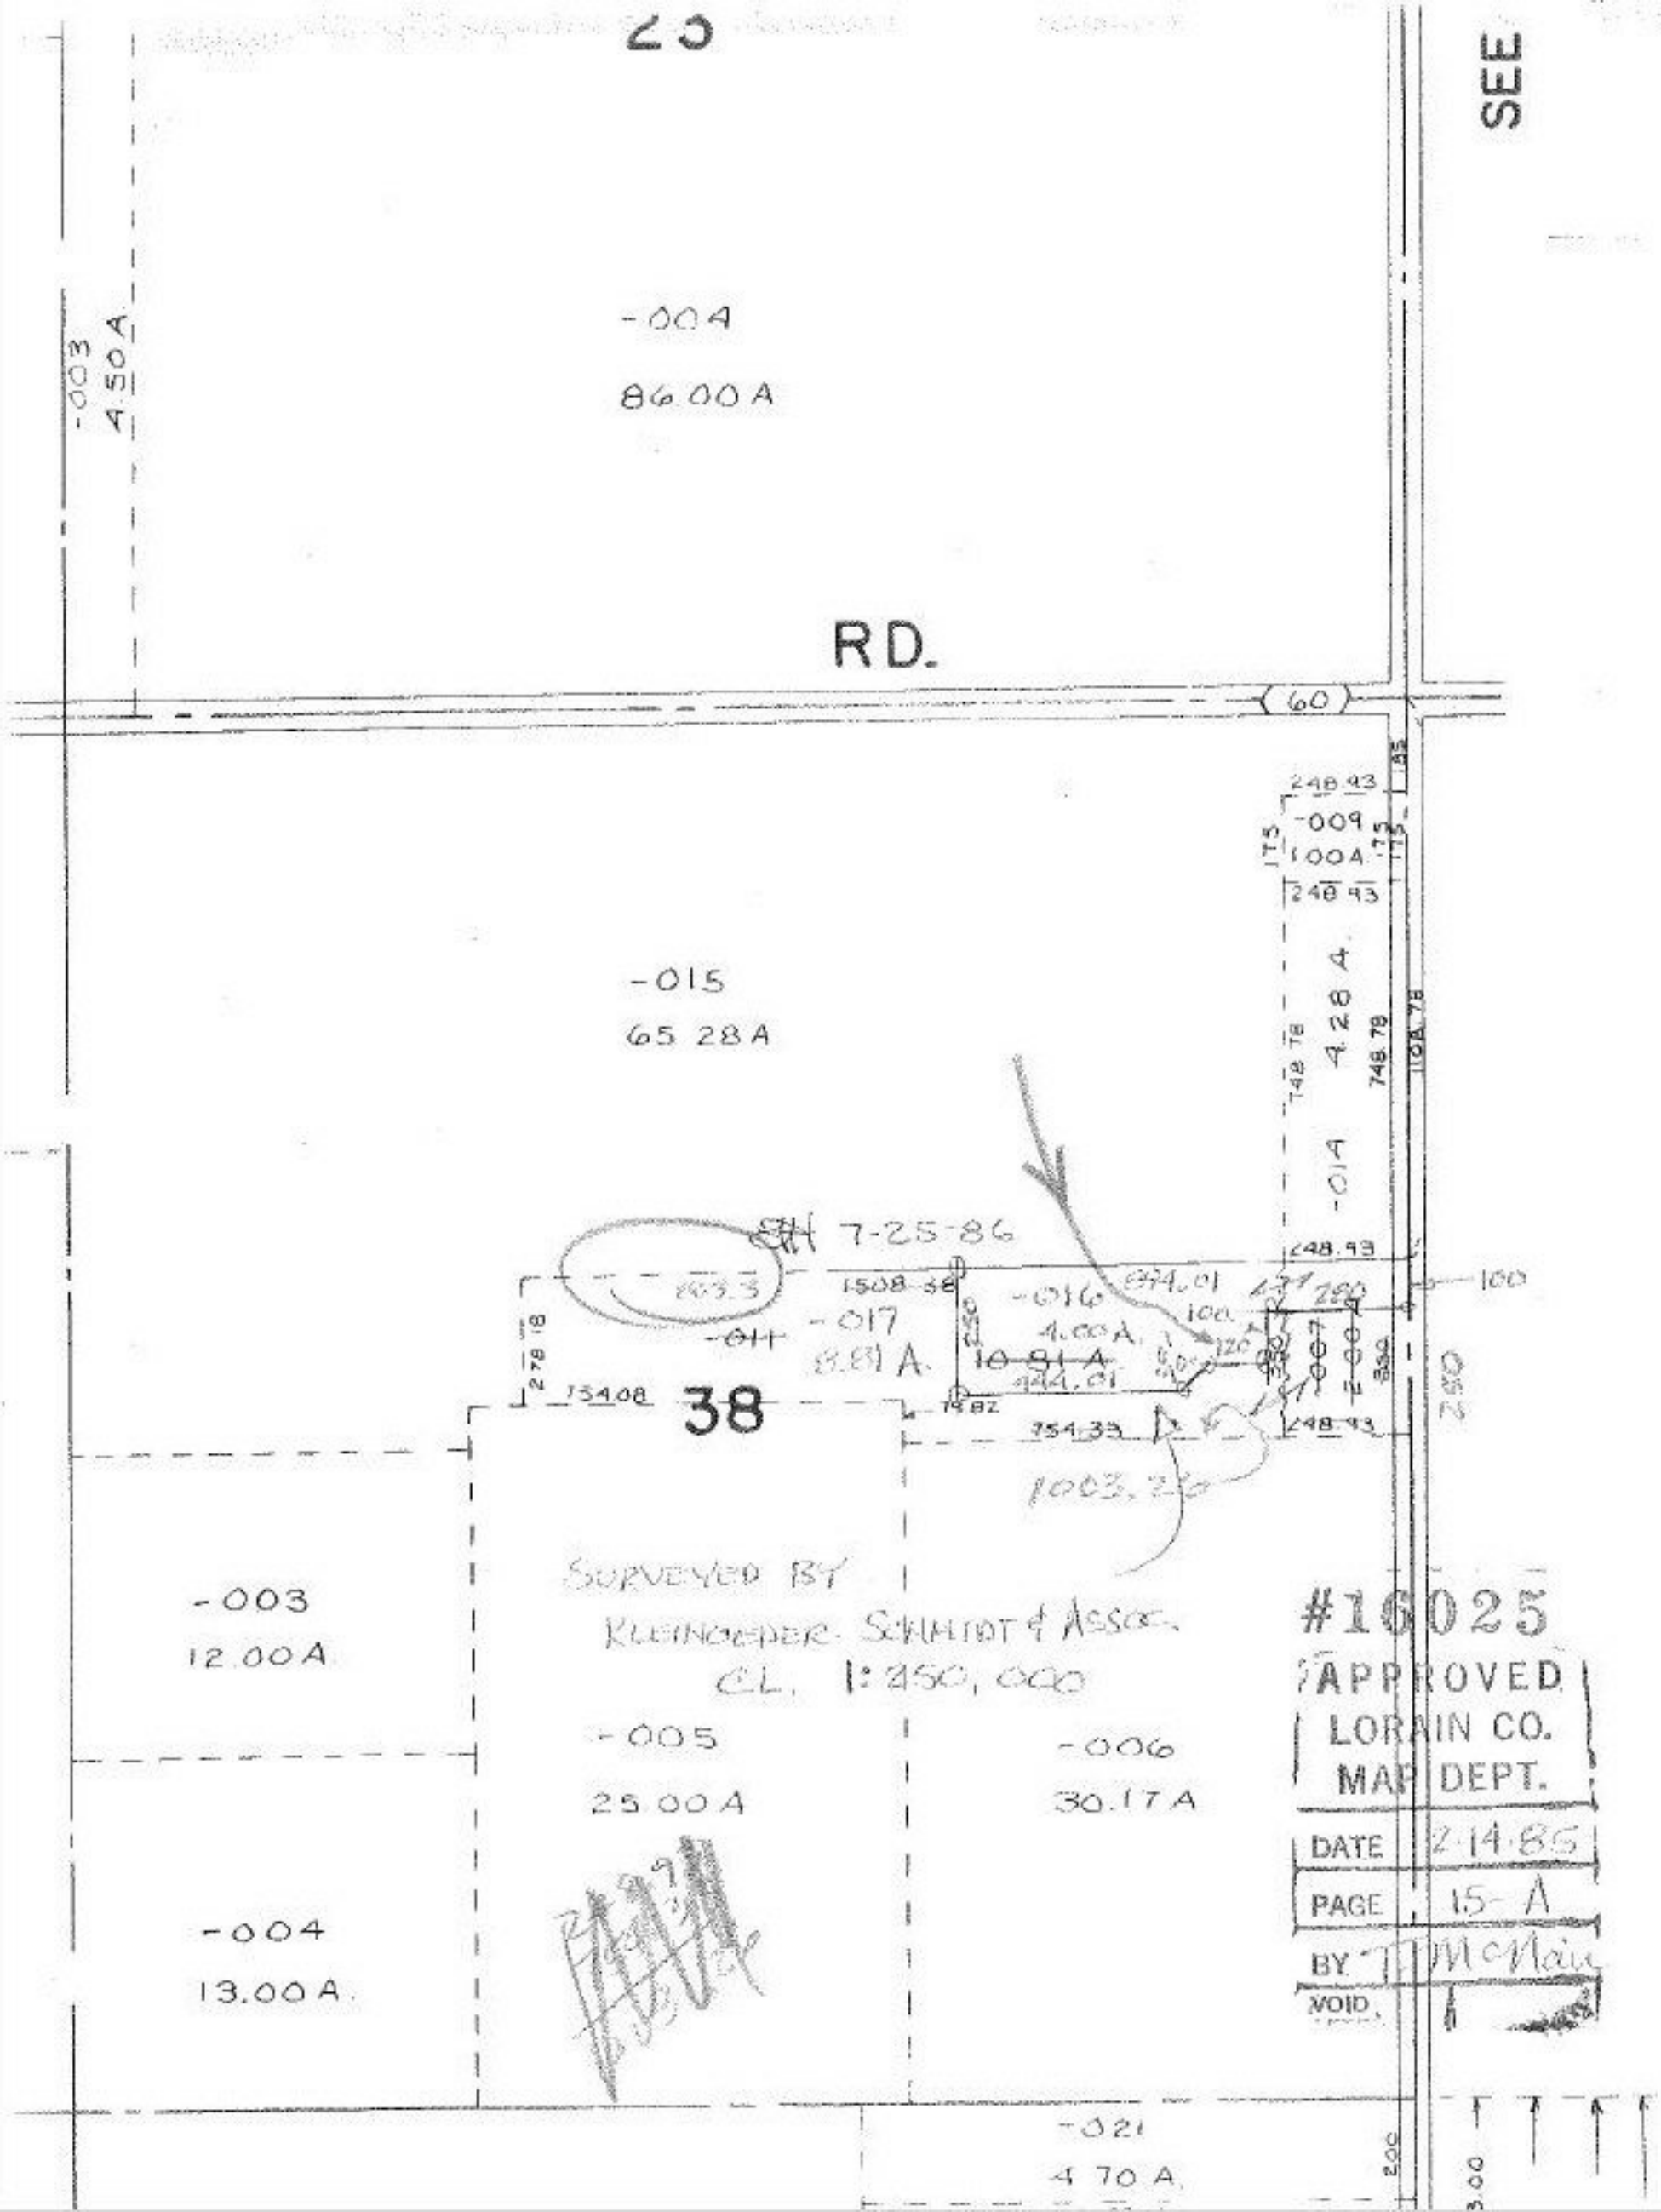
SEE
-004
86.00 A
-003
4.50 A
RD.
60
-015
65.28 A
-009
1.00 A
4.28 A
-016
4.00 A
-017
8.81 A
10.81 A
38
-003
12.00 A
-005
25.00 A
-006
30.17 A
-004
13.00 A
-021
4.70 A
SURVEYED BY
KLEINOEPER SCHMIDT & ASSOC.
CL. 1:250,000
#16025
APPROVED
LORAIN CO.
MAP DEPT.
DATE 2-14-85
PAGE 15-A
BY
VOID