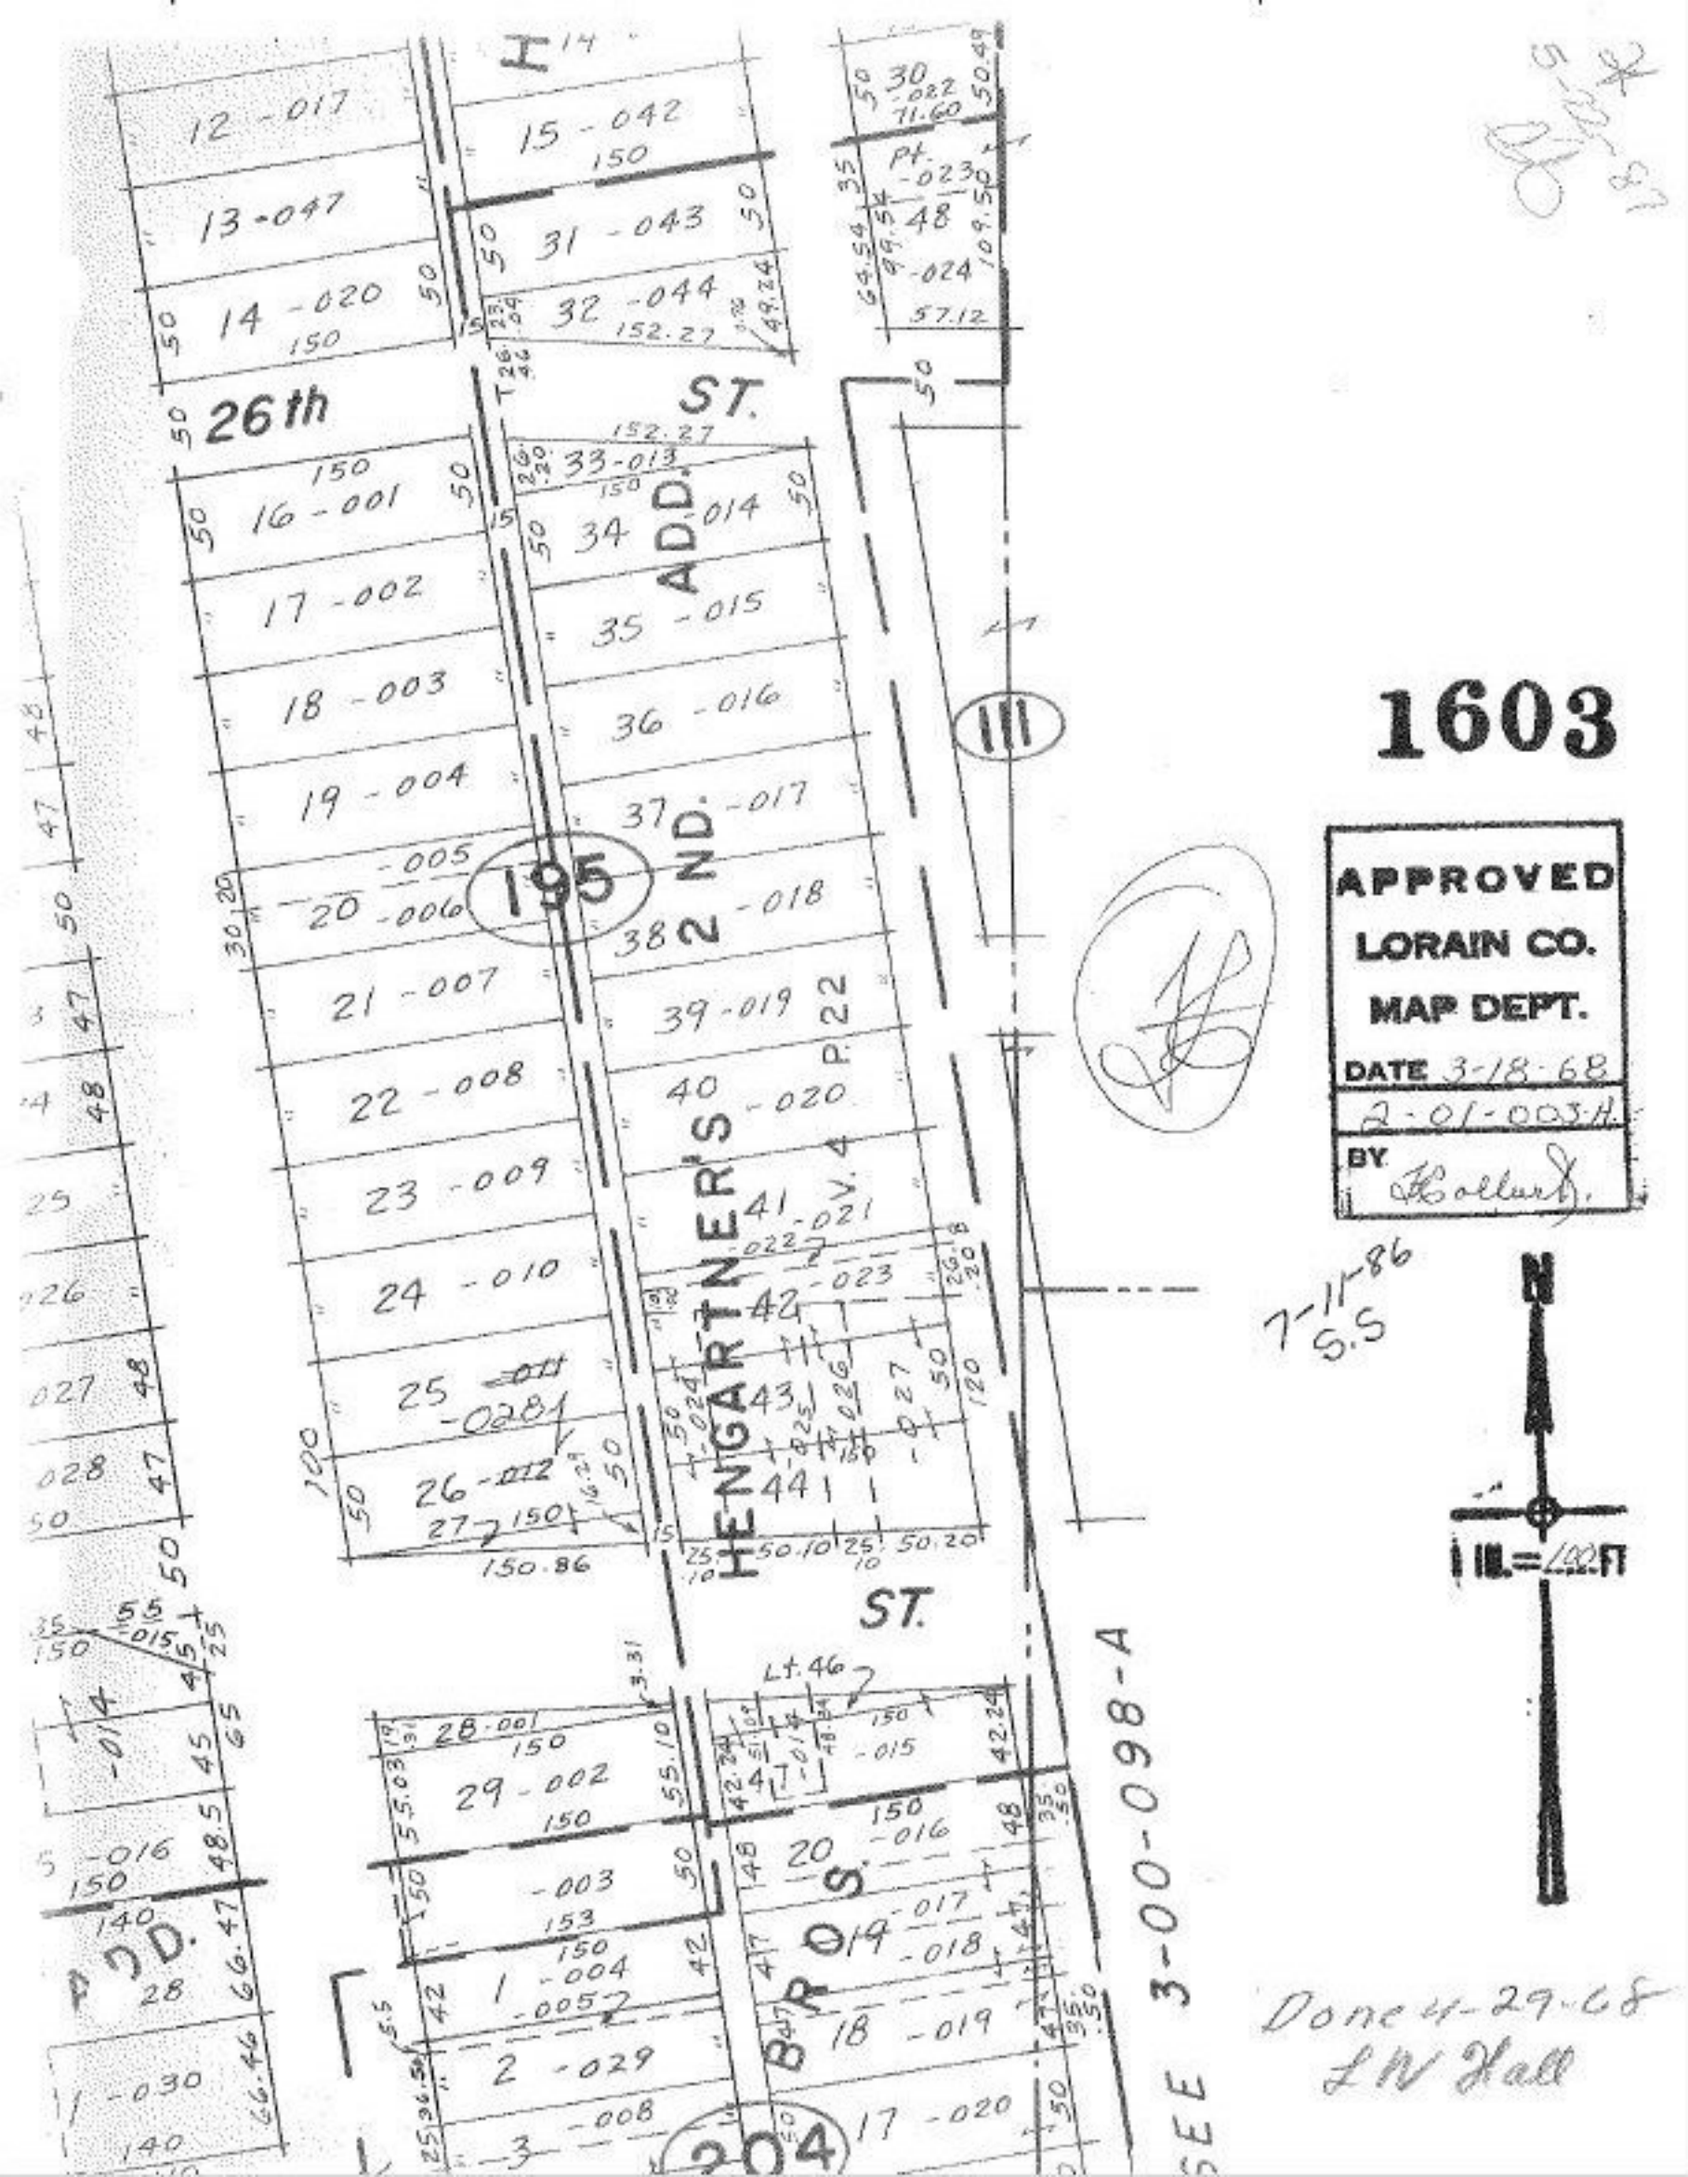
1603
APPROVED
LORAIN CO.
MAP DEPT.
DATE 3-18-68
2-01-003.H.
BY
7-11-86
S.S
N
Done 4-29-68
L W Hall
3-00-098-A
26th ST.
ADD.
HENGARTNER'S
ST.
195
204
111
P.O.