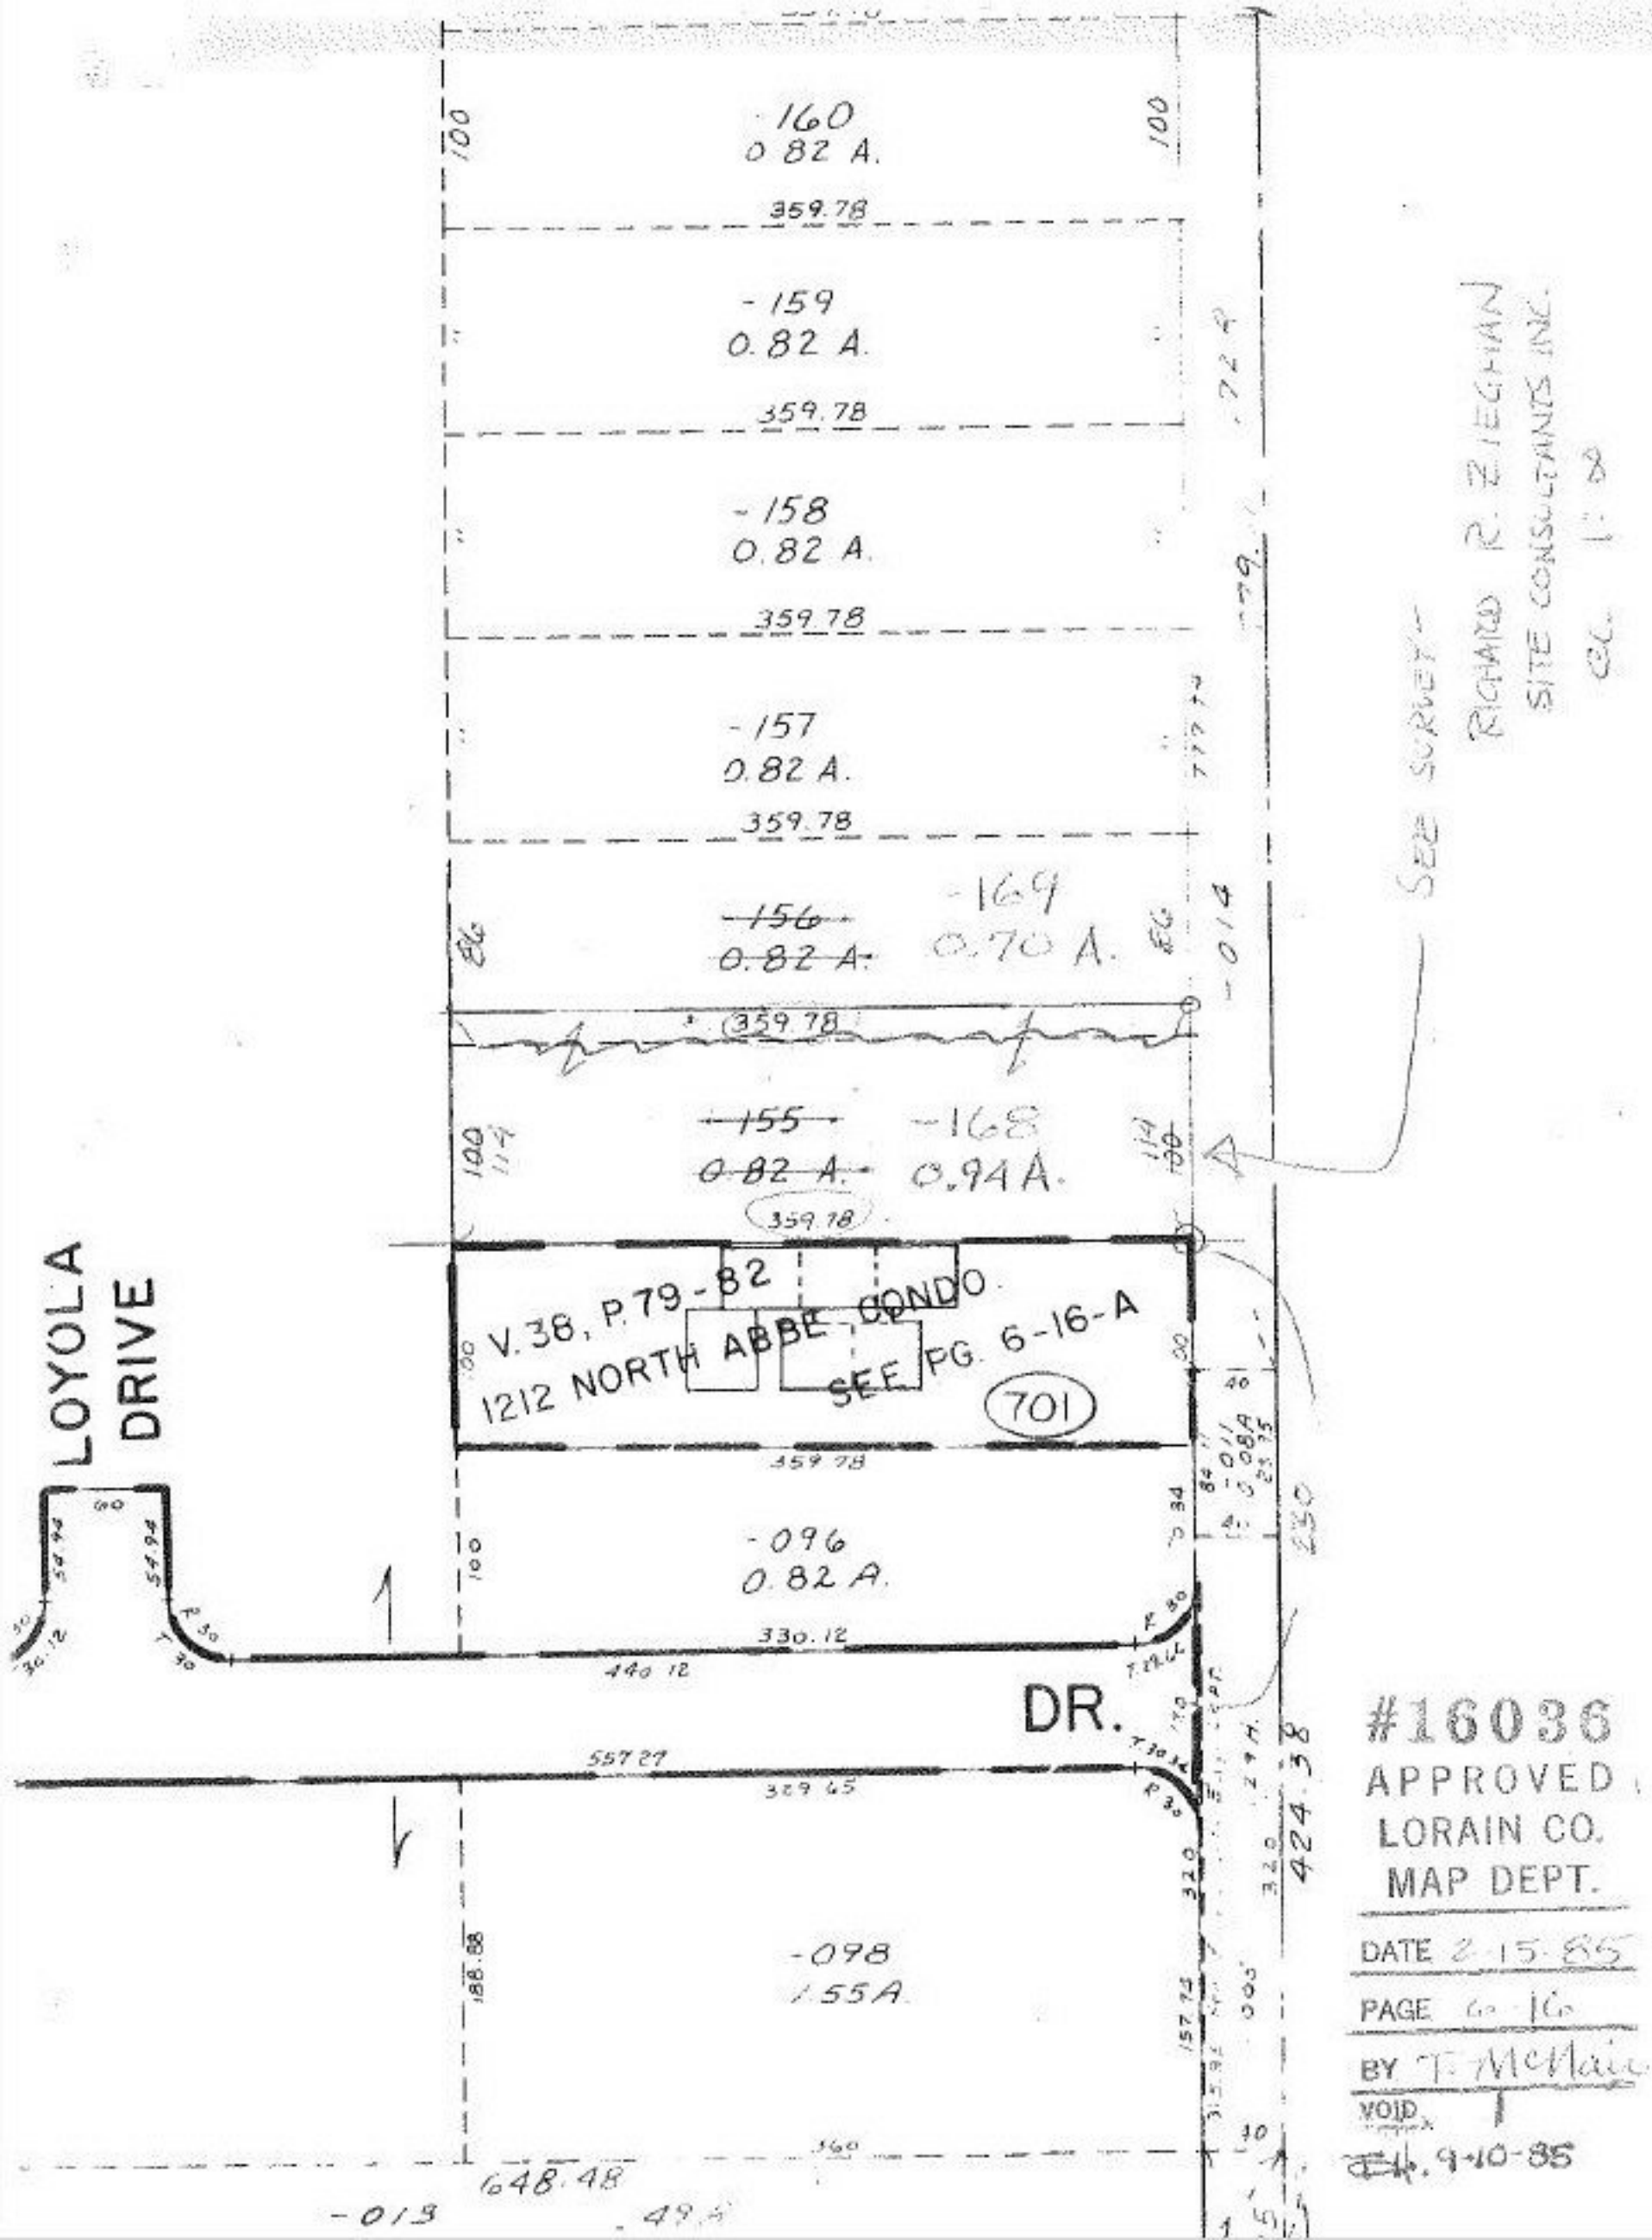

#16036
APPROVED
LORAIN CO.
MAP DEPT.
DATE 2-15-85
PAGE 6-16
BY T. McNair
VOID
9-10-85