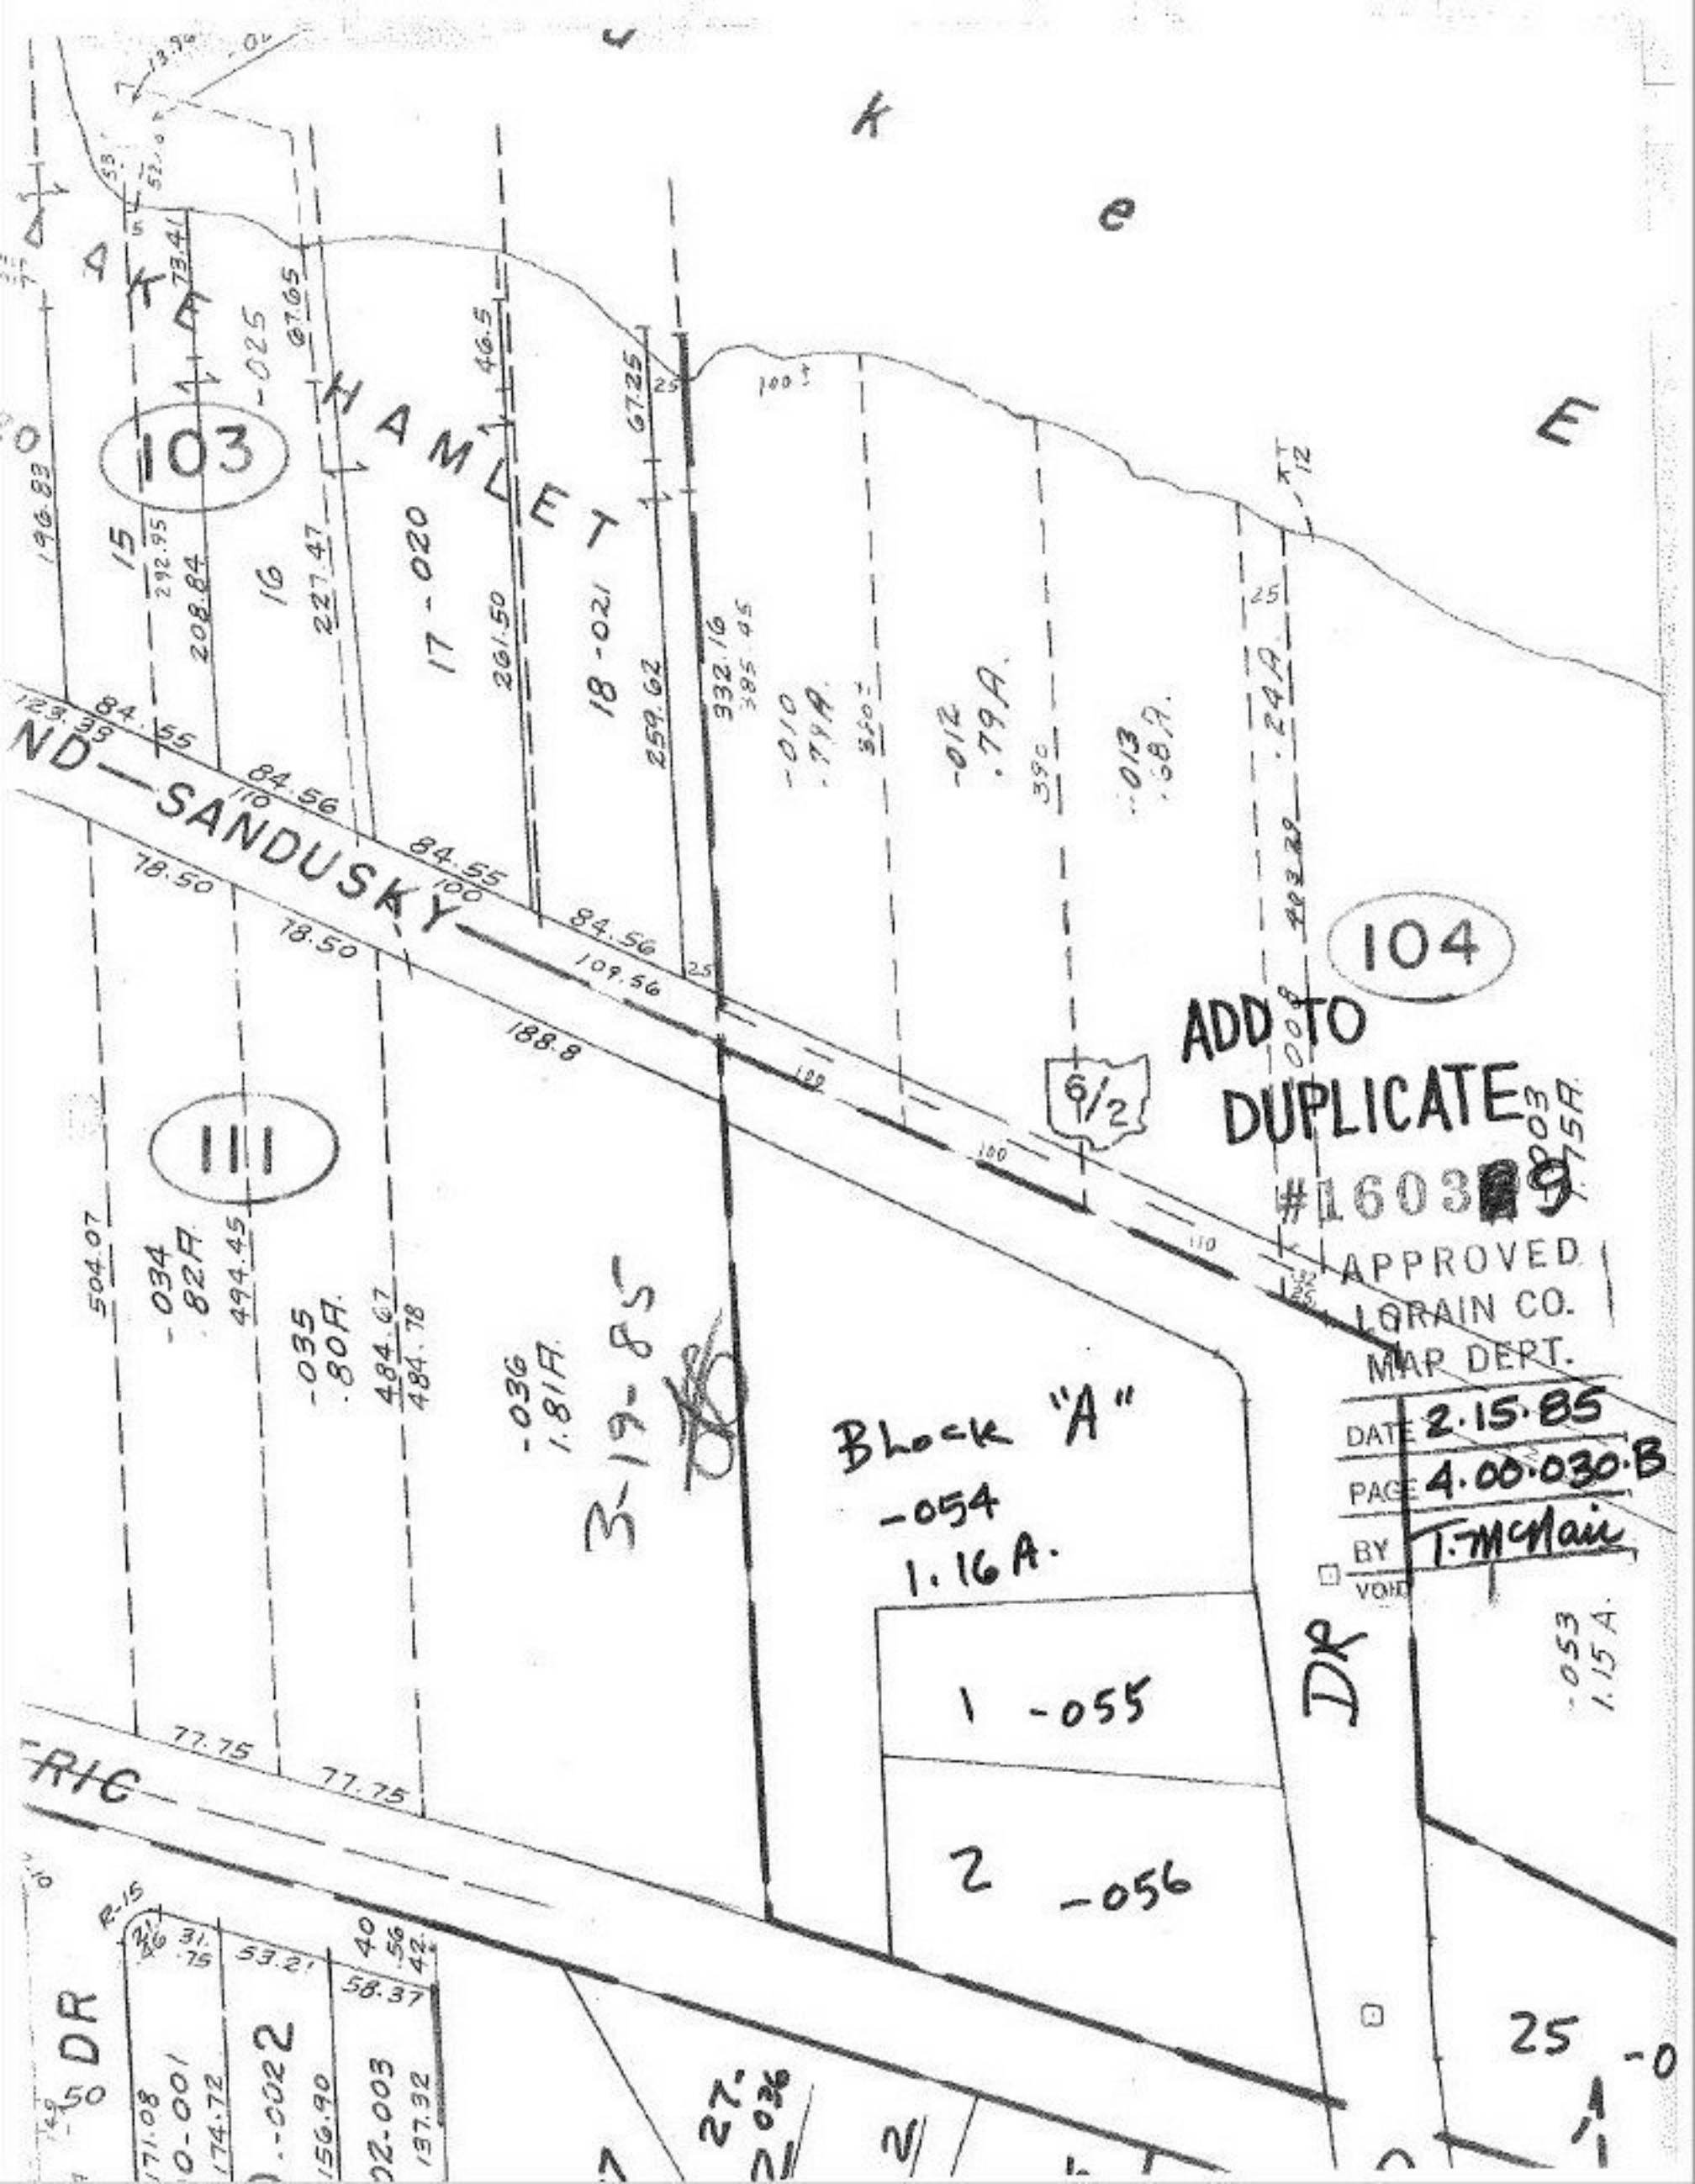
HAMLET
103
104
17-020
18-021
-025
-010 .79A.
-012 .79A.
-013 .68A.
-034 .82A.
-035 .80A.
-036 1.81A.
-054 1.16A.
-055
-056
-053 1.15A.
Block "A"
SANDUSKY
ADD TO
DUPLICATE
#160389
APPROVED
LORAIN CO.
MAP DEPT.
DATE 2.15.85
PAGE 4.00.030.B
BY T.McNair
VOID
DR
R/C