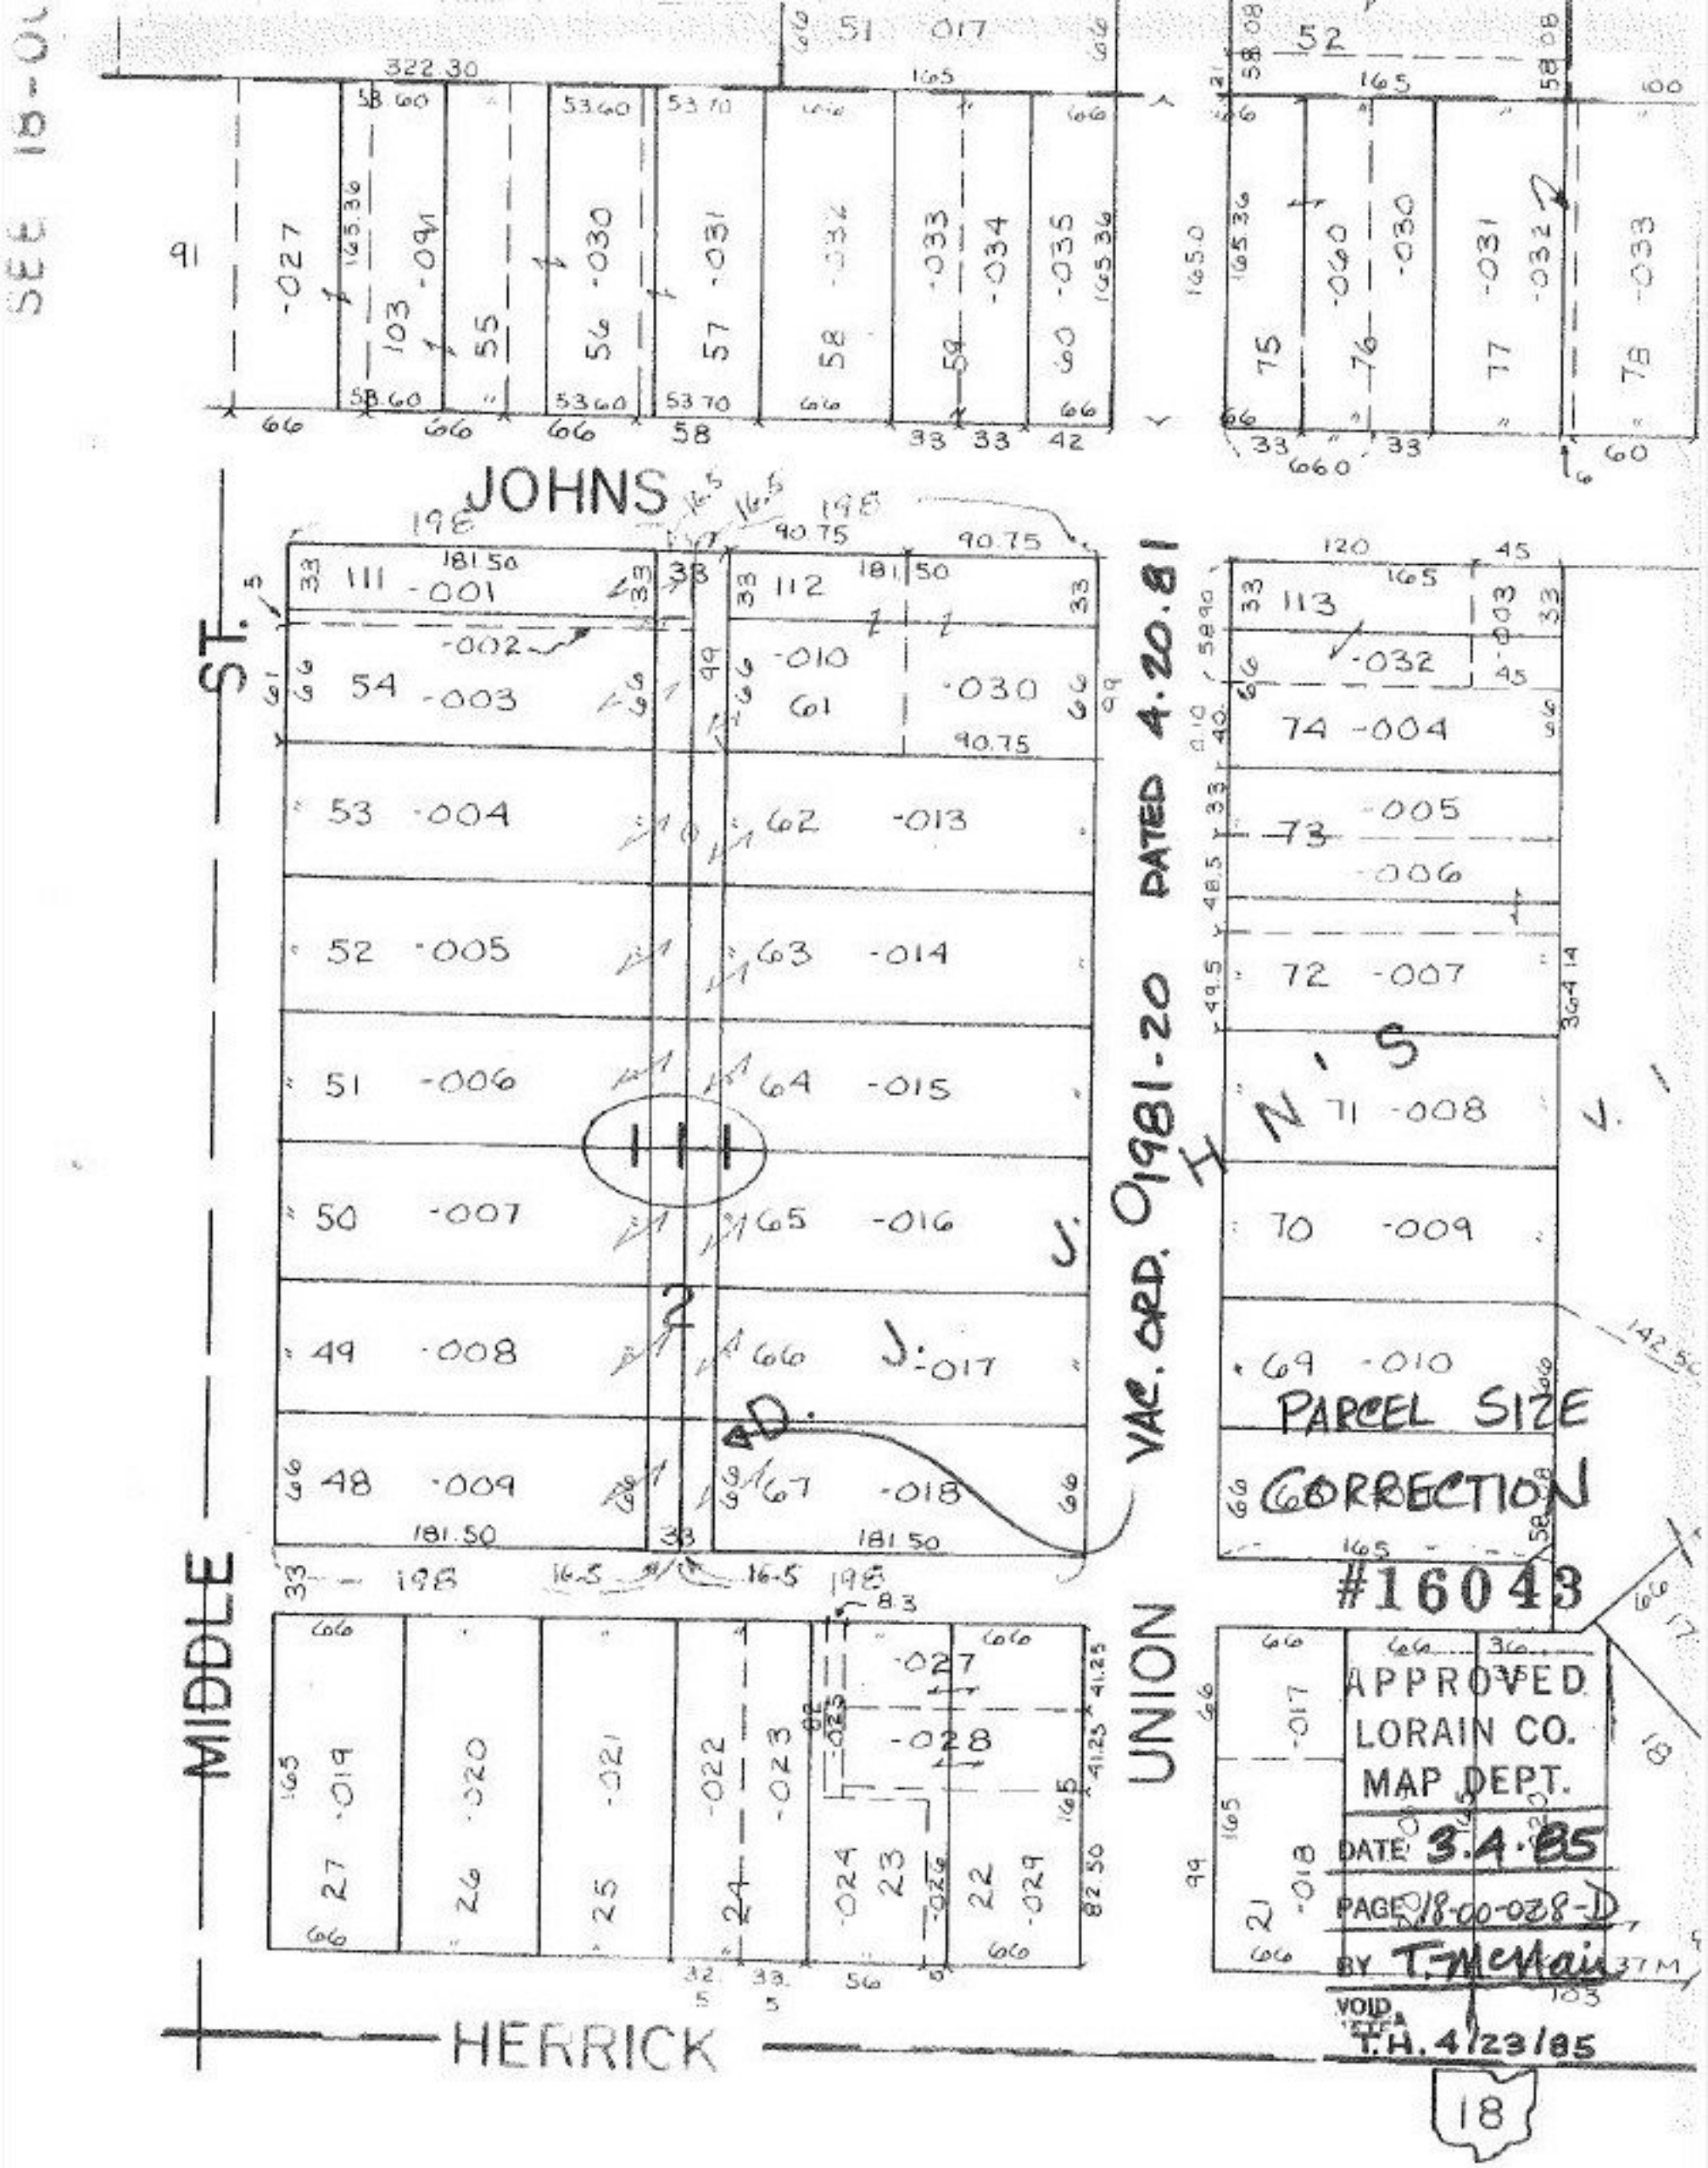
SEE 18-00
JOHNS
ST.
MIDDLE
UNION
HERRICK
VAC. ORD. 0 1981-20 DATED 4.20.81
PARCEL SIZE CORRECTION
#16043
APPROVED
LORAIN CO.
MAP DEPT.
DATE 3.4.85
PAGE 18-00-028-D
BY T. McNair
VOID
T.H. 4/23/85
18