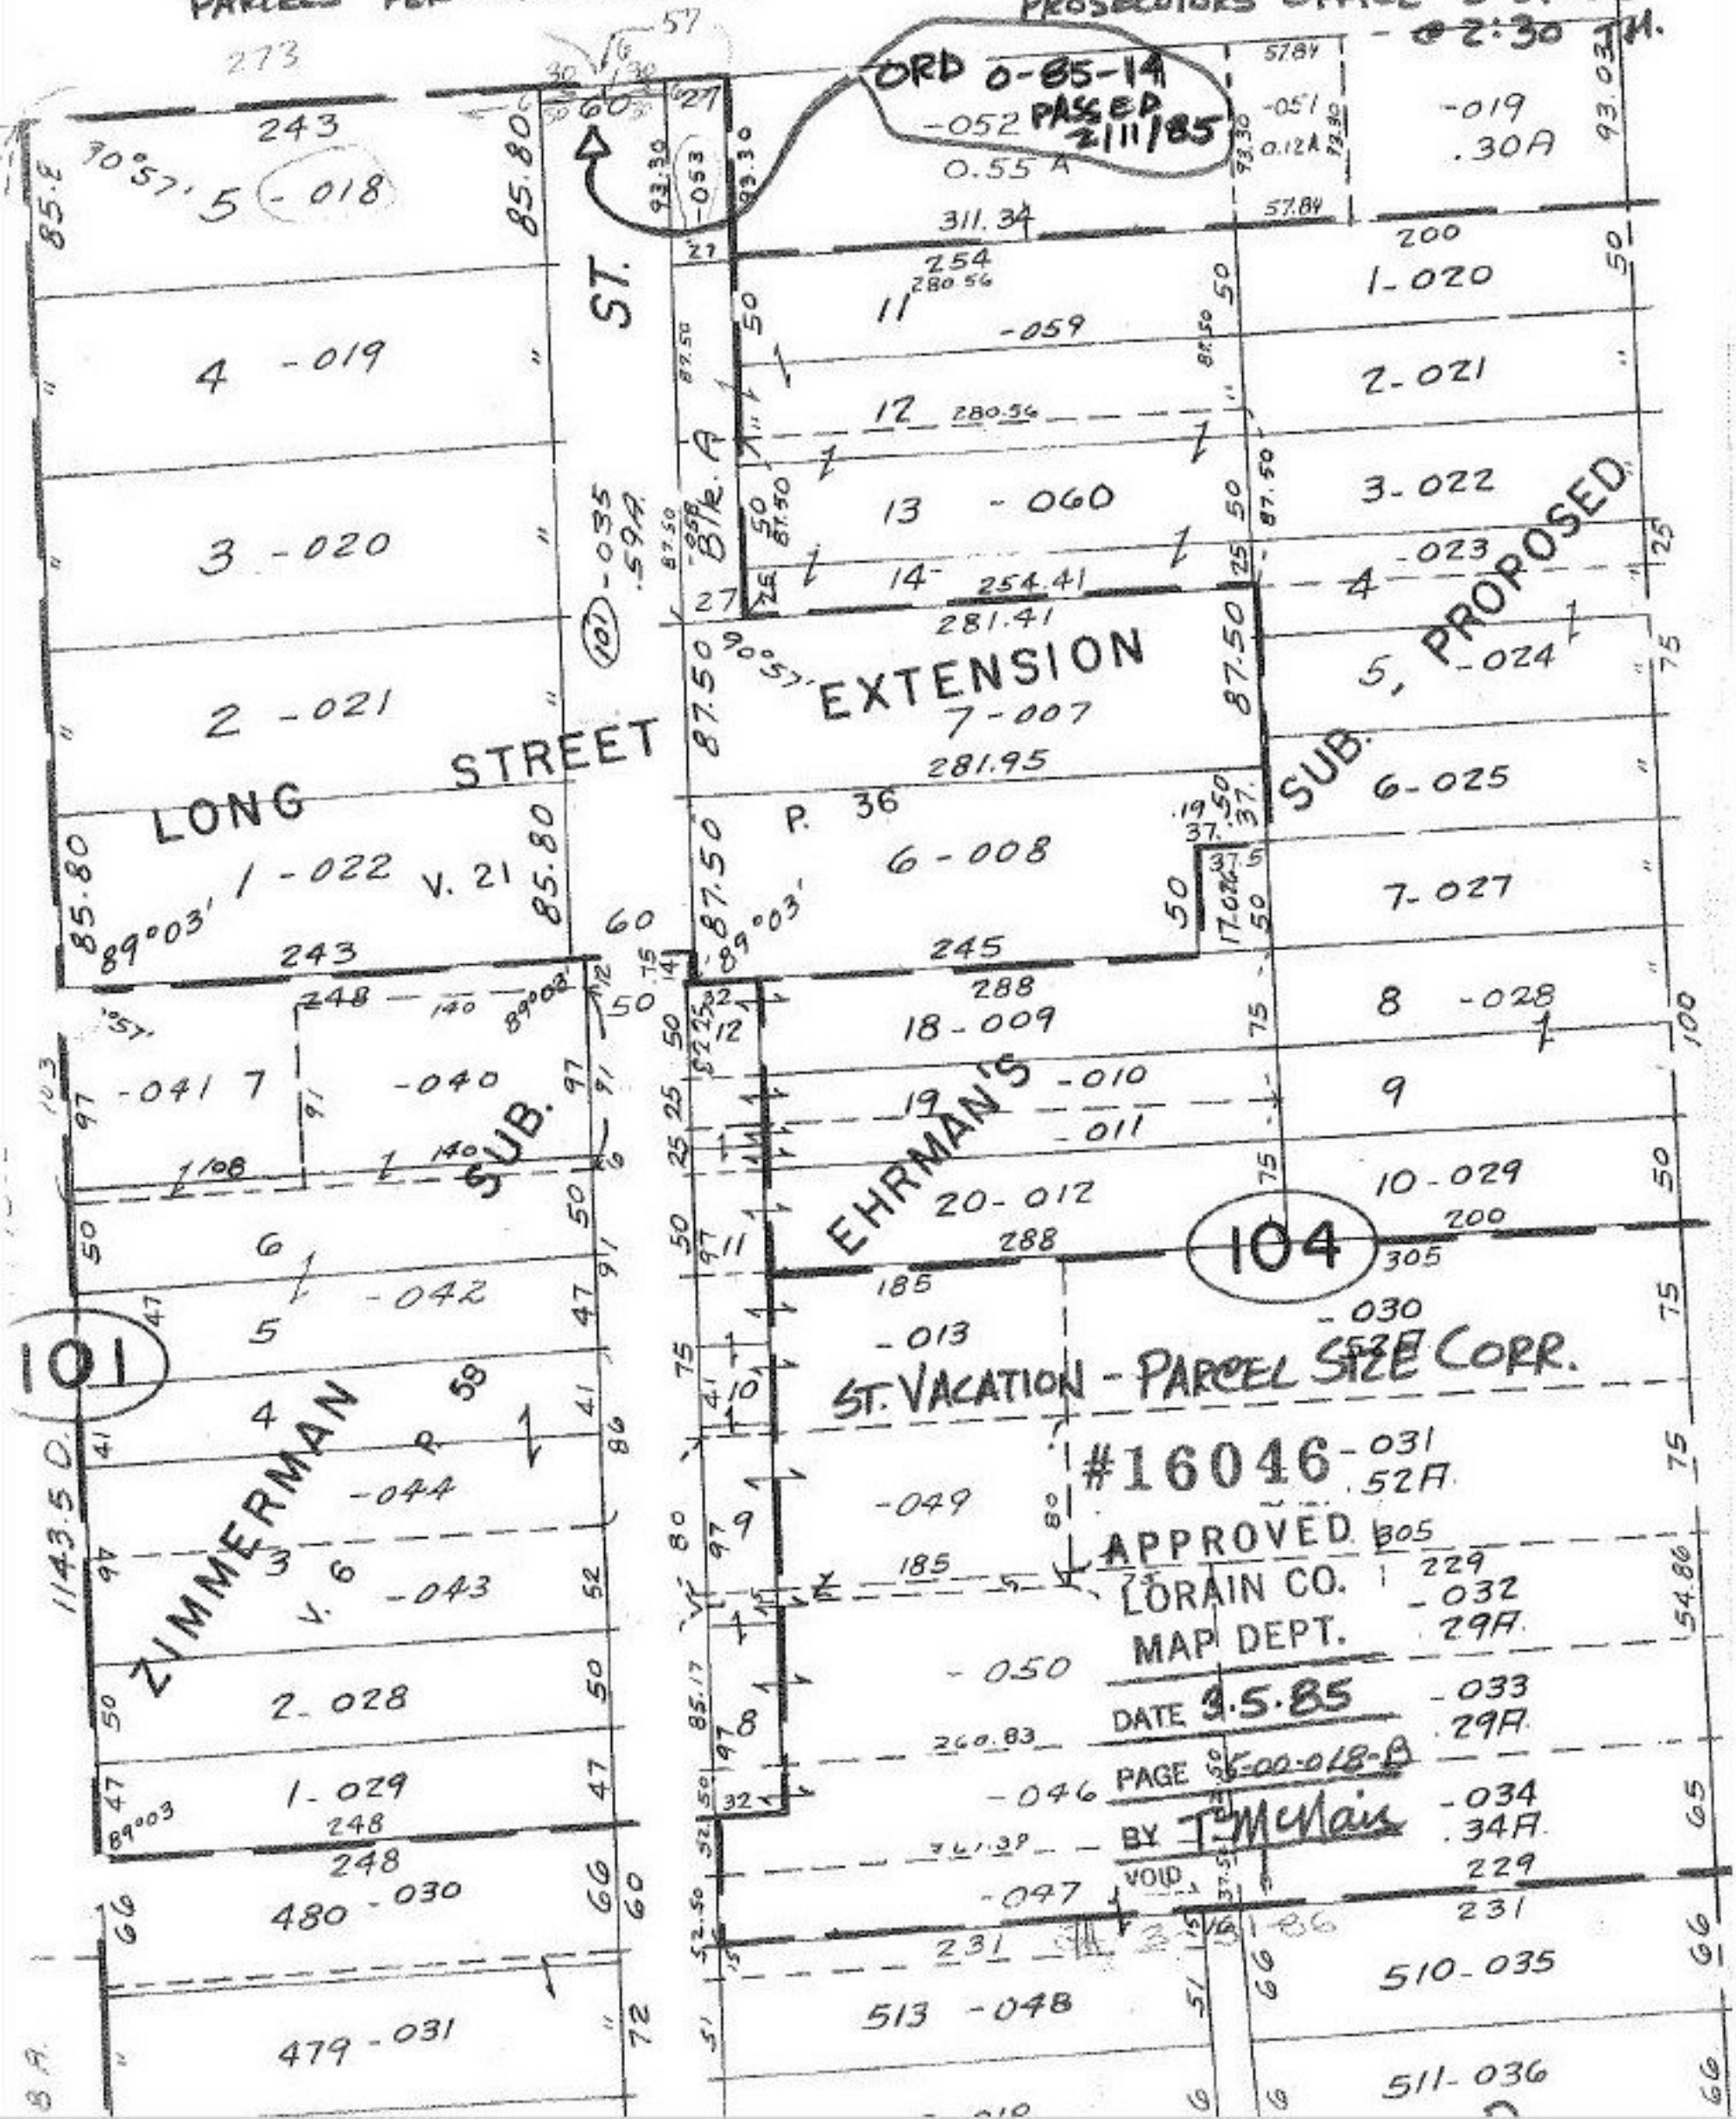T. VACATION ONLY AFFECTS -053 & 018 AND NO OTHER ADJOINING PARCELS PER CONVERSATION WITH JOHN KERESCI, LORAIN COUNTY PROSECUTORS OFFICE 2·21·85 @ 2:30 PM.