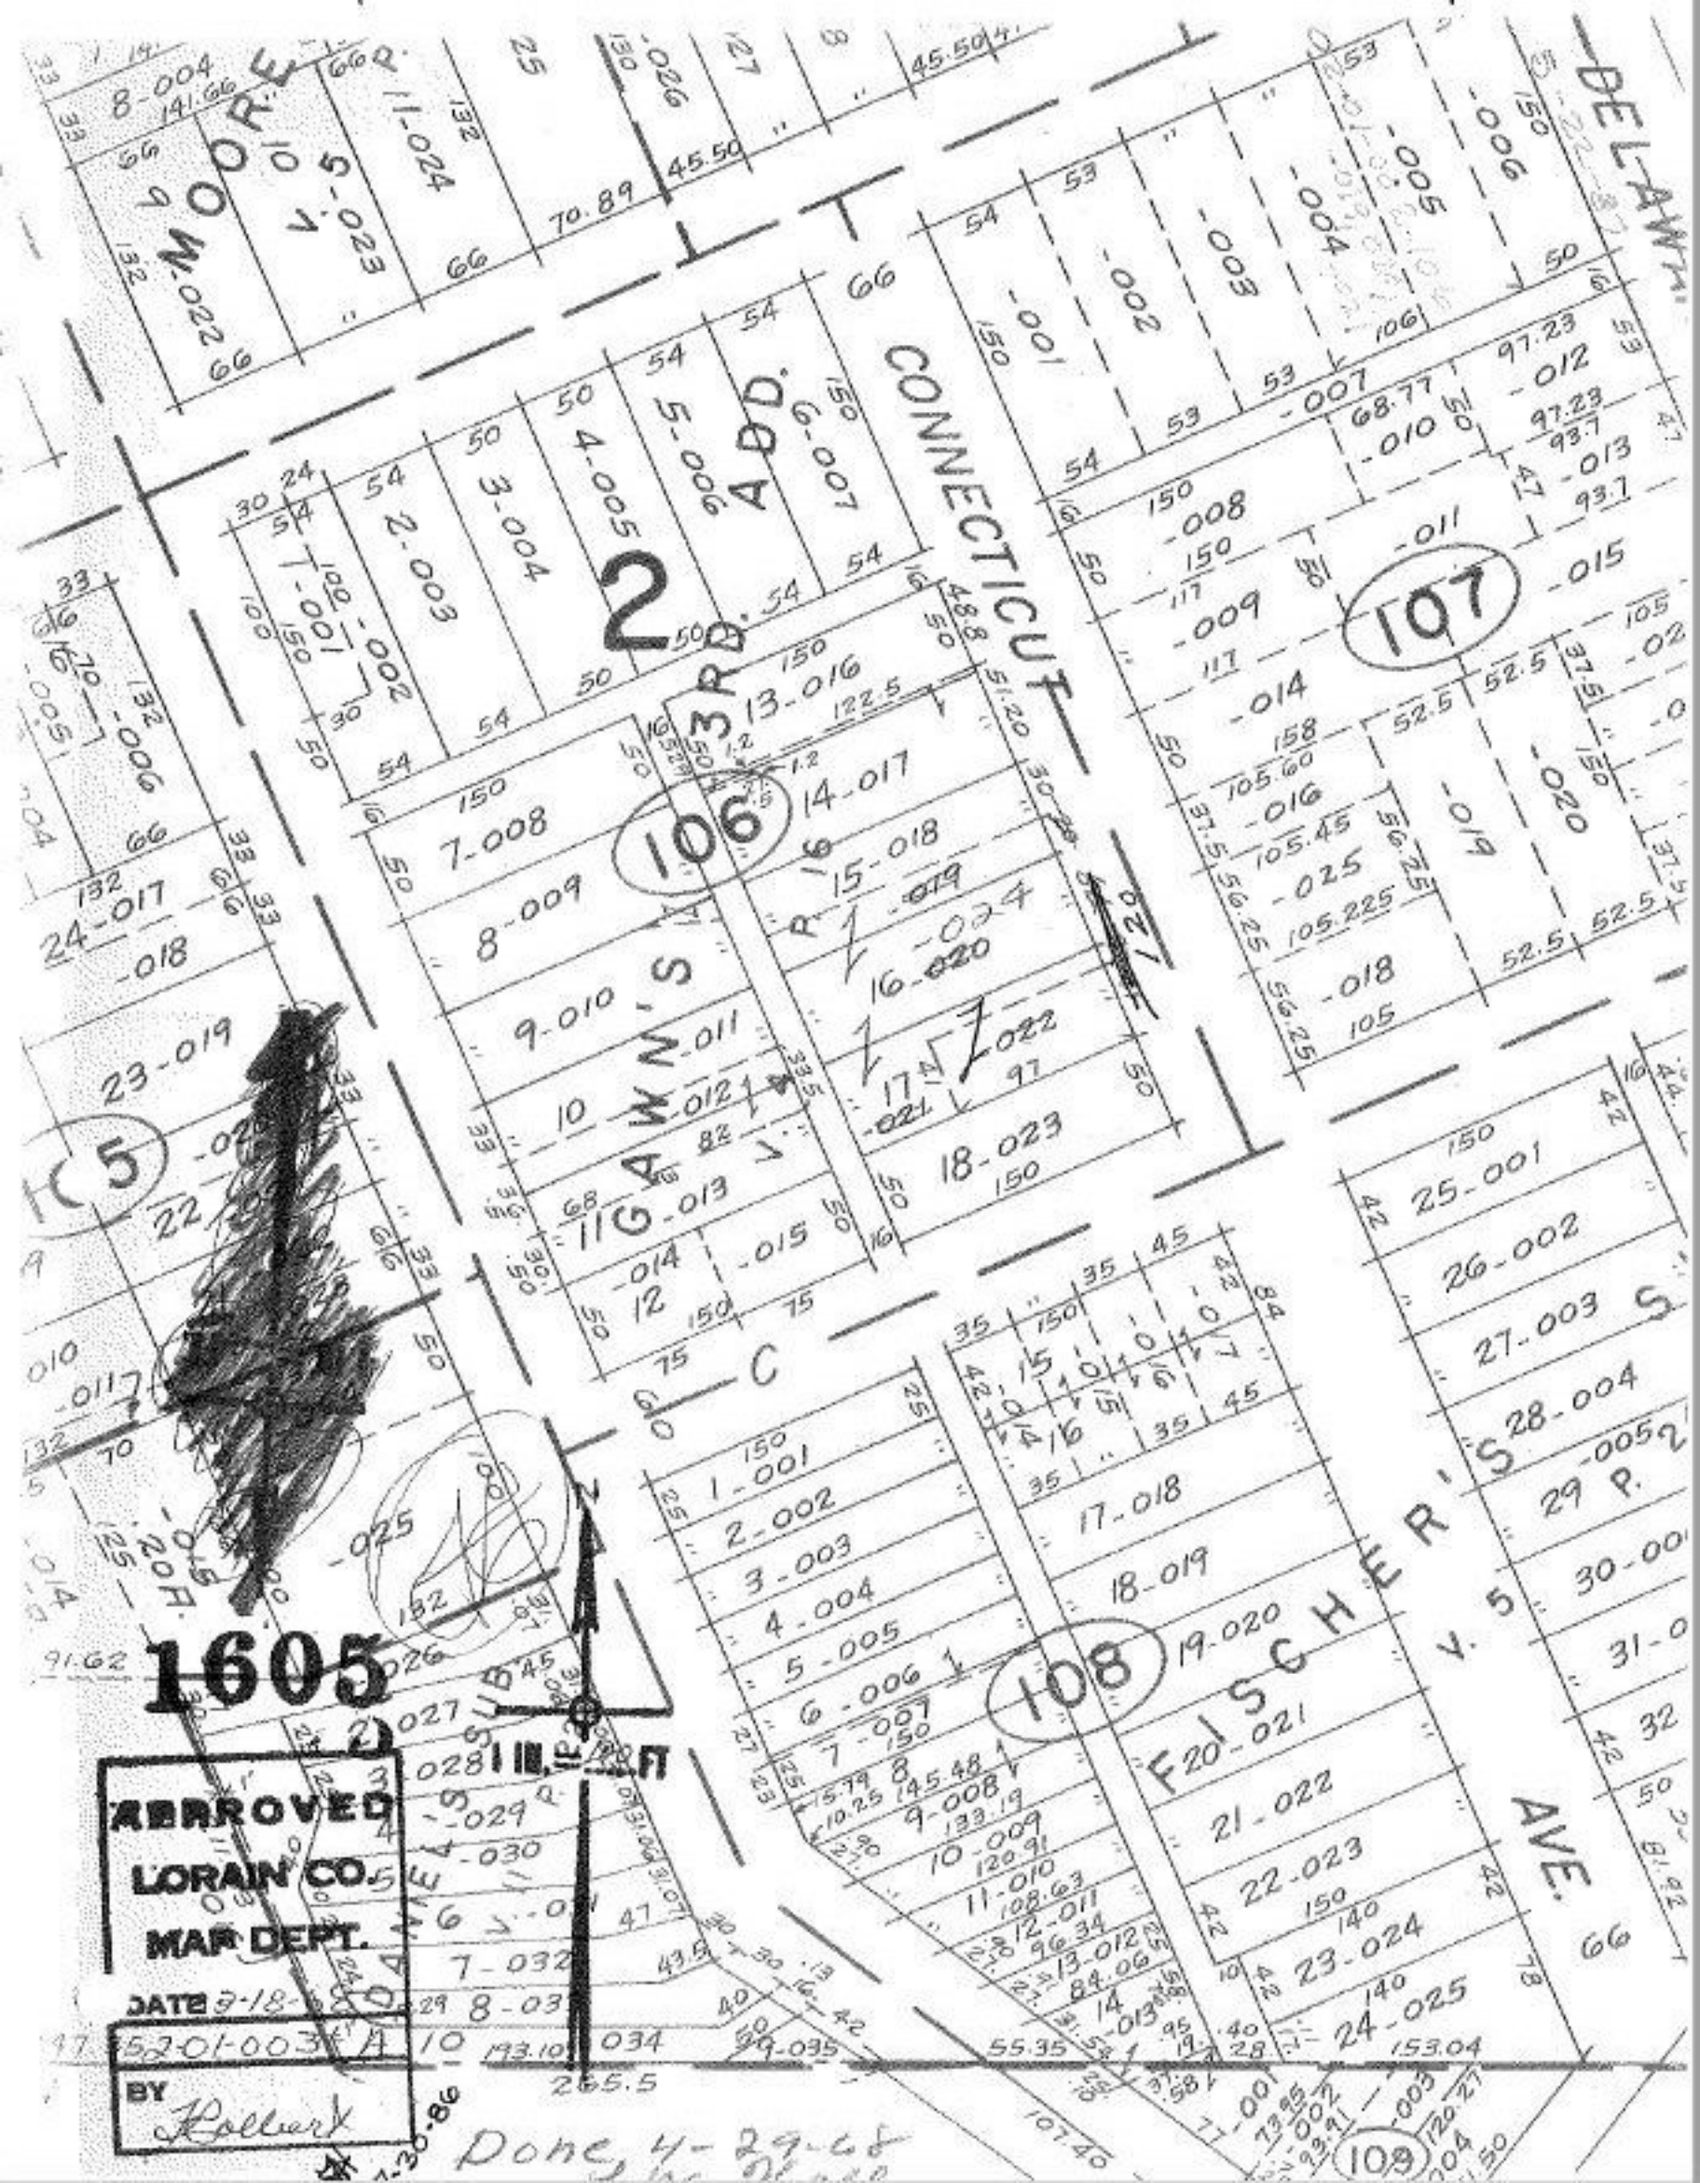

MOORE
CONNECTICUT
GAWN'S 3RD. ADD.
FISCHER'S
AVE.
DELAWA
1605
APPROVED
LORAIN CO.
MAP DEPT.
DATE 3-18-68
BY
Done, 4-29-68