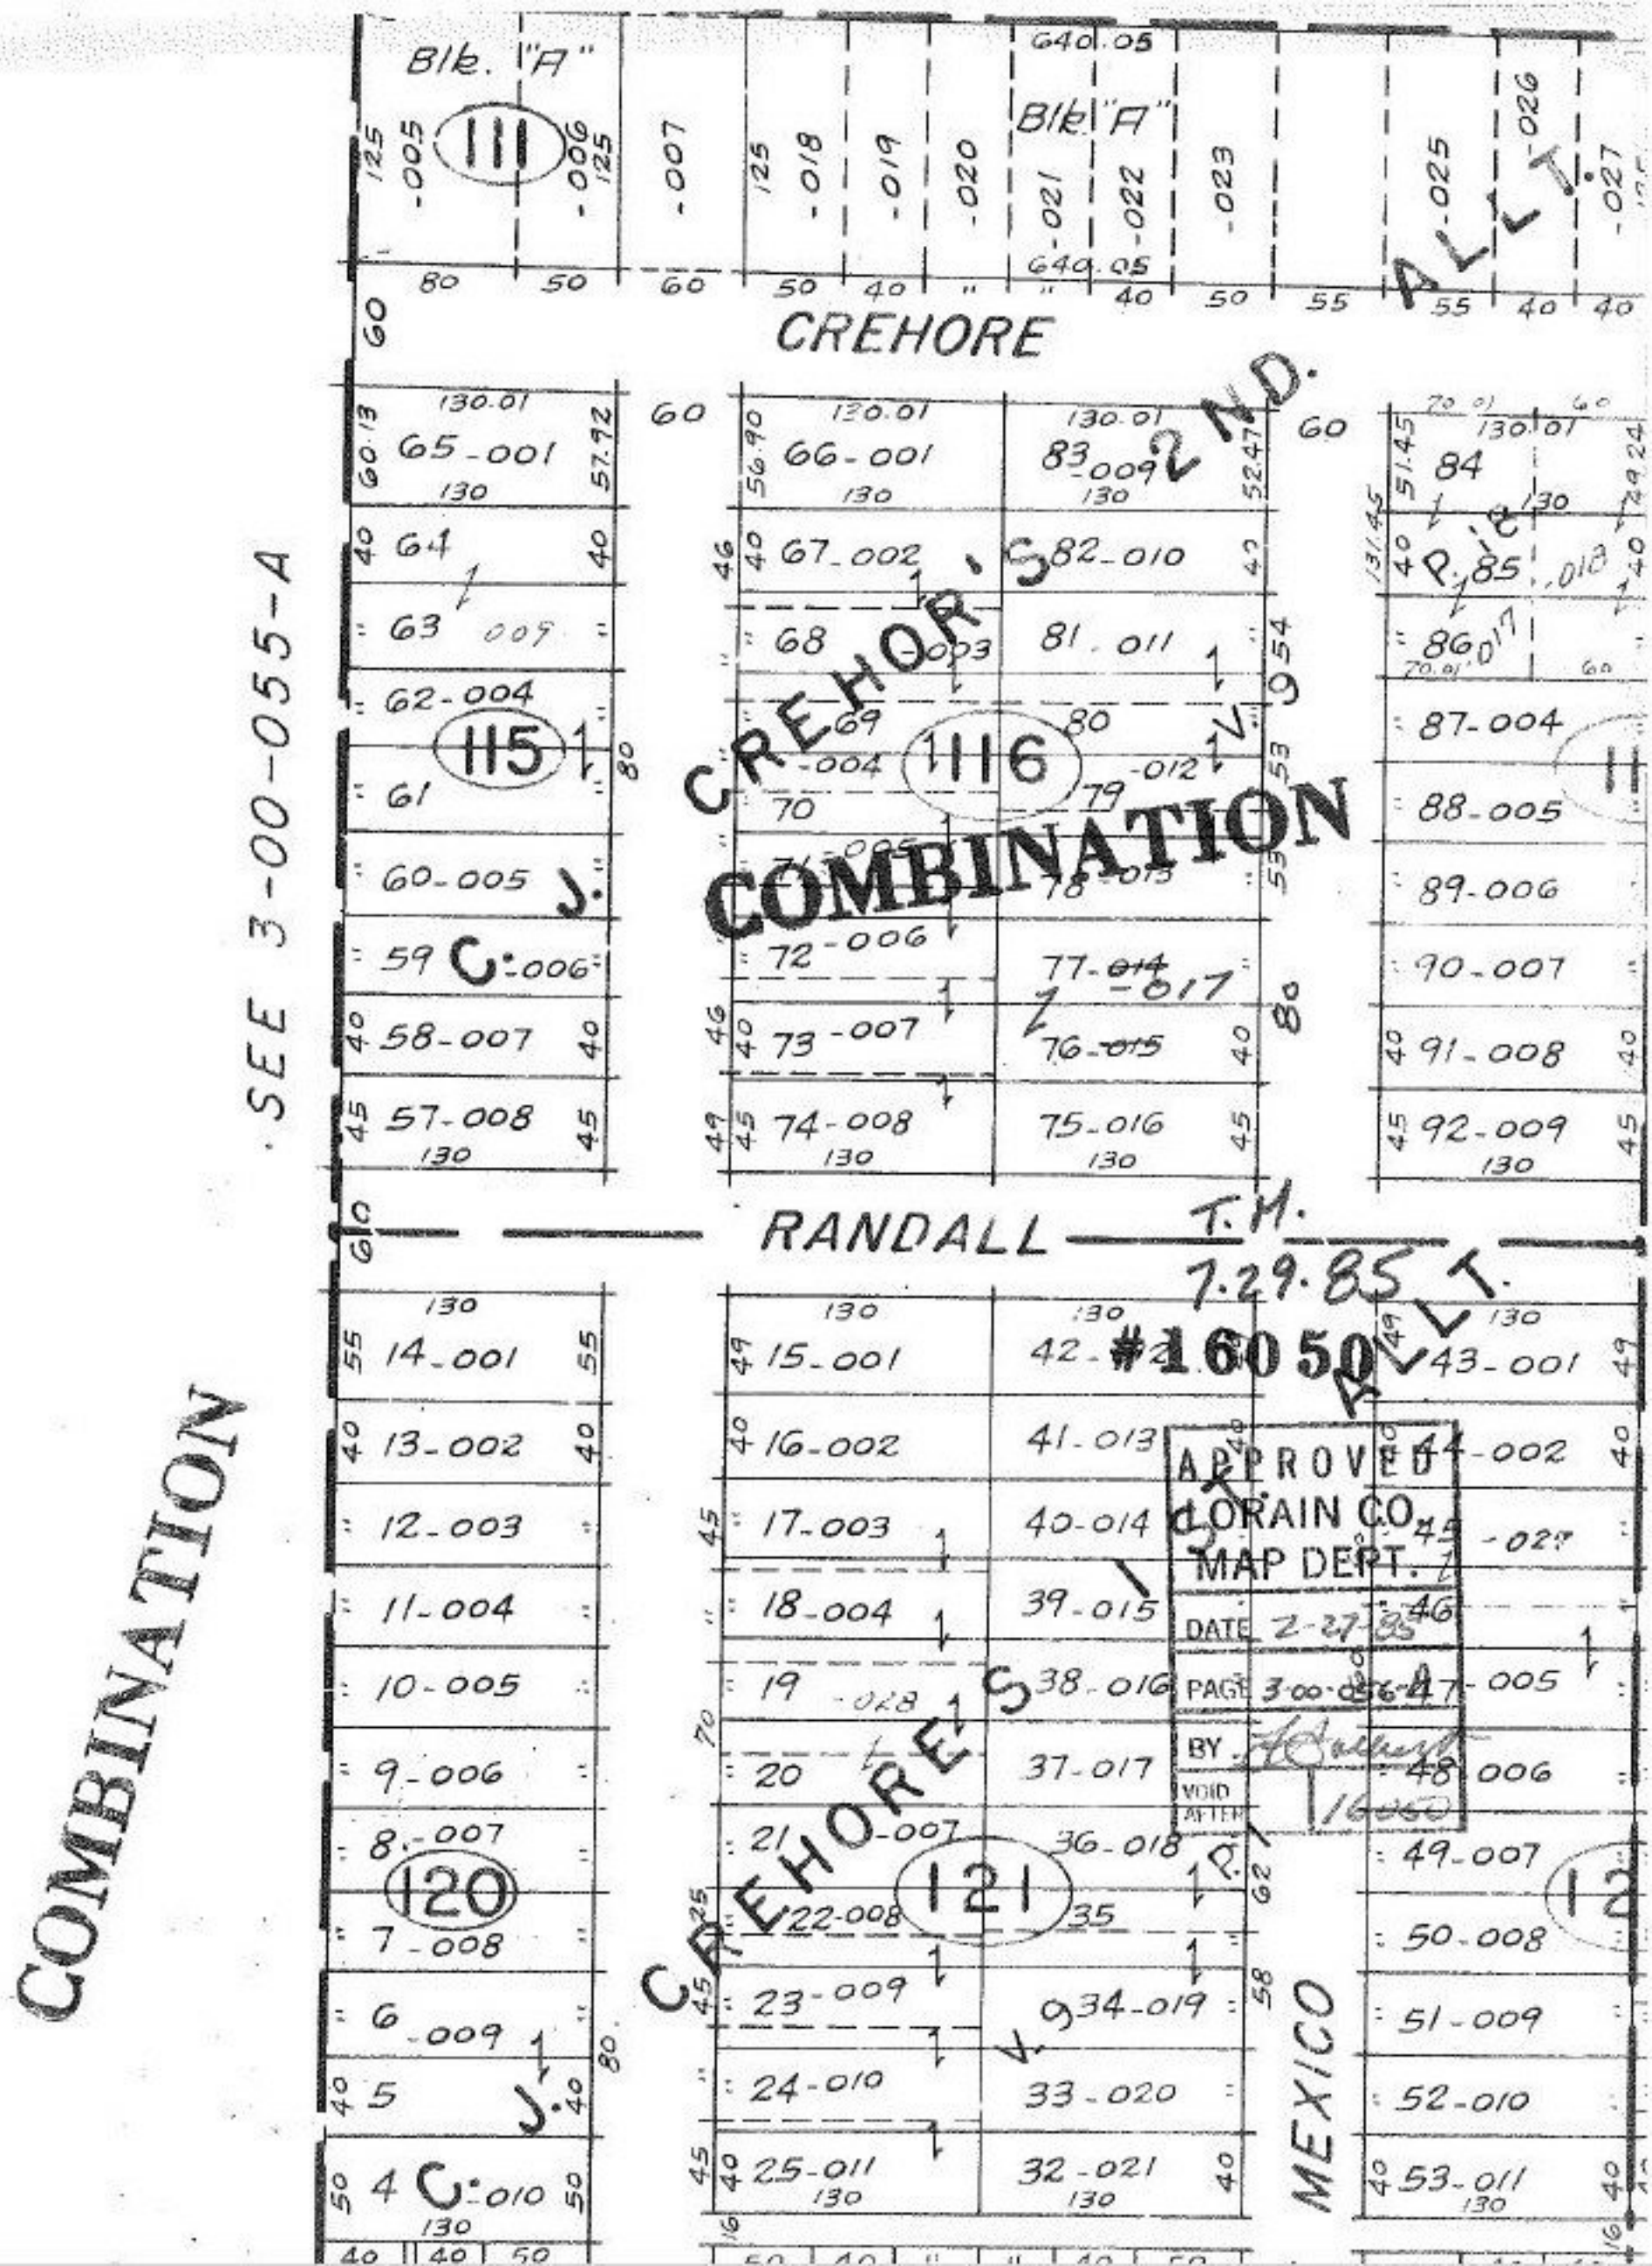

Blk. "A"
111
CREHORE
CREHOR'S 2ND. ALLT.
COMBINATION
115
116
RANDALL
T.M.
7.29.85
#16050
CREHORE'S 1ST. ALLT.
120
121
MEXICO
SEE 3-00-055-A
COMBINATION
APPROVED
LORAIN CO.
MAP DEPT.
DATE 2-27-85
PAGE 3-00-056-A
BY
VOID AFTER 16050