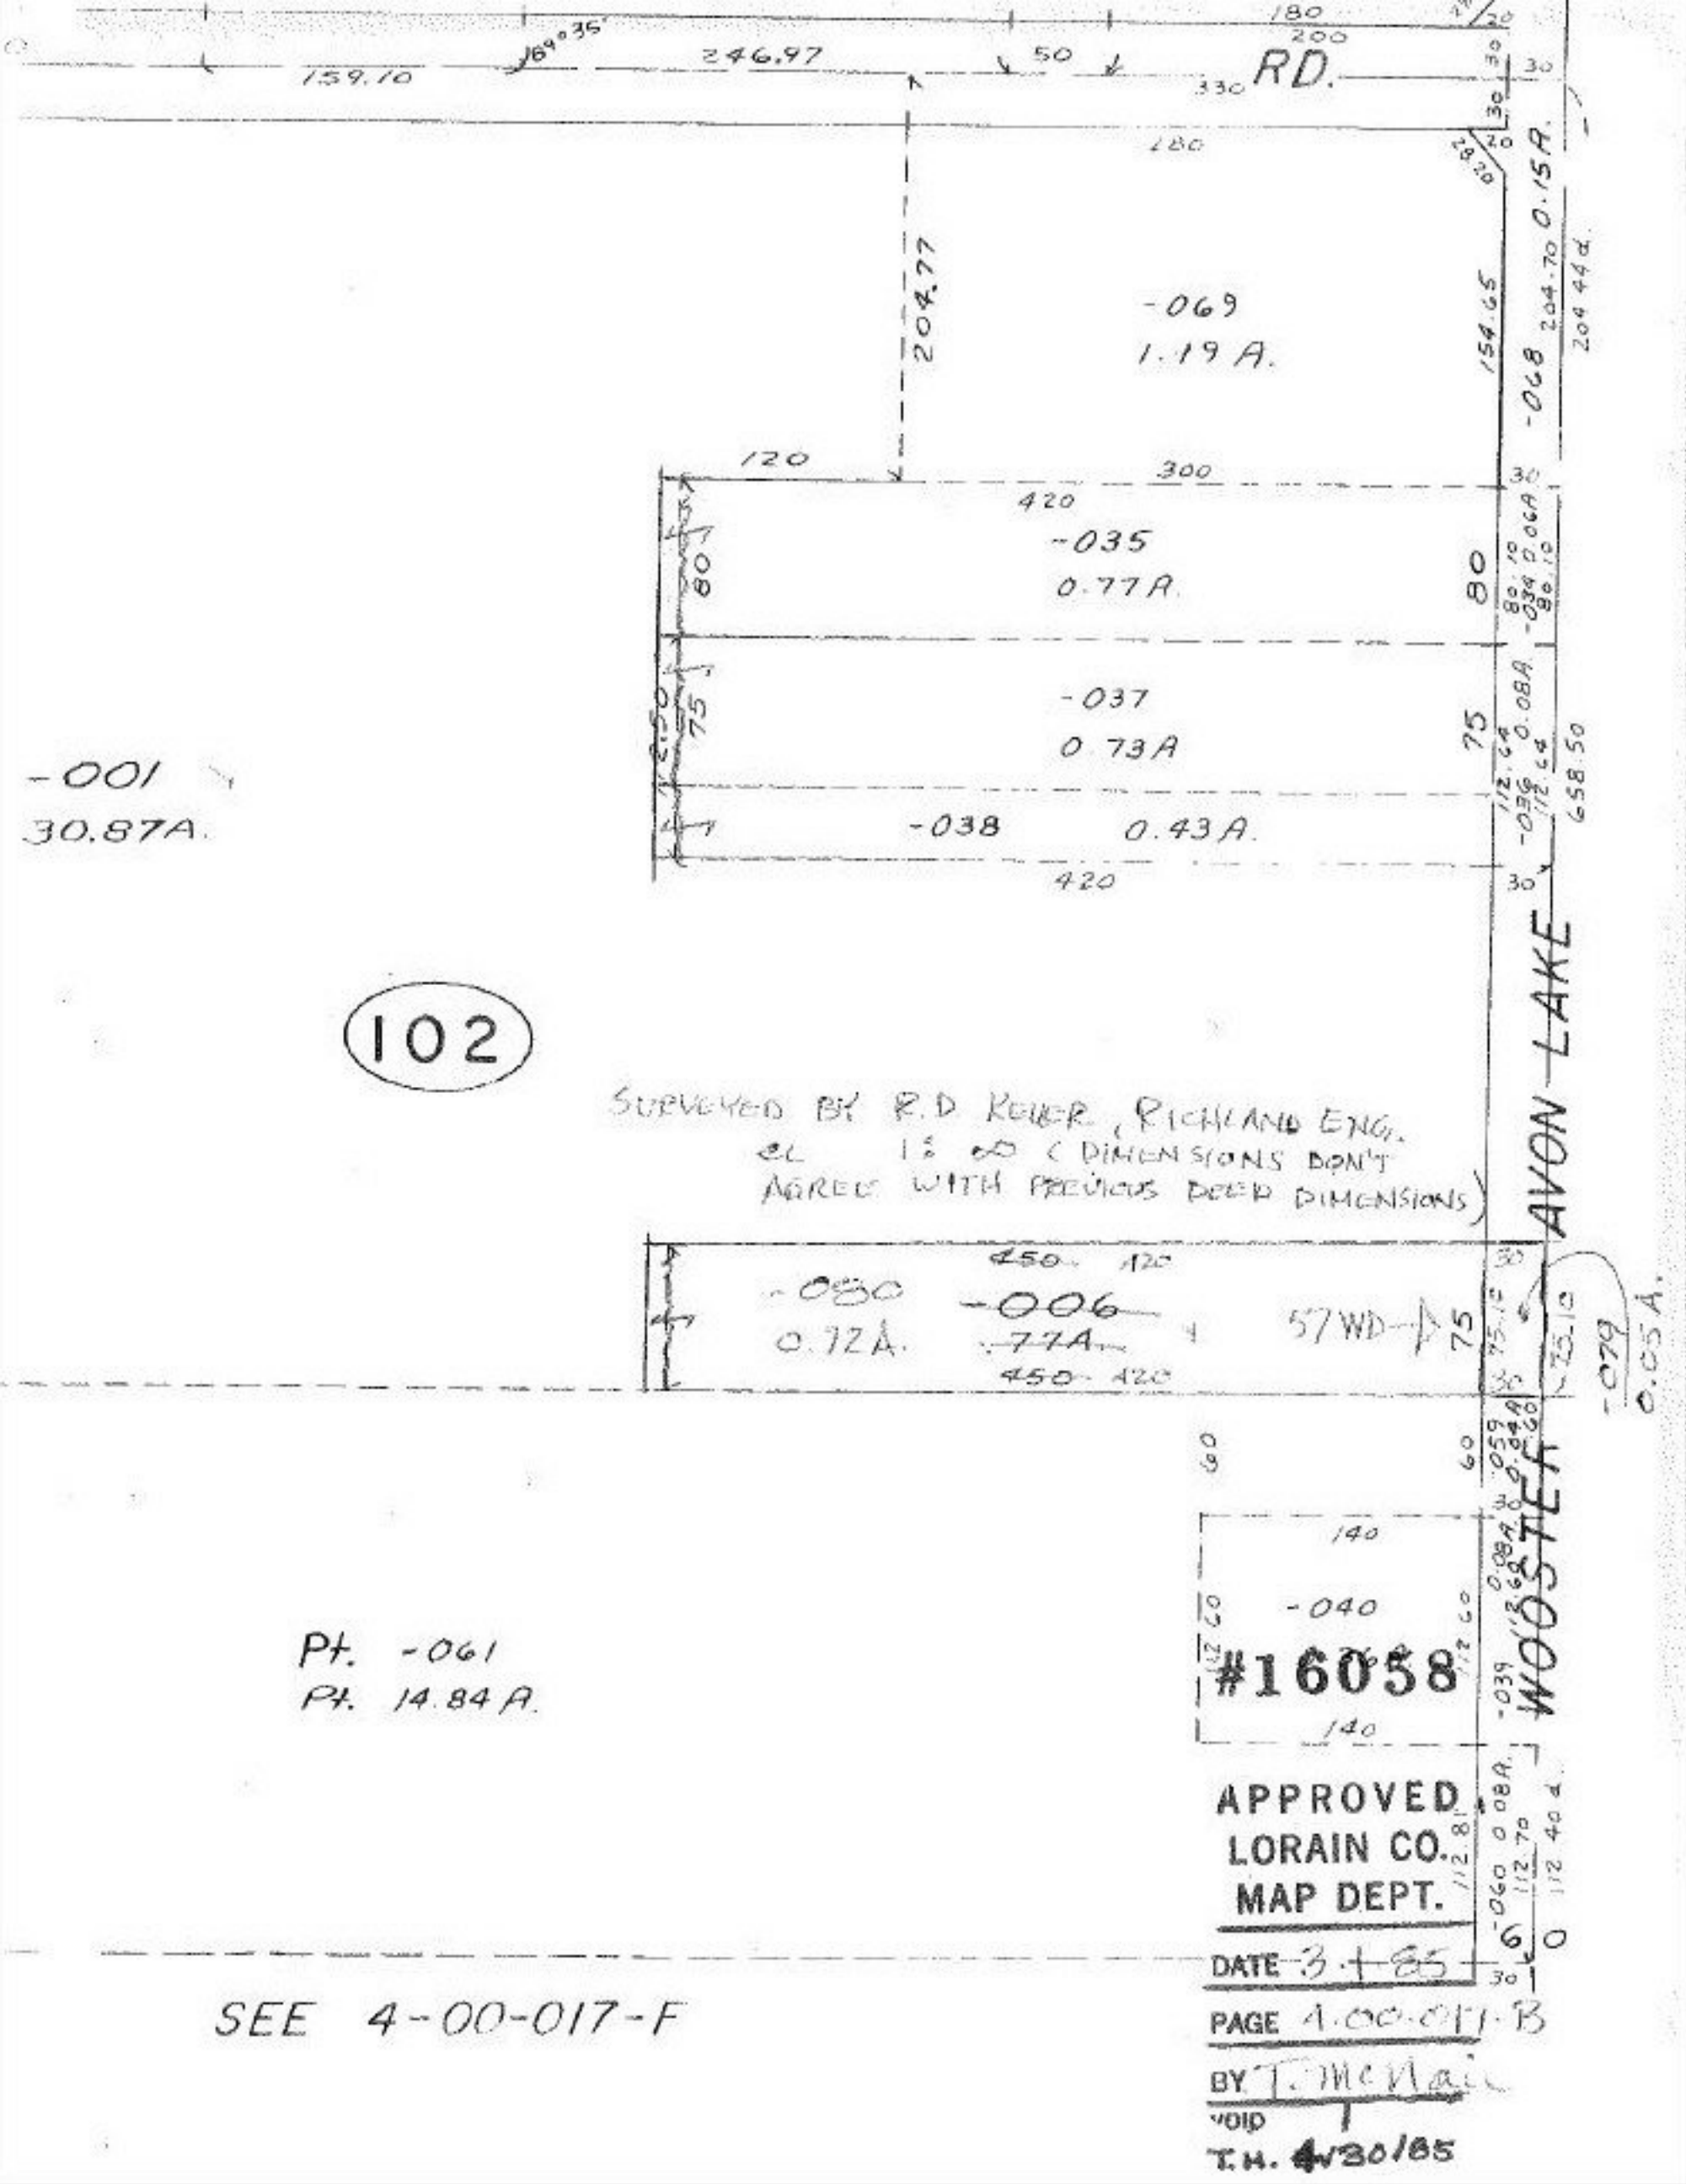

159.10
246.97
50
180
200
330
RD.
280
204.77
-069
1.19 A.
154.65
-068
0.15 A.
204.70
204.44 d.
120
300
420
-035
0.77 A.
80
-037
0.73 A
75
-038
0.43 A.
420
-001
30.87A.
102
SURVEYED BY R.D. KEUER, RICHLAND ENG.
CL 1:∞ (DIMENSIONS DON'T
AGREE WITH PREVIOUS DEED DIMENSIONS)
AVON LAKE
-080
0.72 A.
-006
.77A
450
420
57 WD
75
-079
0.05 A.
WOOSTER
140
-040
#16058
140
Pt. -061
Pt. 14.84 A.
APPROVED
LORAIN CO.
MAP DEPT.
DATE 3-1-85
PAGE 4.00.017-B
BY T. McNair
VOID
T.H. 4/30/85
SEE 4-00-017-F