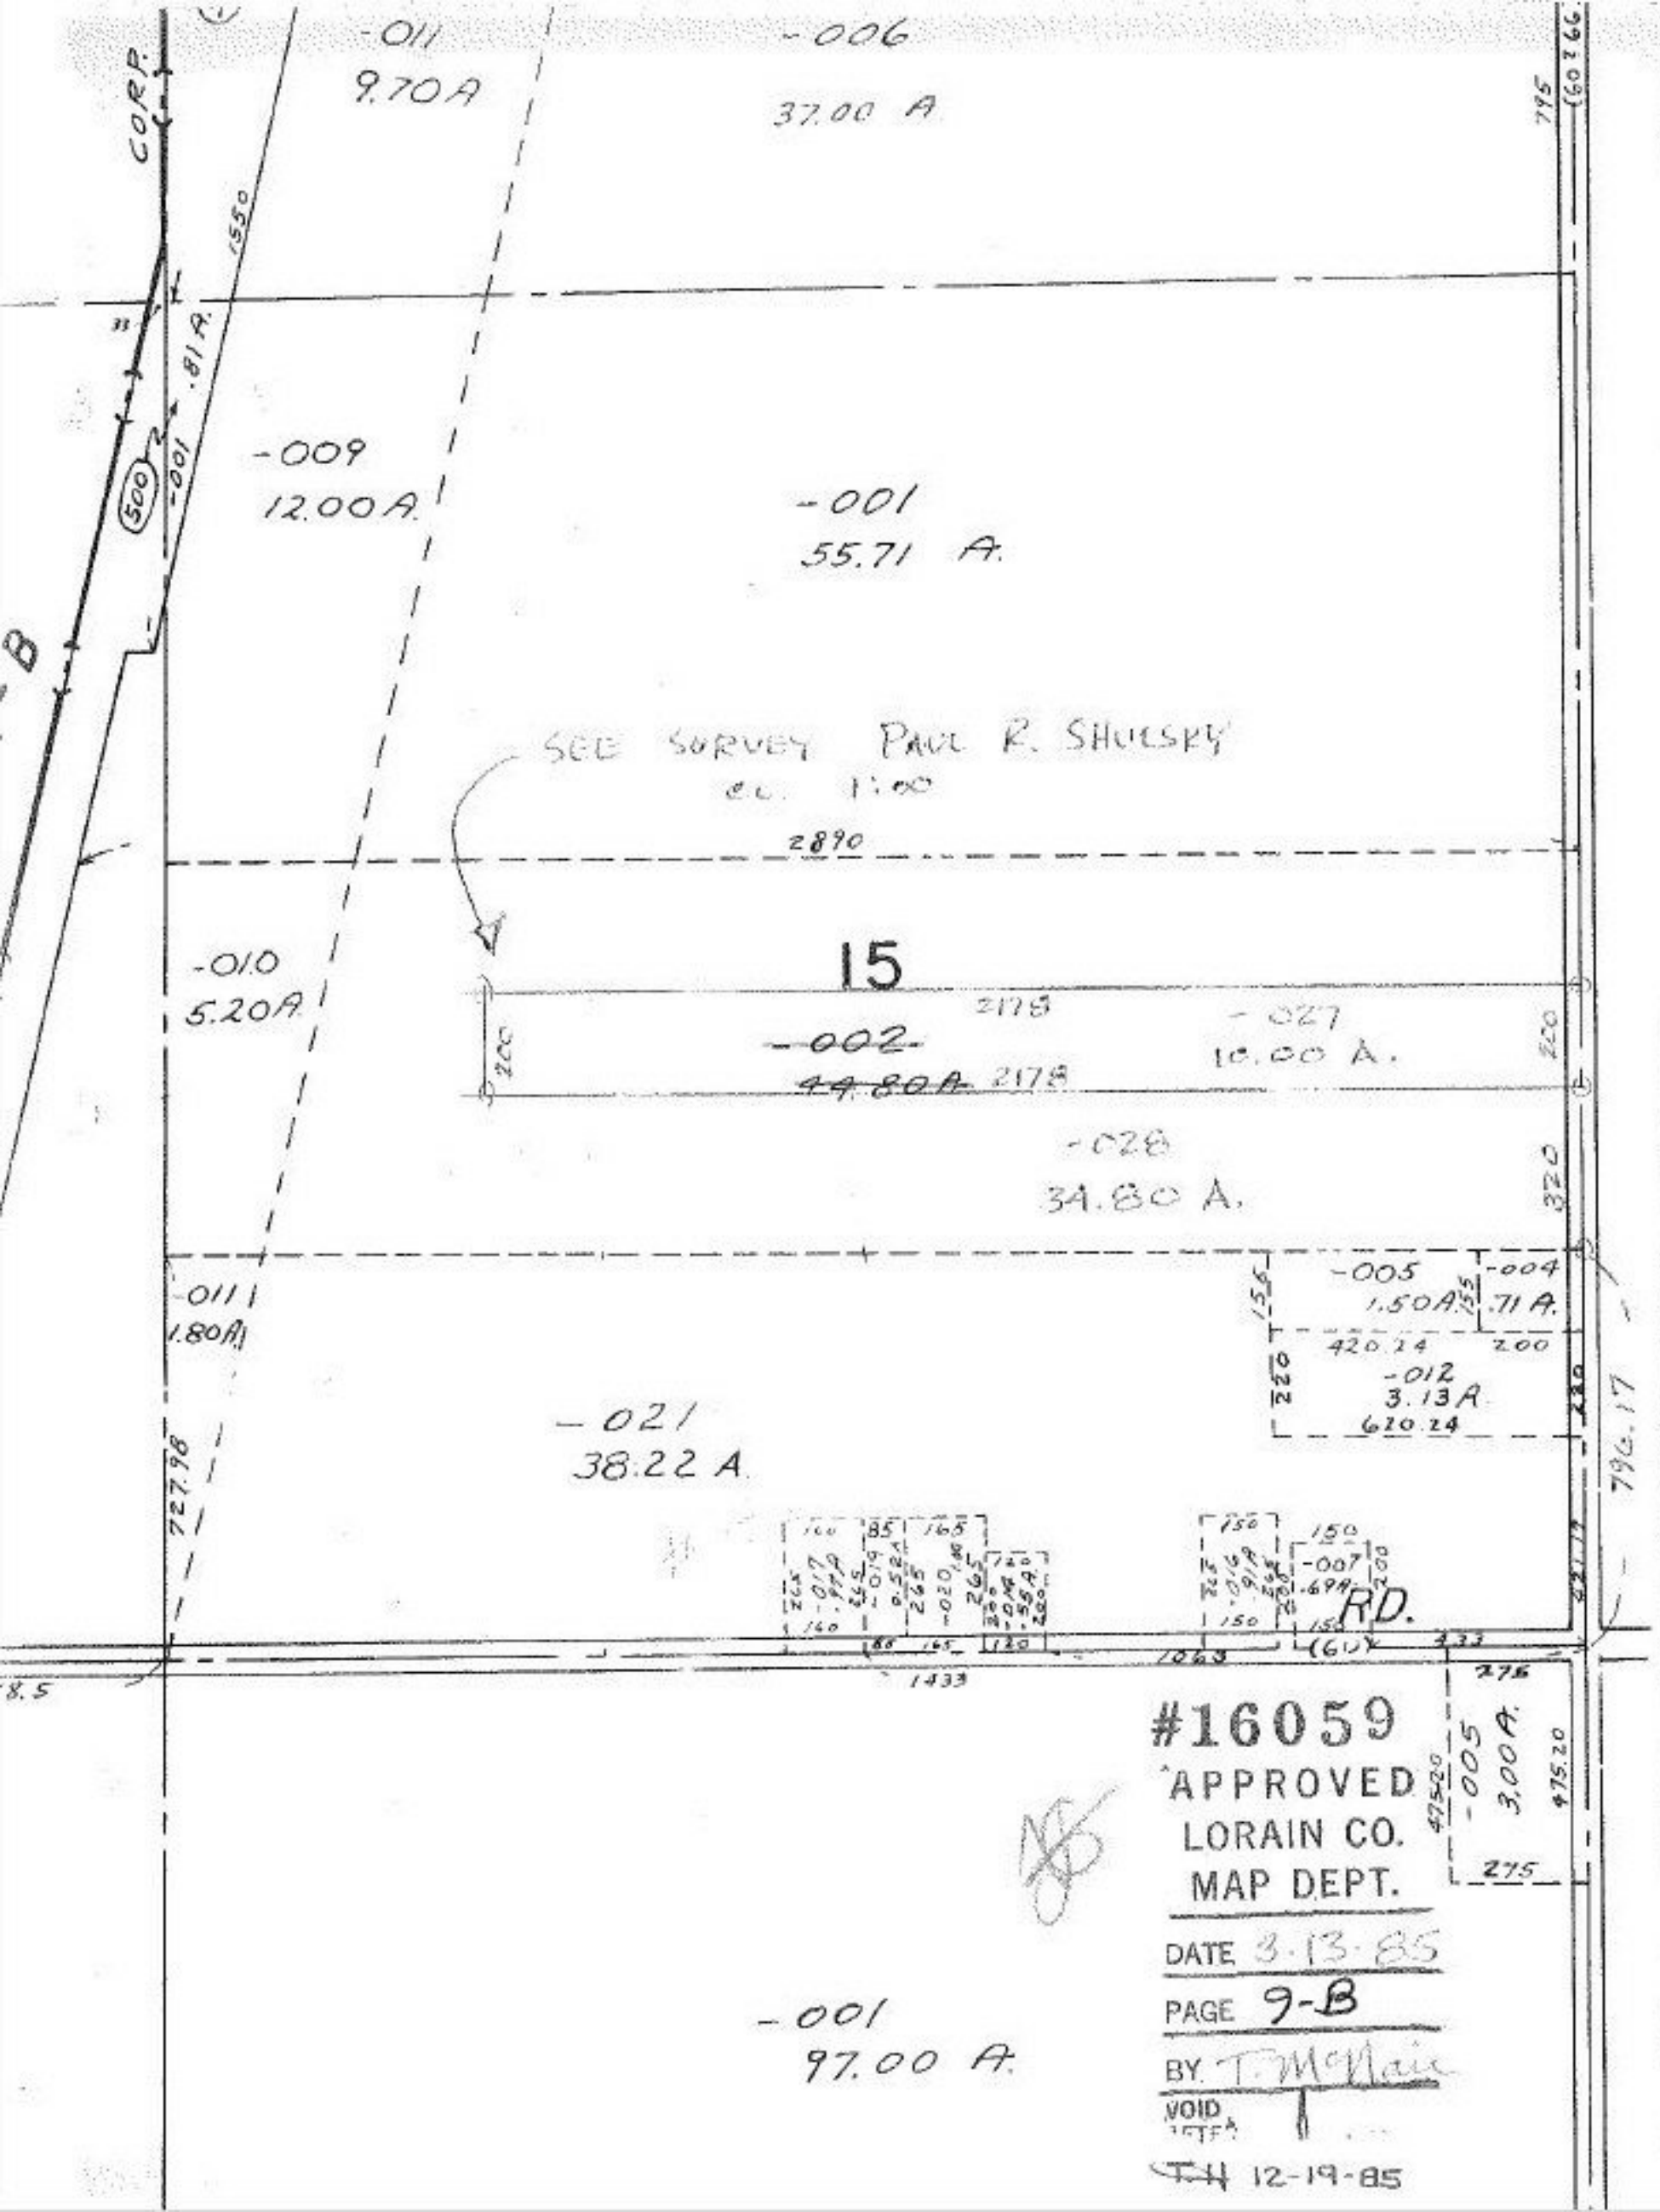

#16059
APPROVED
LORAIN CO.
MAP DEPT.
DATE 3-13-85
PAGE 9-B
BY T. McNair
VOID
DATE
T.H 12-19-85