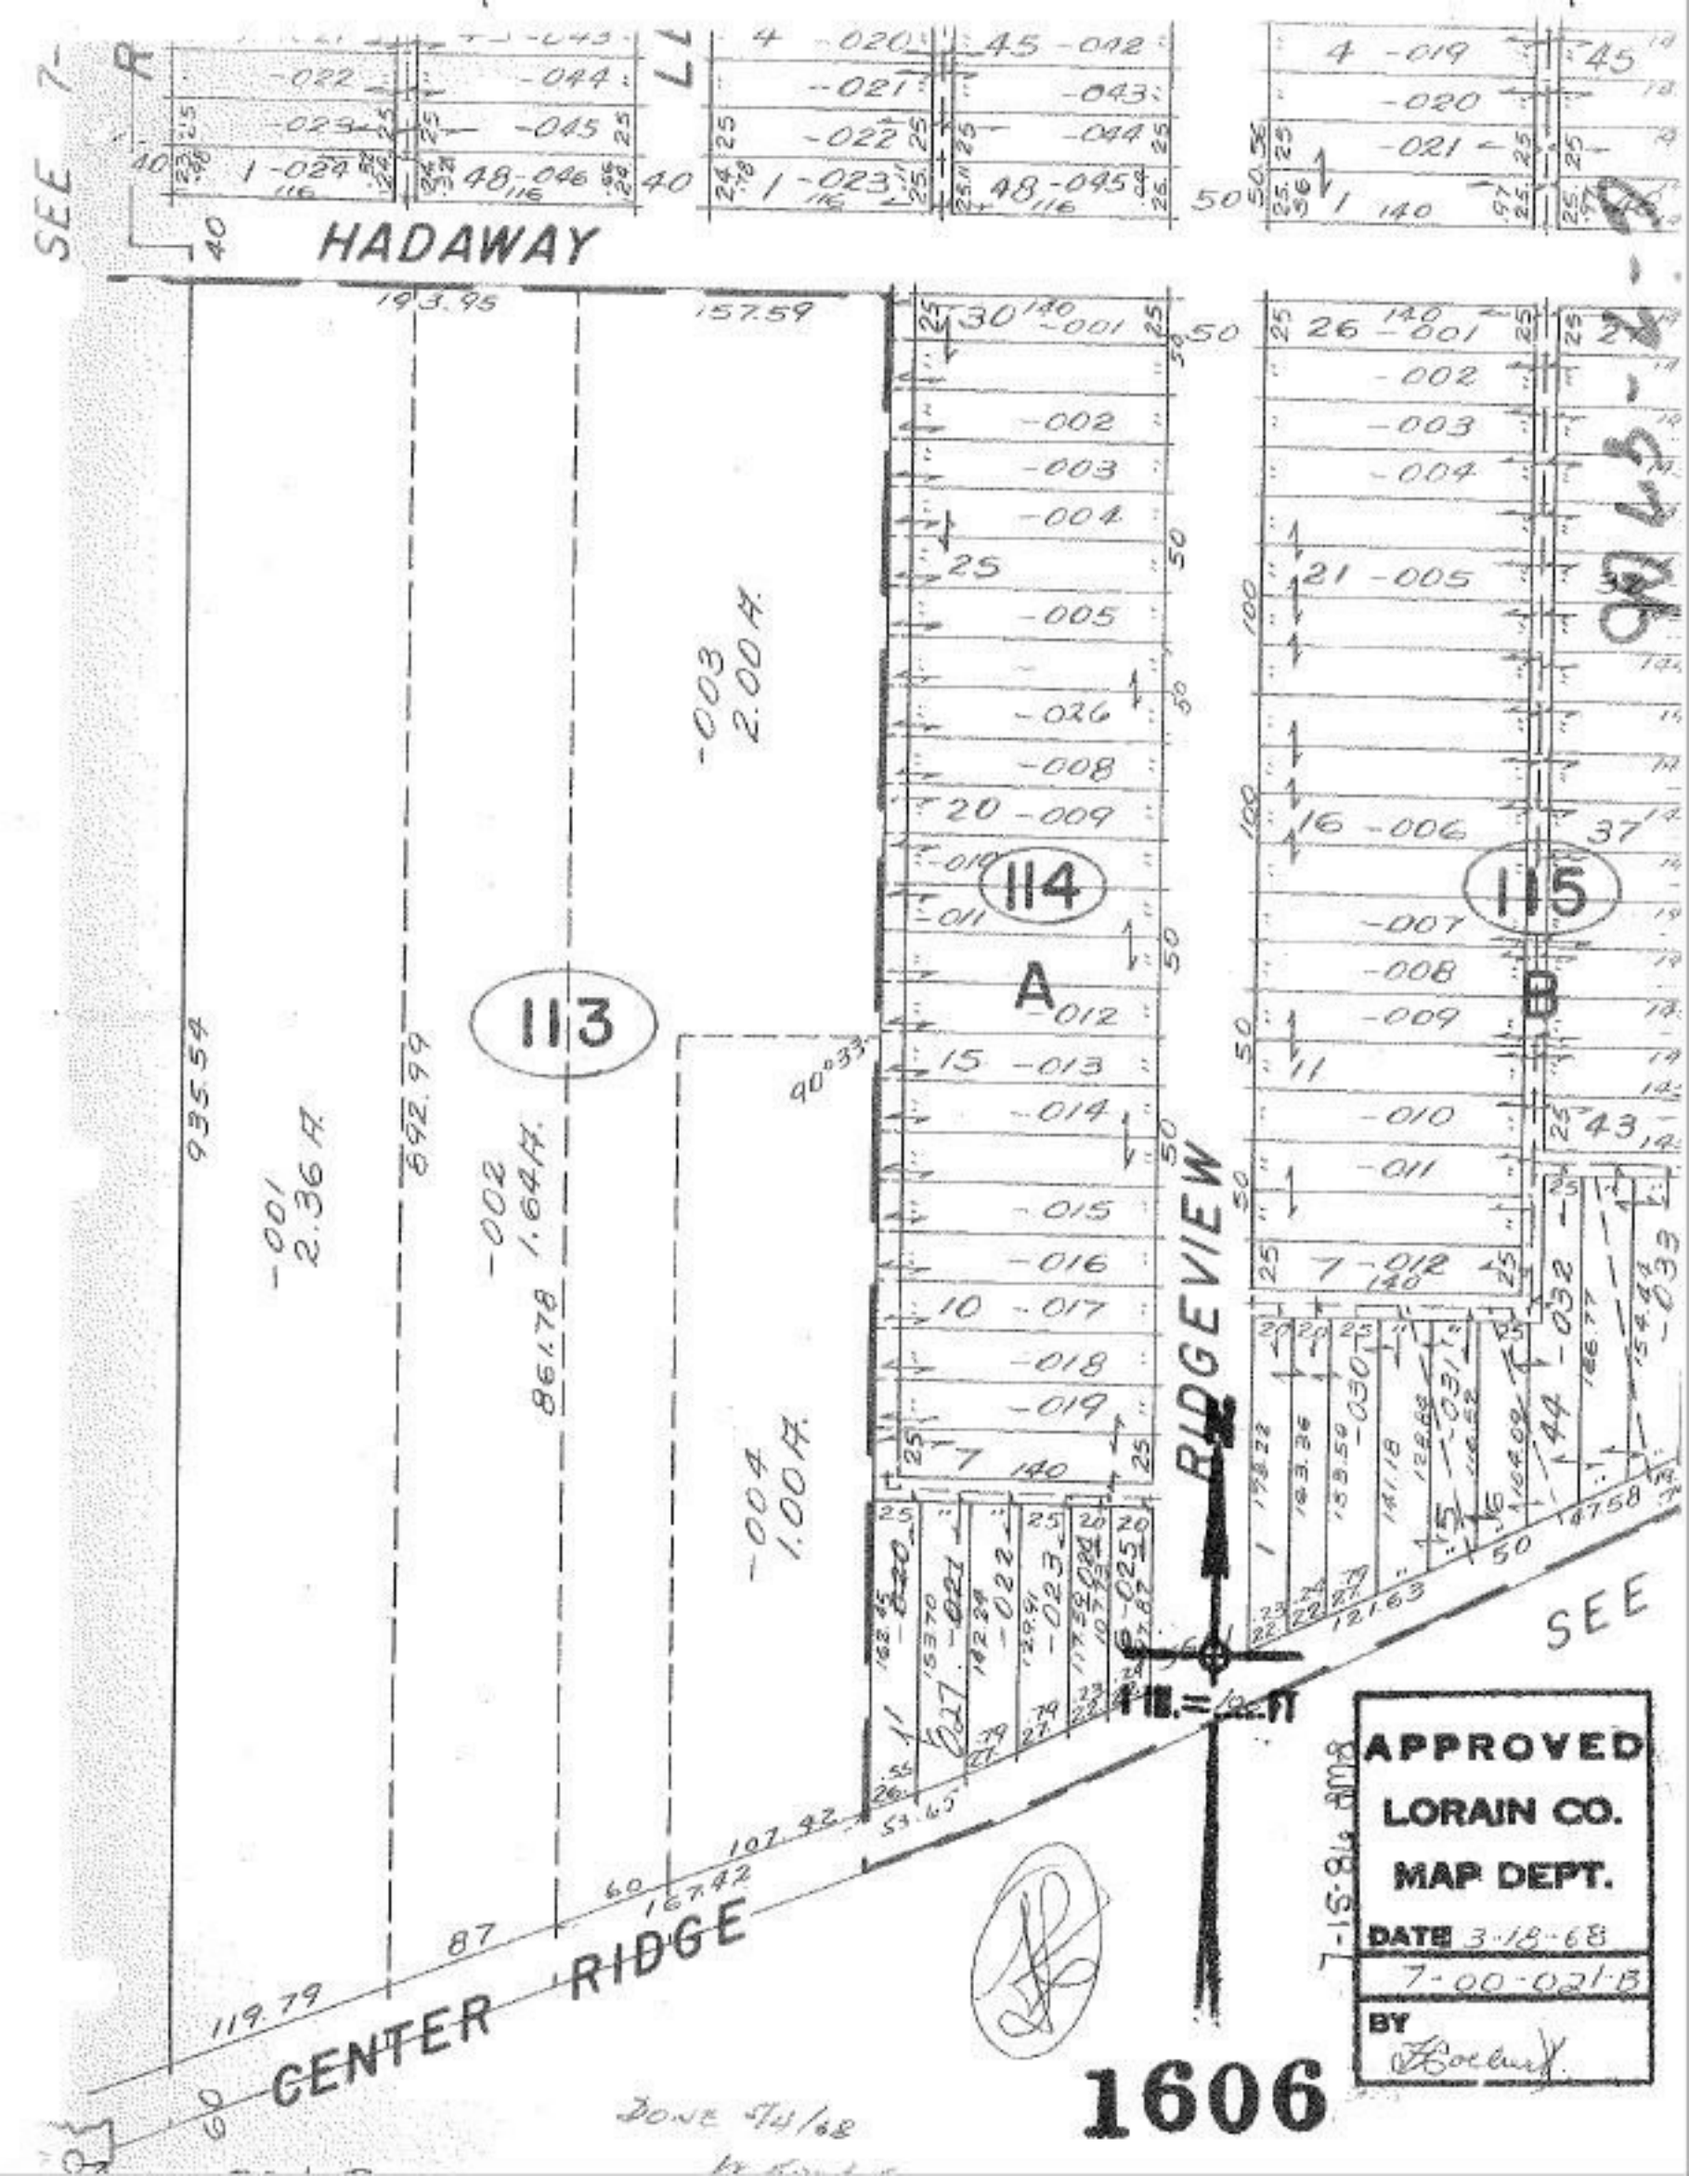
HADAWAY
RIDGEVIEW
CENTER RIDGE
113
114
115
A
B
SEE 7-
SEE
APPROVED
LORAIN CO.
MAP DEPT.
DATE 3-18-68
7-00-021-B
BY
1606
DONE 5/4/68