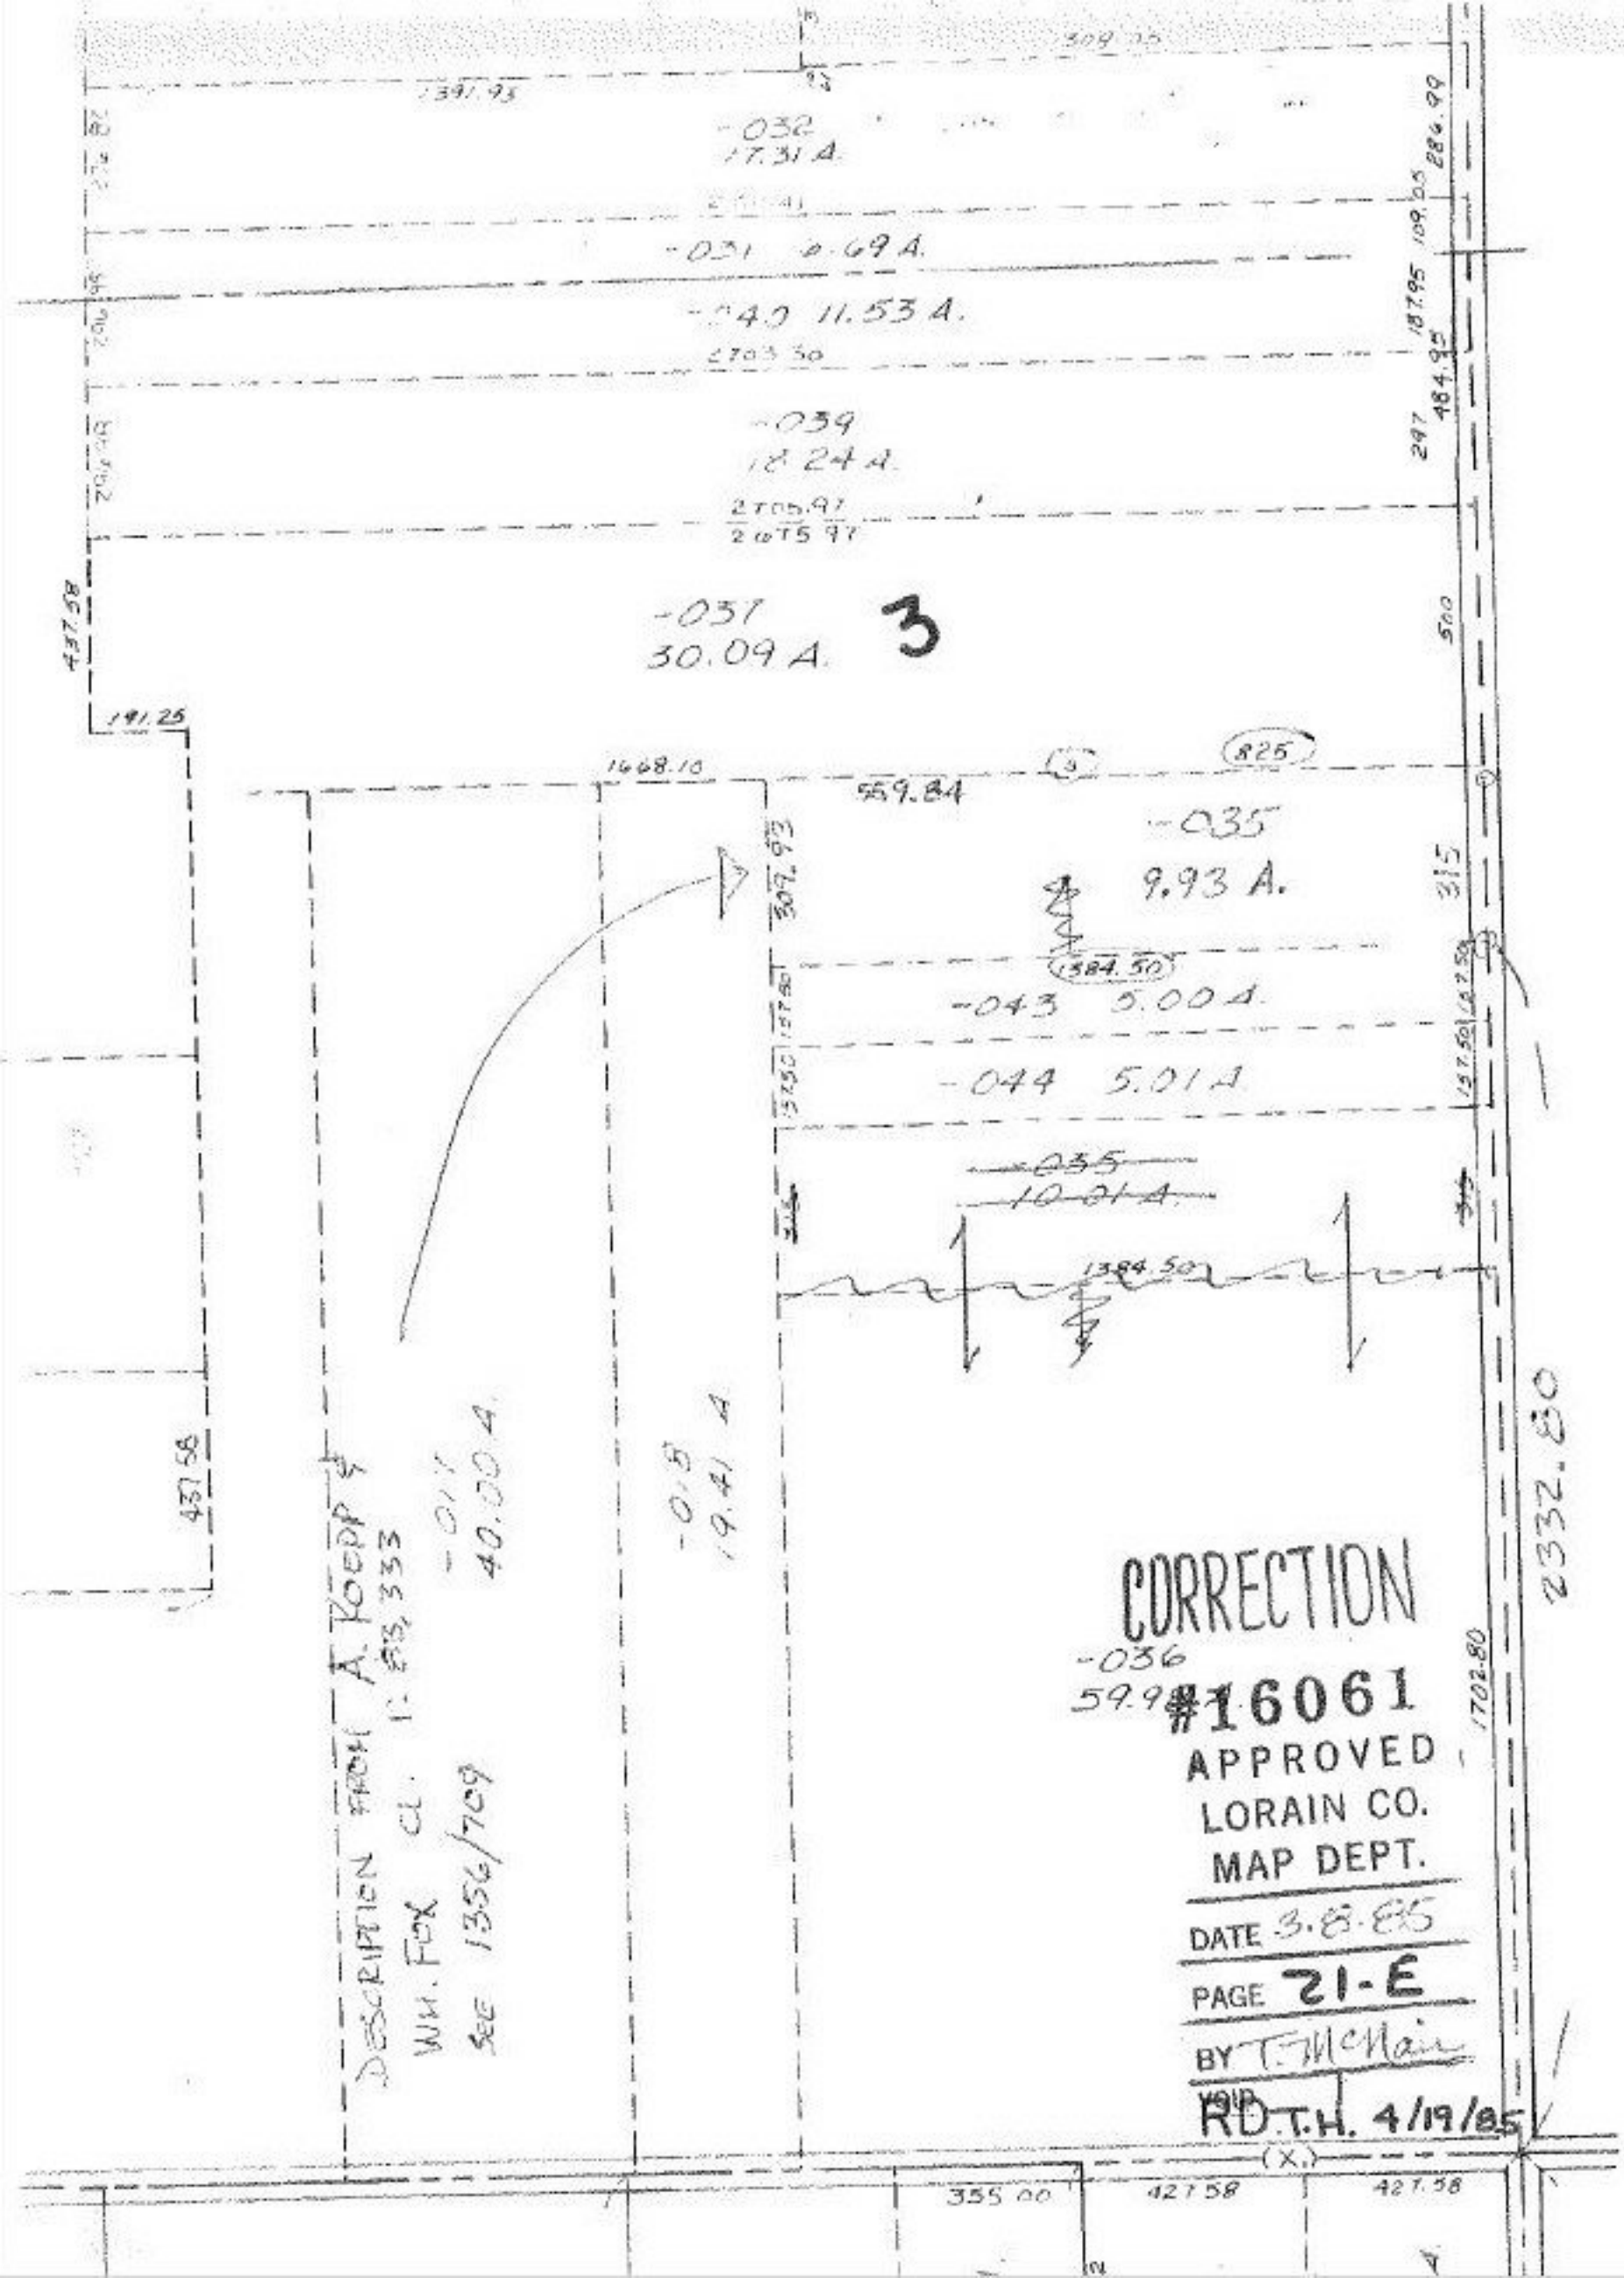

-032
17.31 A.
-031 6.69 A.
-040 11.53 A.
-039
18.24 A.
-037
30.09 A.
3
-035
9.93 A.
-043 5.00 A.
-044 5.01 A.
~~-035~~
~~10.01 A.~~
-036
59.9
-017
40.00 A.
-018
19.41 A.
DESCRIPTION FROM A. KOEPP & WM. FOX CL. 1:83,333
SEE 1356/709
CORRECTION
#16061
APPROVED
LORAIN CO.
MAP DEPT.
DATE 3.8.85
PAGE 21-E
BY T. McNair
VOID
RD. T.H. 4/19/85
2332.80
1391.93
1668.10
559.84
825
309.93
1384.50
1702.80
355.00
427.58