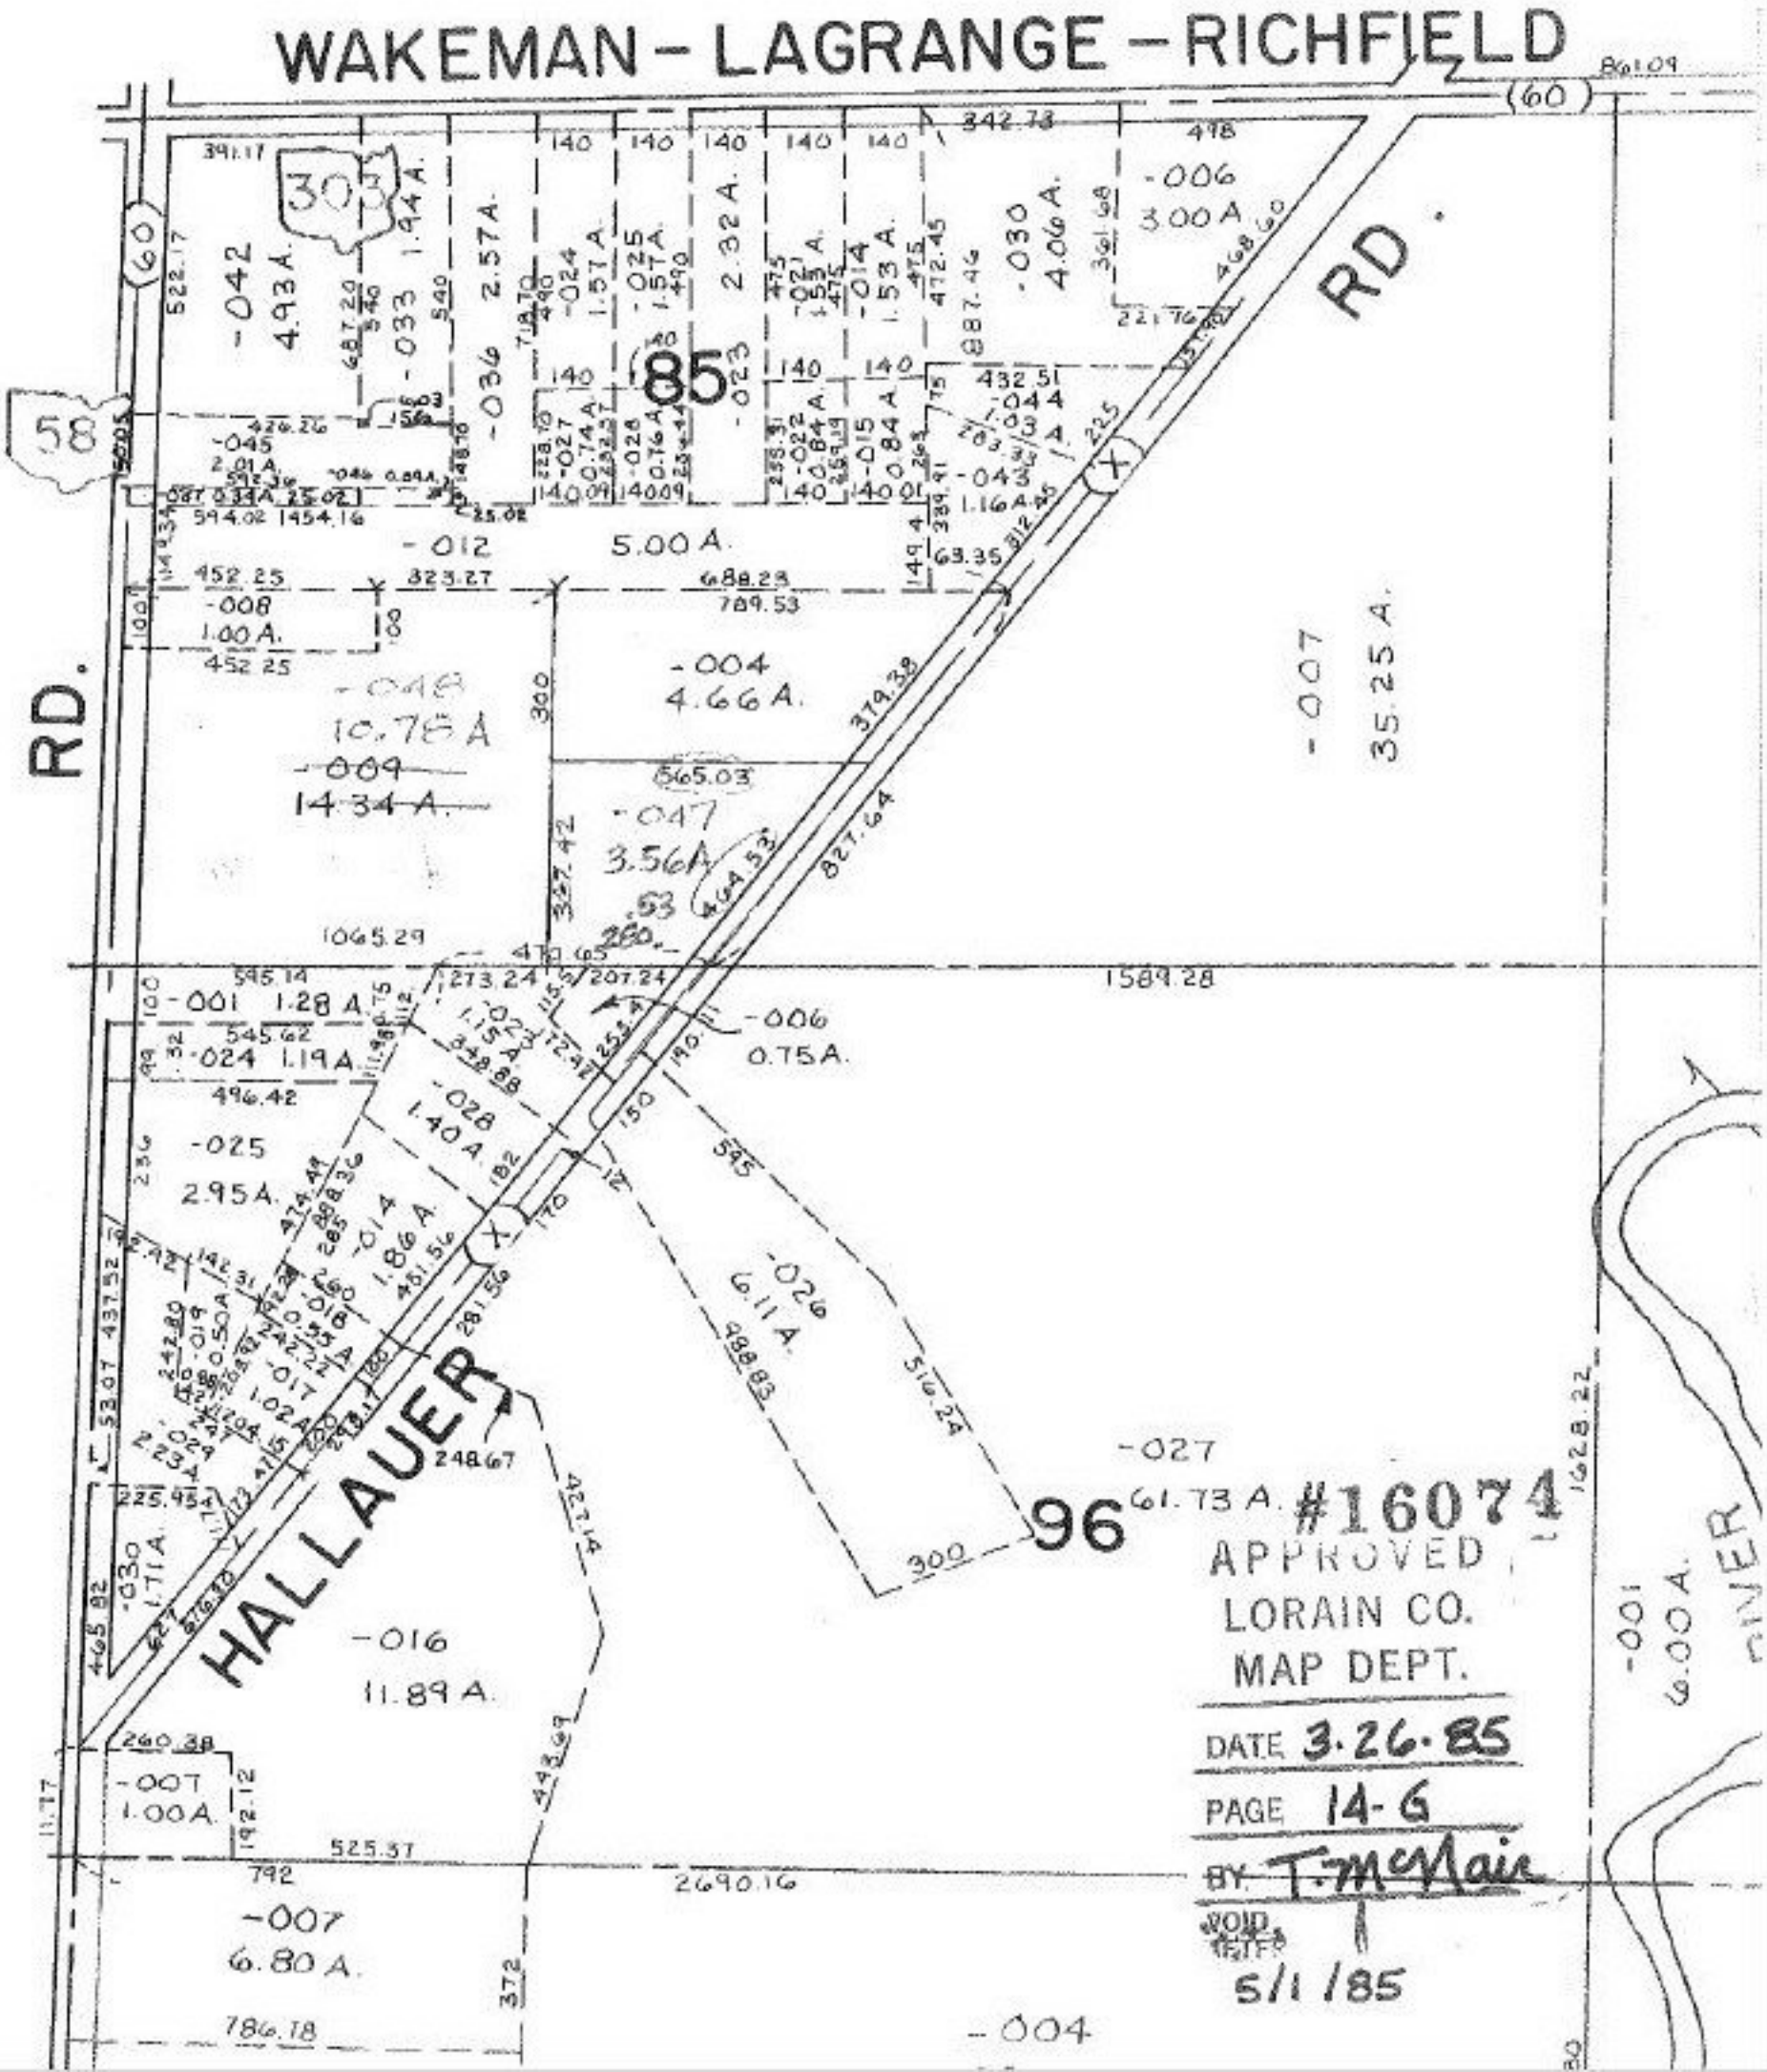
WAKEMAN - LAGRANGE - RICHFIELD
RD.
RD.
HALLAUER
85
96
-042 4.93 A.
-033 1.94 A.
-036 2.57 A.
-024 1.57 A.
-025 1.57 A.
-023 2.32 A.
-014 1.53 A.
-030 4.06 A.
-006 3.00 A.
-045 2.01 A.
-012 5.00 A.
-008 1.00 A.
-004 4.66 A.
-048 10.78 A
-009 14.34 A.
-047 3.56 A
-007 35.25 A.
-001 1.28 A.
-024 1.19 A.
-006 0.75 A.
-028 1.40 A.
-025 2.95 A.
-014 1.86 A.
-026 6.11 A.
-027 61.73 A.
-016 11.89 A.
-030 1.71 A.
-007 1.00 A.
-007 6.80 A.
-004
-001 6.00 A.
DIVER
#16074
APPROVED
LORAIN CO.
MAP DEPT.
DATE 3.26.85
PAGE 14-G
BY T. McNair
VOID
5/1/85