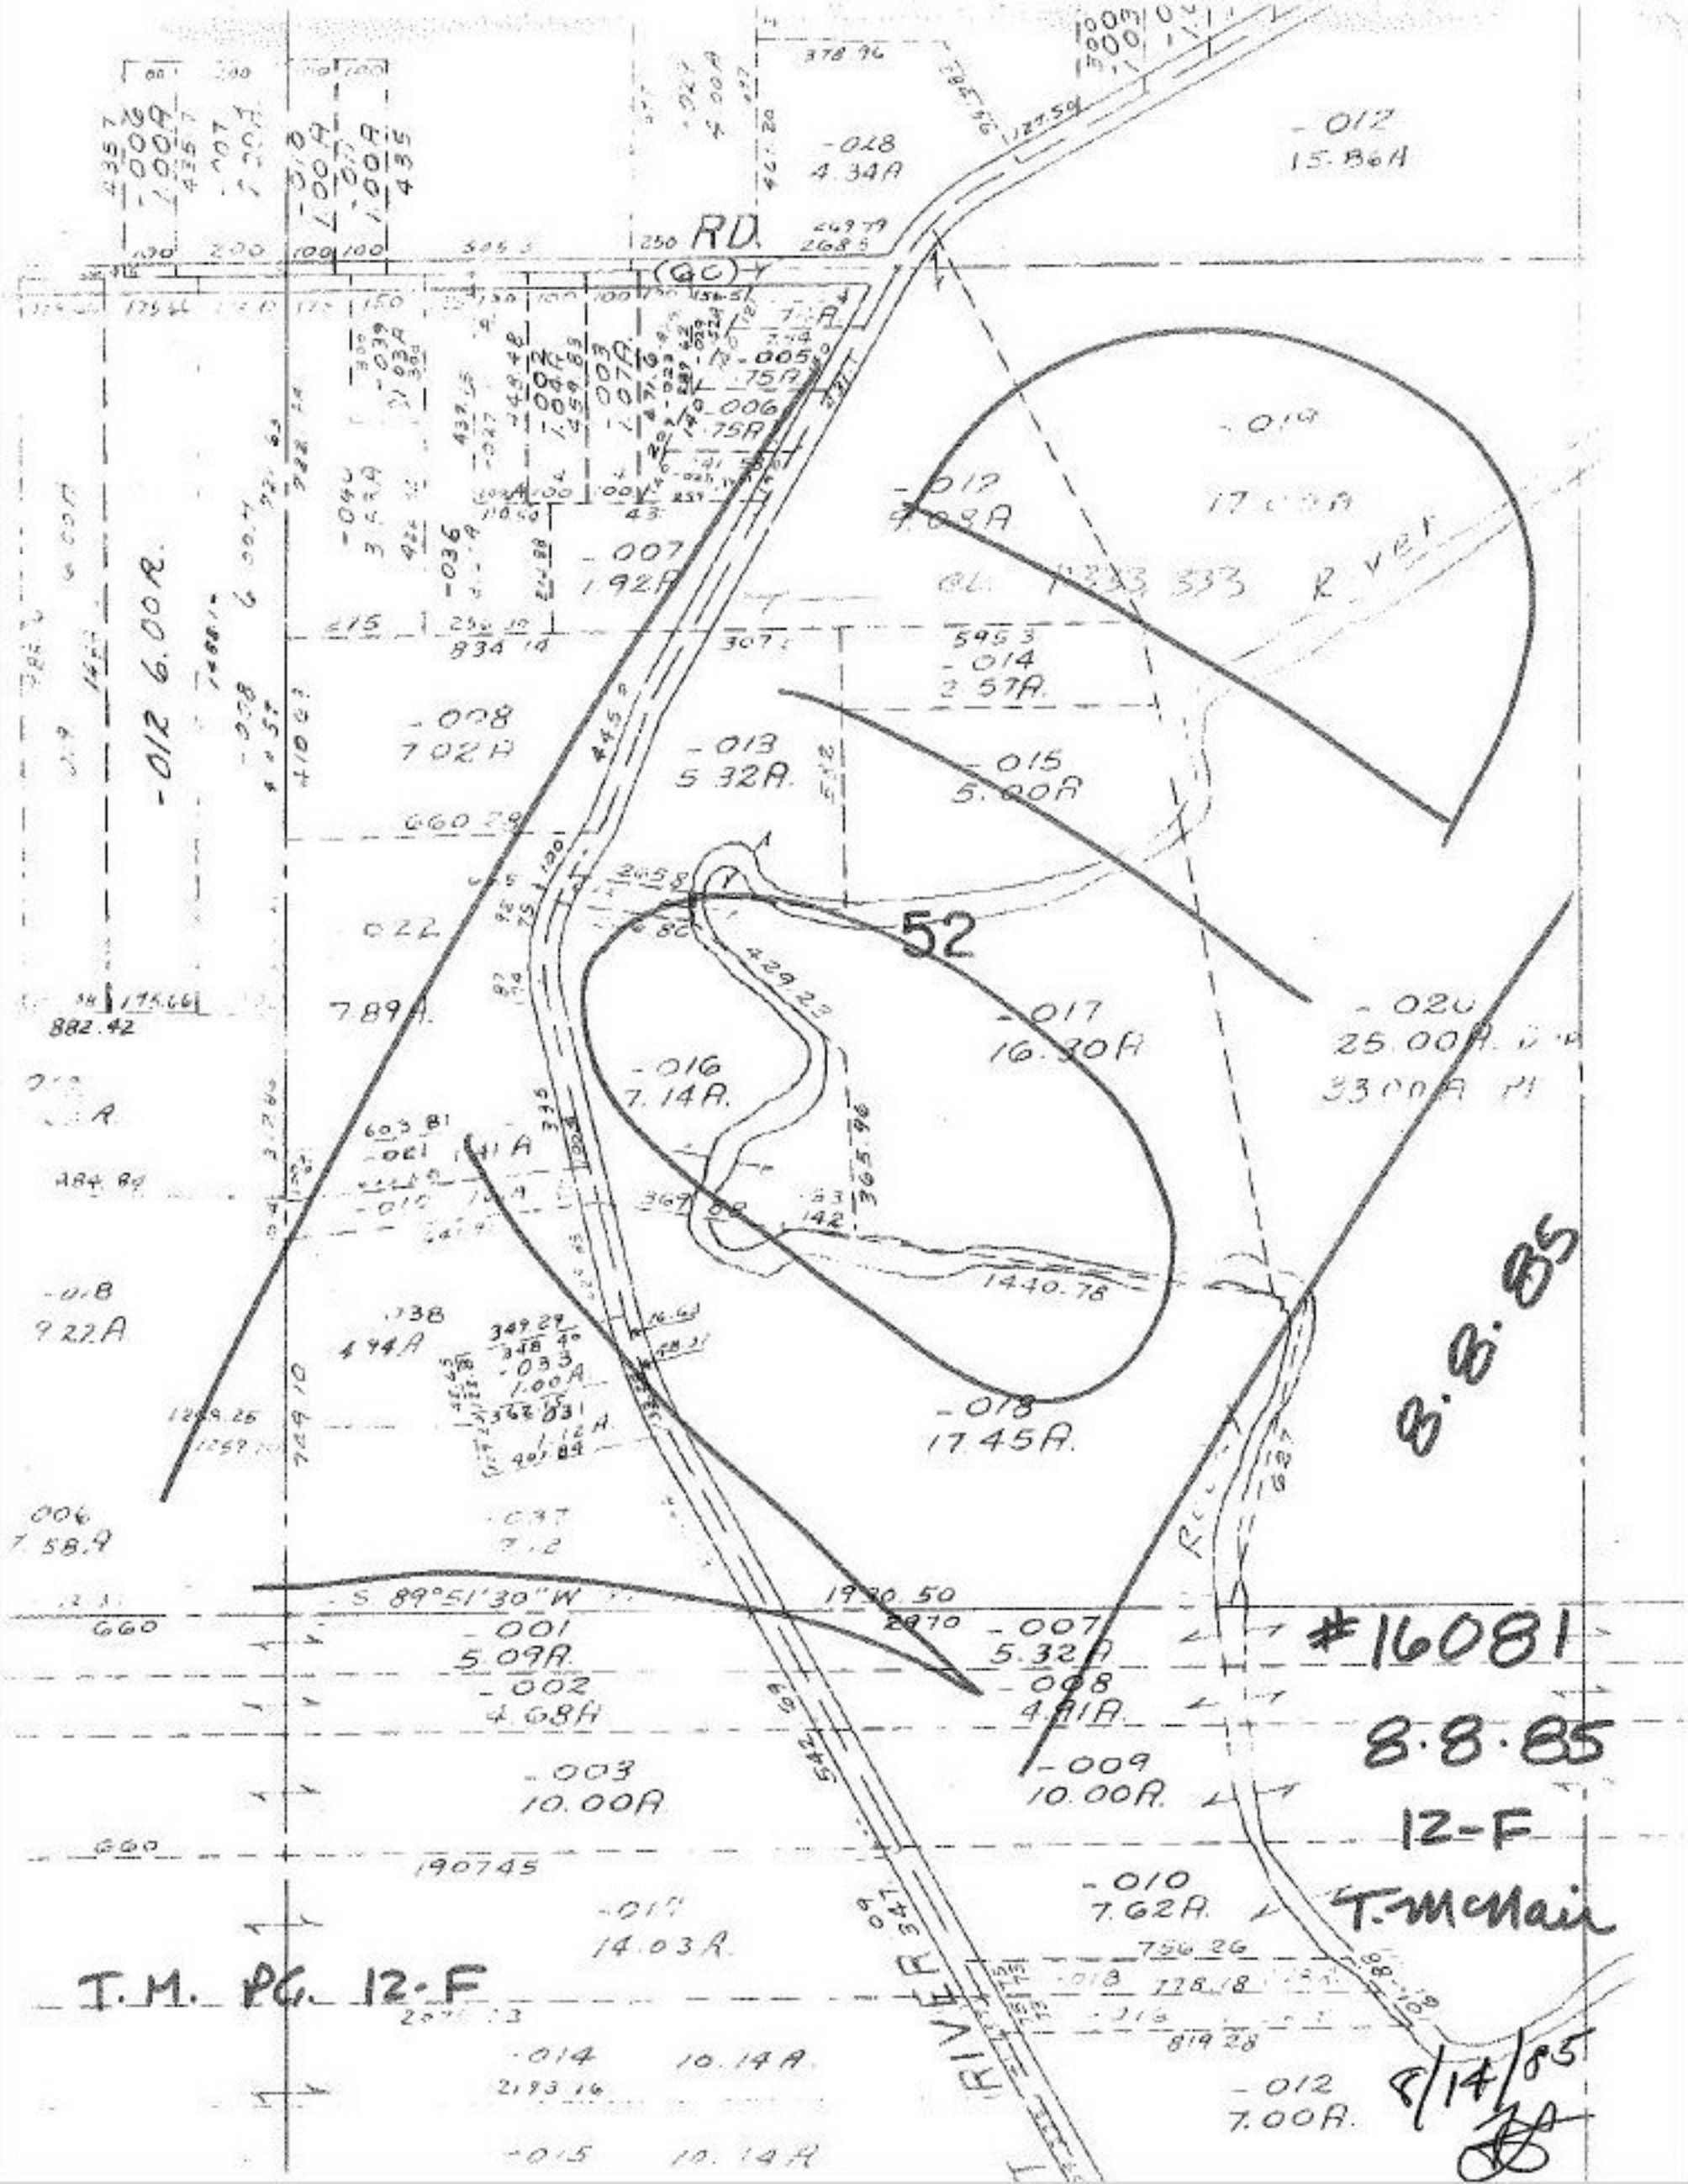

RD.
(GC)
-012
15.86A
-028
4.34A
-012 6.00A
-007
1.92A
-008
7.02A
-013
5.32A
-014
2.57A
-015
5.00A
52
-017
16.30A
-016
7.14A
-020
25.00A
-018
17.45A
-001
5.09A
-002
4.68A
-003
10.00A
-007
5.32A
-008
4.91A
-009
10.00A
-010
7.62A
-012
7.00A
-014
10.14A
-015
10.14A
RIVER
S 89°51'30"W
1930.50
2970
1440.78
8.8.85
#16081
8.8.85
12-F
T.McNair
T.M. PG. 12-F
8/14/85