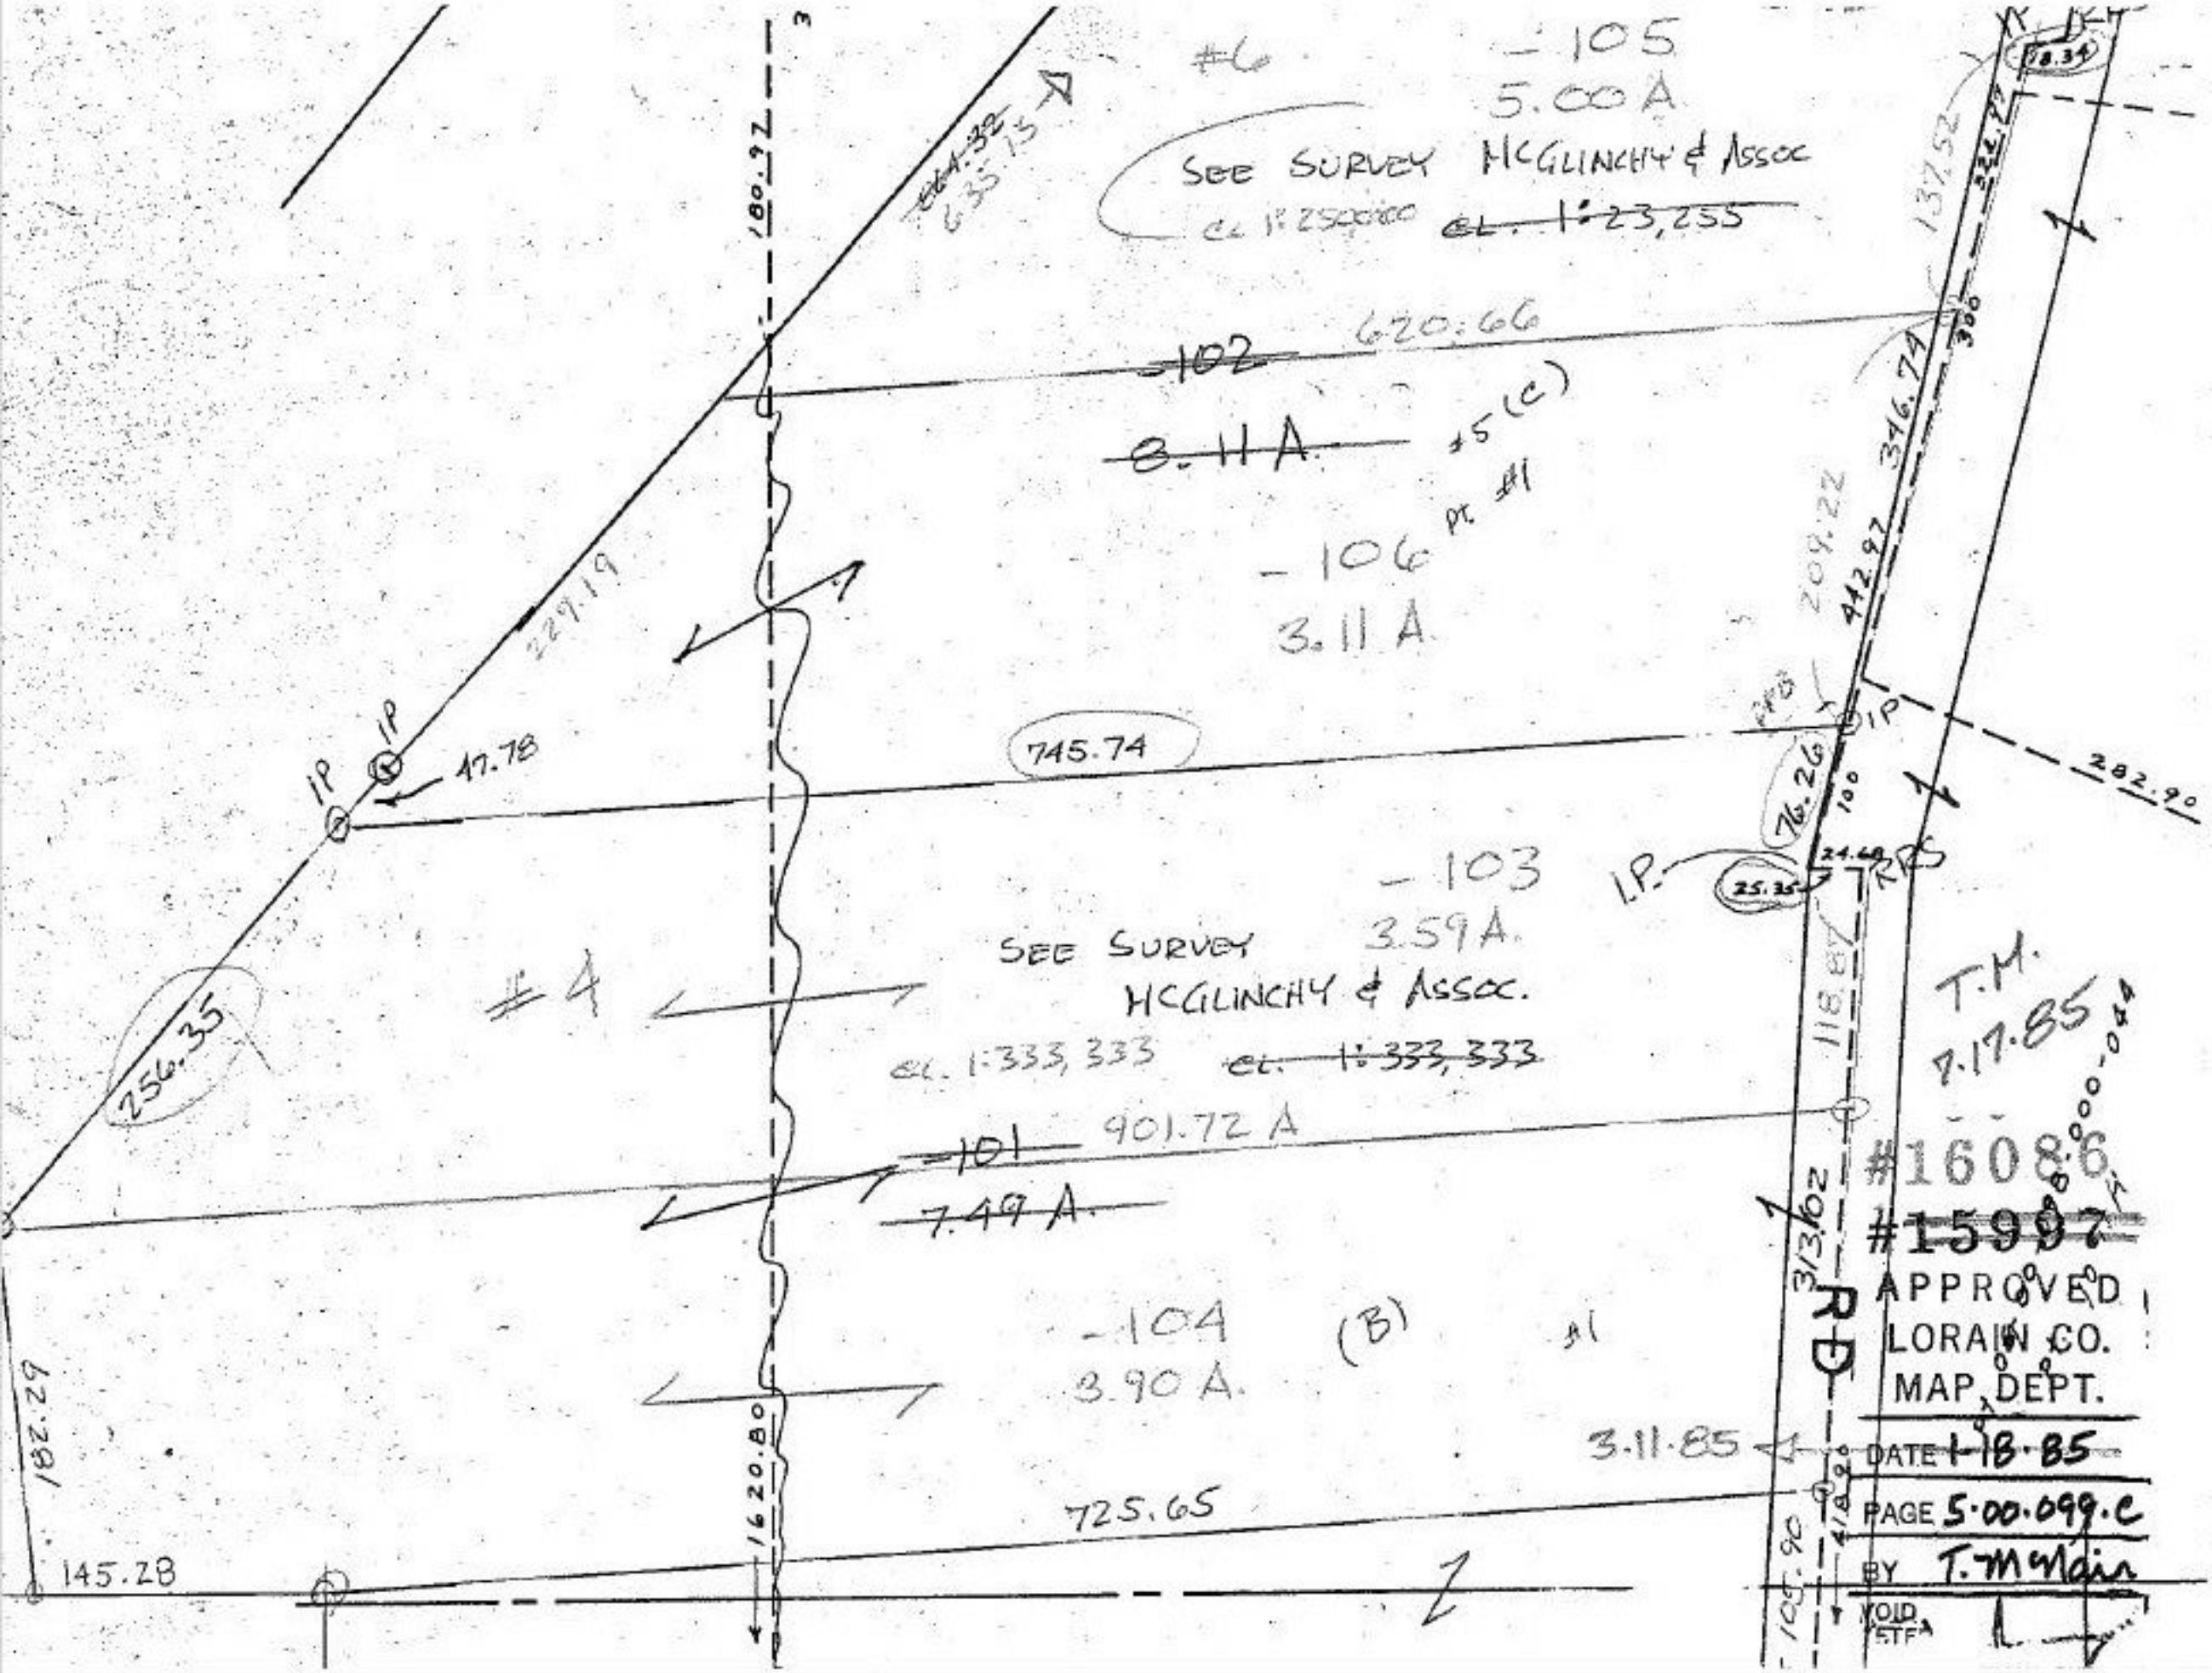

#6
-105
5.00 A
SEE SURVEY McGLINCHY & Assoc
cl. 1:2500000 ~~cl. 1:23,255~~
180.97
~~664.32~~
635.15
~~-102~~ 620.66
~~8.11 A~~
#5 (C)
-106 pt. #1
3.11 A
229.19
IP
IP
47.78
745.74
-103
3.59 A.
SEE SURVEY
McGLINCHY & Assoc.
cl. 1:333,333 ~~cl. 1:333,333~~
#4
256.35
~~-101~~ 901.72 A
~~7.49 A.~~
-104
3.90 A.
(B)
#1
182.29
1620.80
725.65
145.28
3.11.85
RD
137.52
346.74
209.22
442.97
282.90
76.26
25.35
24.68
118.87
T.M.
7.17.85
#16086
~~#15997~~
APPROVED
LORAIN CO.
MAP DEPT.
DATE 1-18-85
PAGE 5-00-099-C
BY T. McNair
VOID