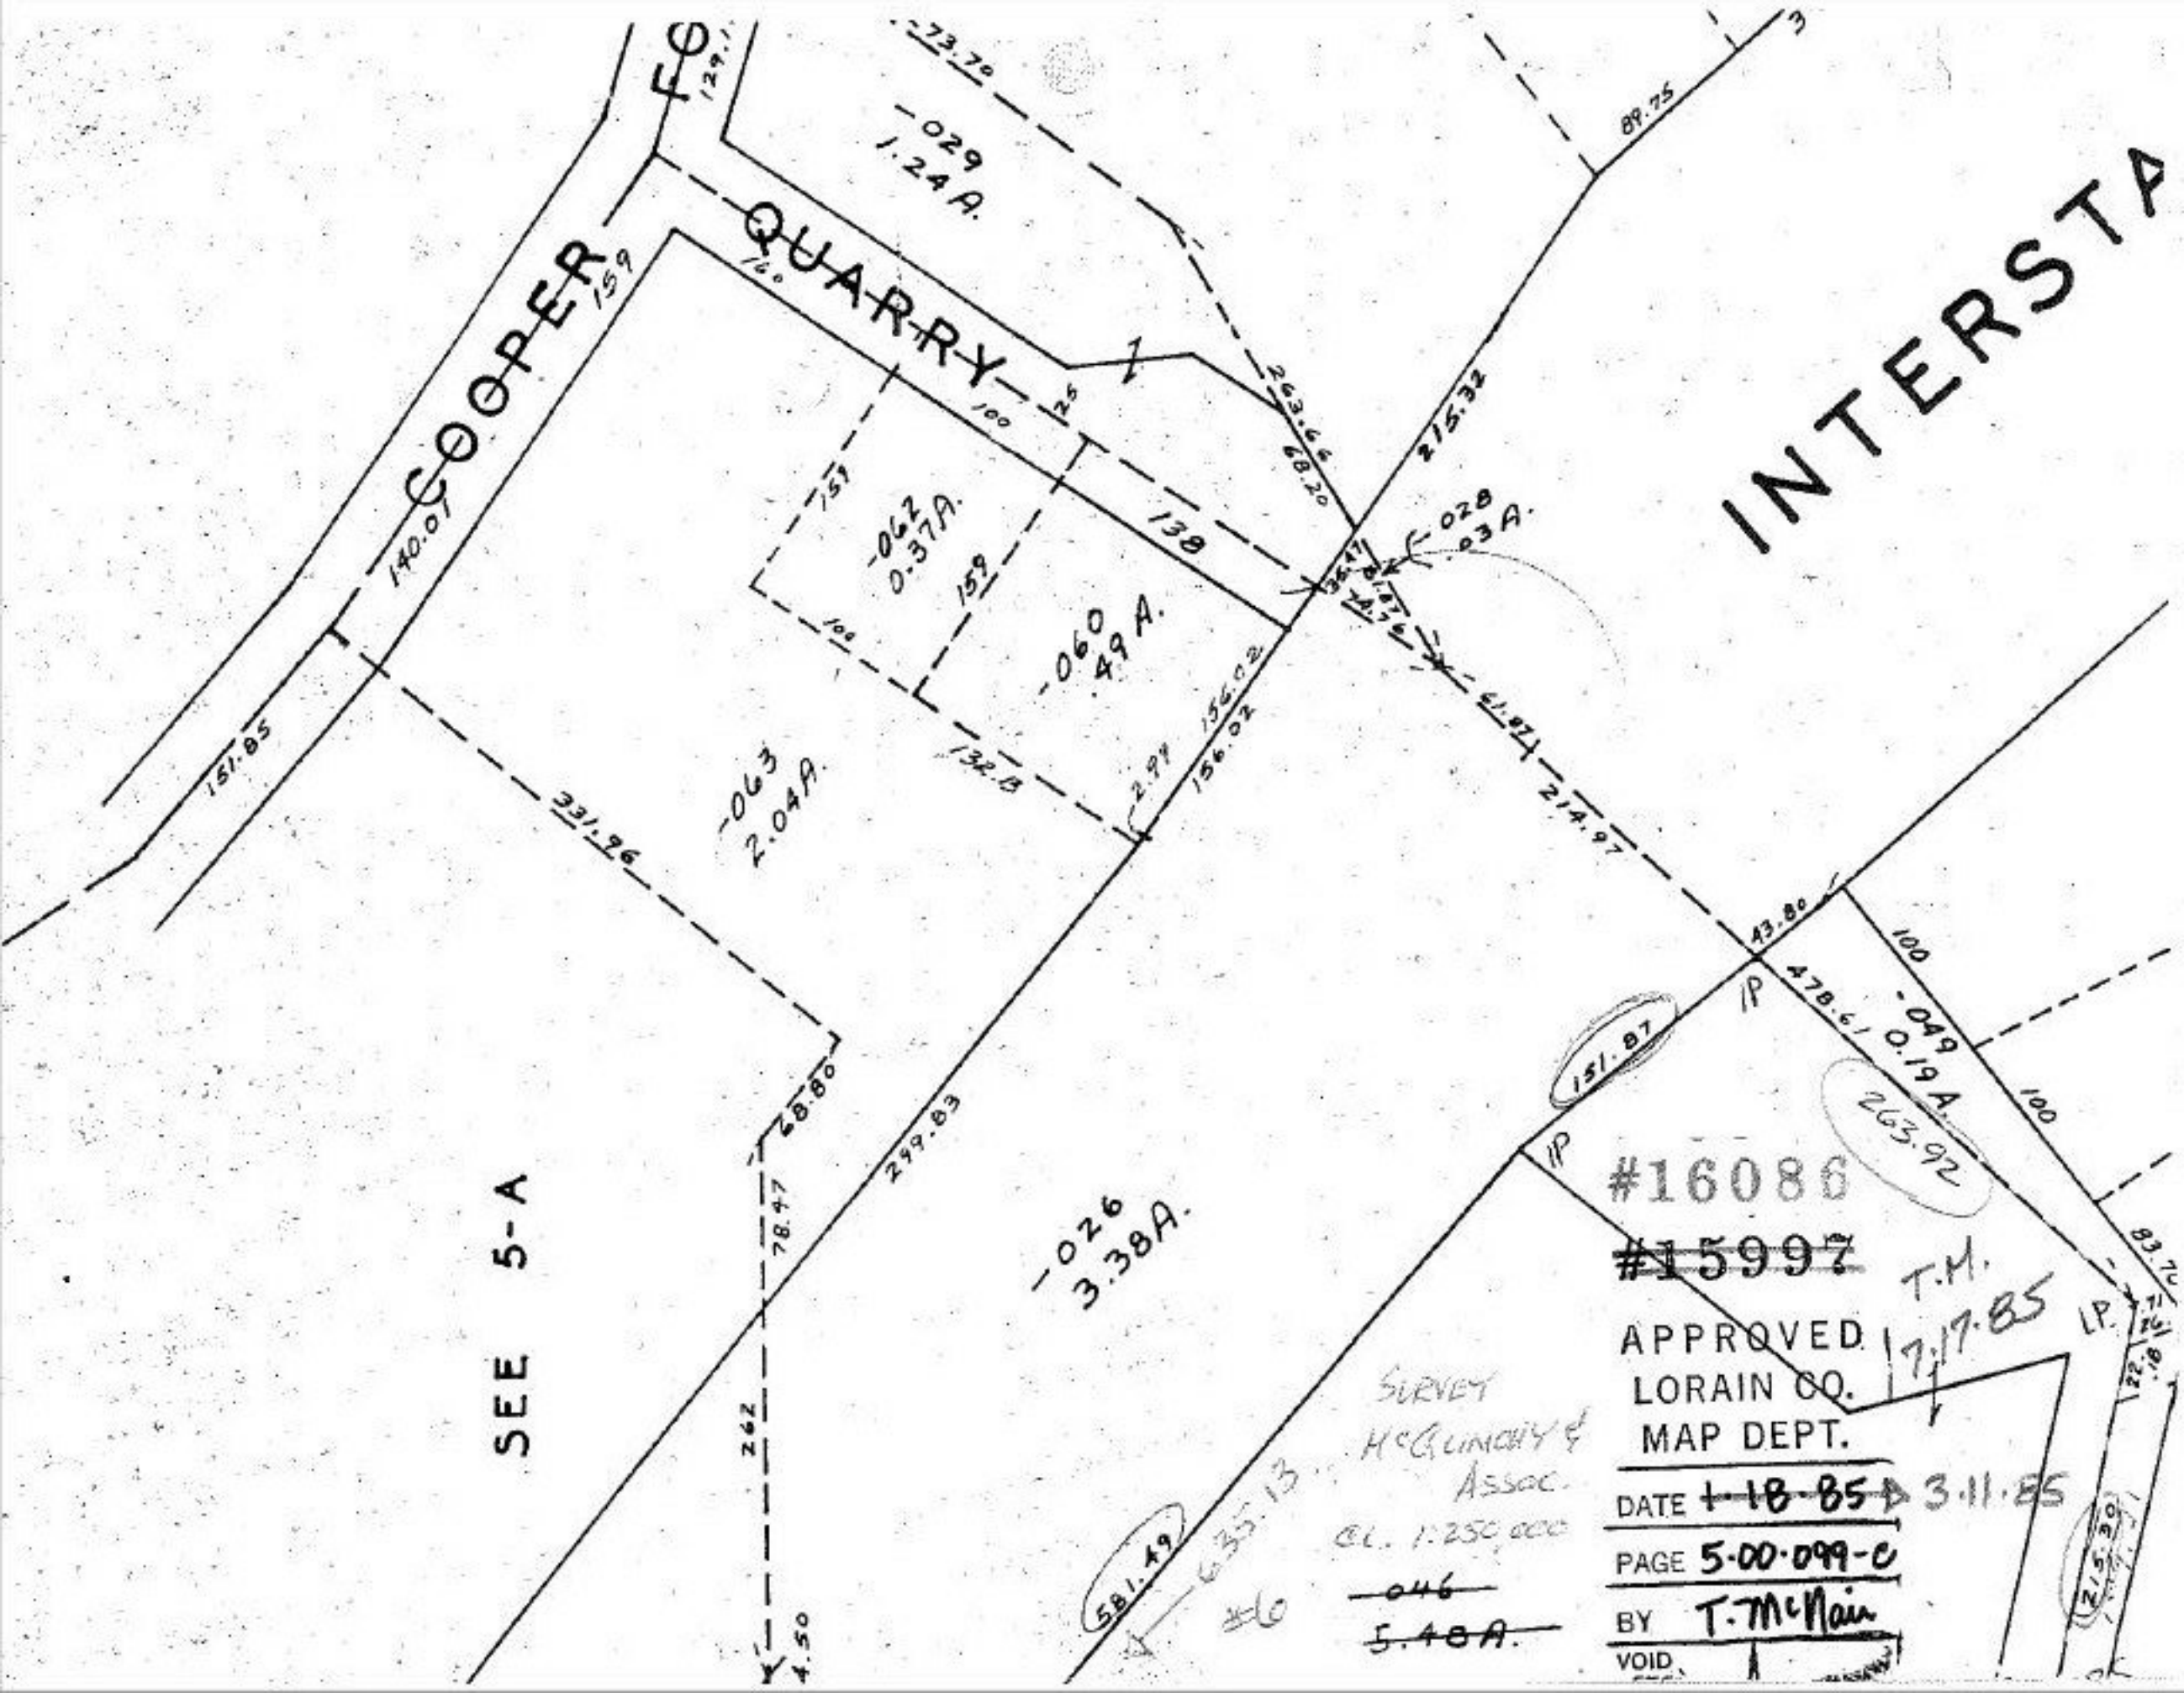
COOPER
QUARRY
INTERSTA
-029
1.24 A.
-062
0.37 A.
-060
.49 A.
-063
2.04 A.
-026
3.38 A.
-028
.03 A.
-049
0.19 A.
SEE 5-A
#16086
#15997
APPROVED
LORAIN CO.
MAP DEPT.
DATE 1-18-85 3.11.85
PAGE 5-00-099-C
BY T. McNair
VOID
T.M.
7.17.85
SURVEY
McGLINCHY &
ASSOC.
CL. 1:250,000
-046
5.48 A.
#6