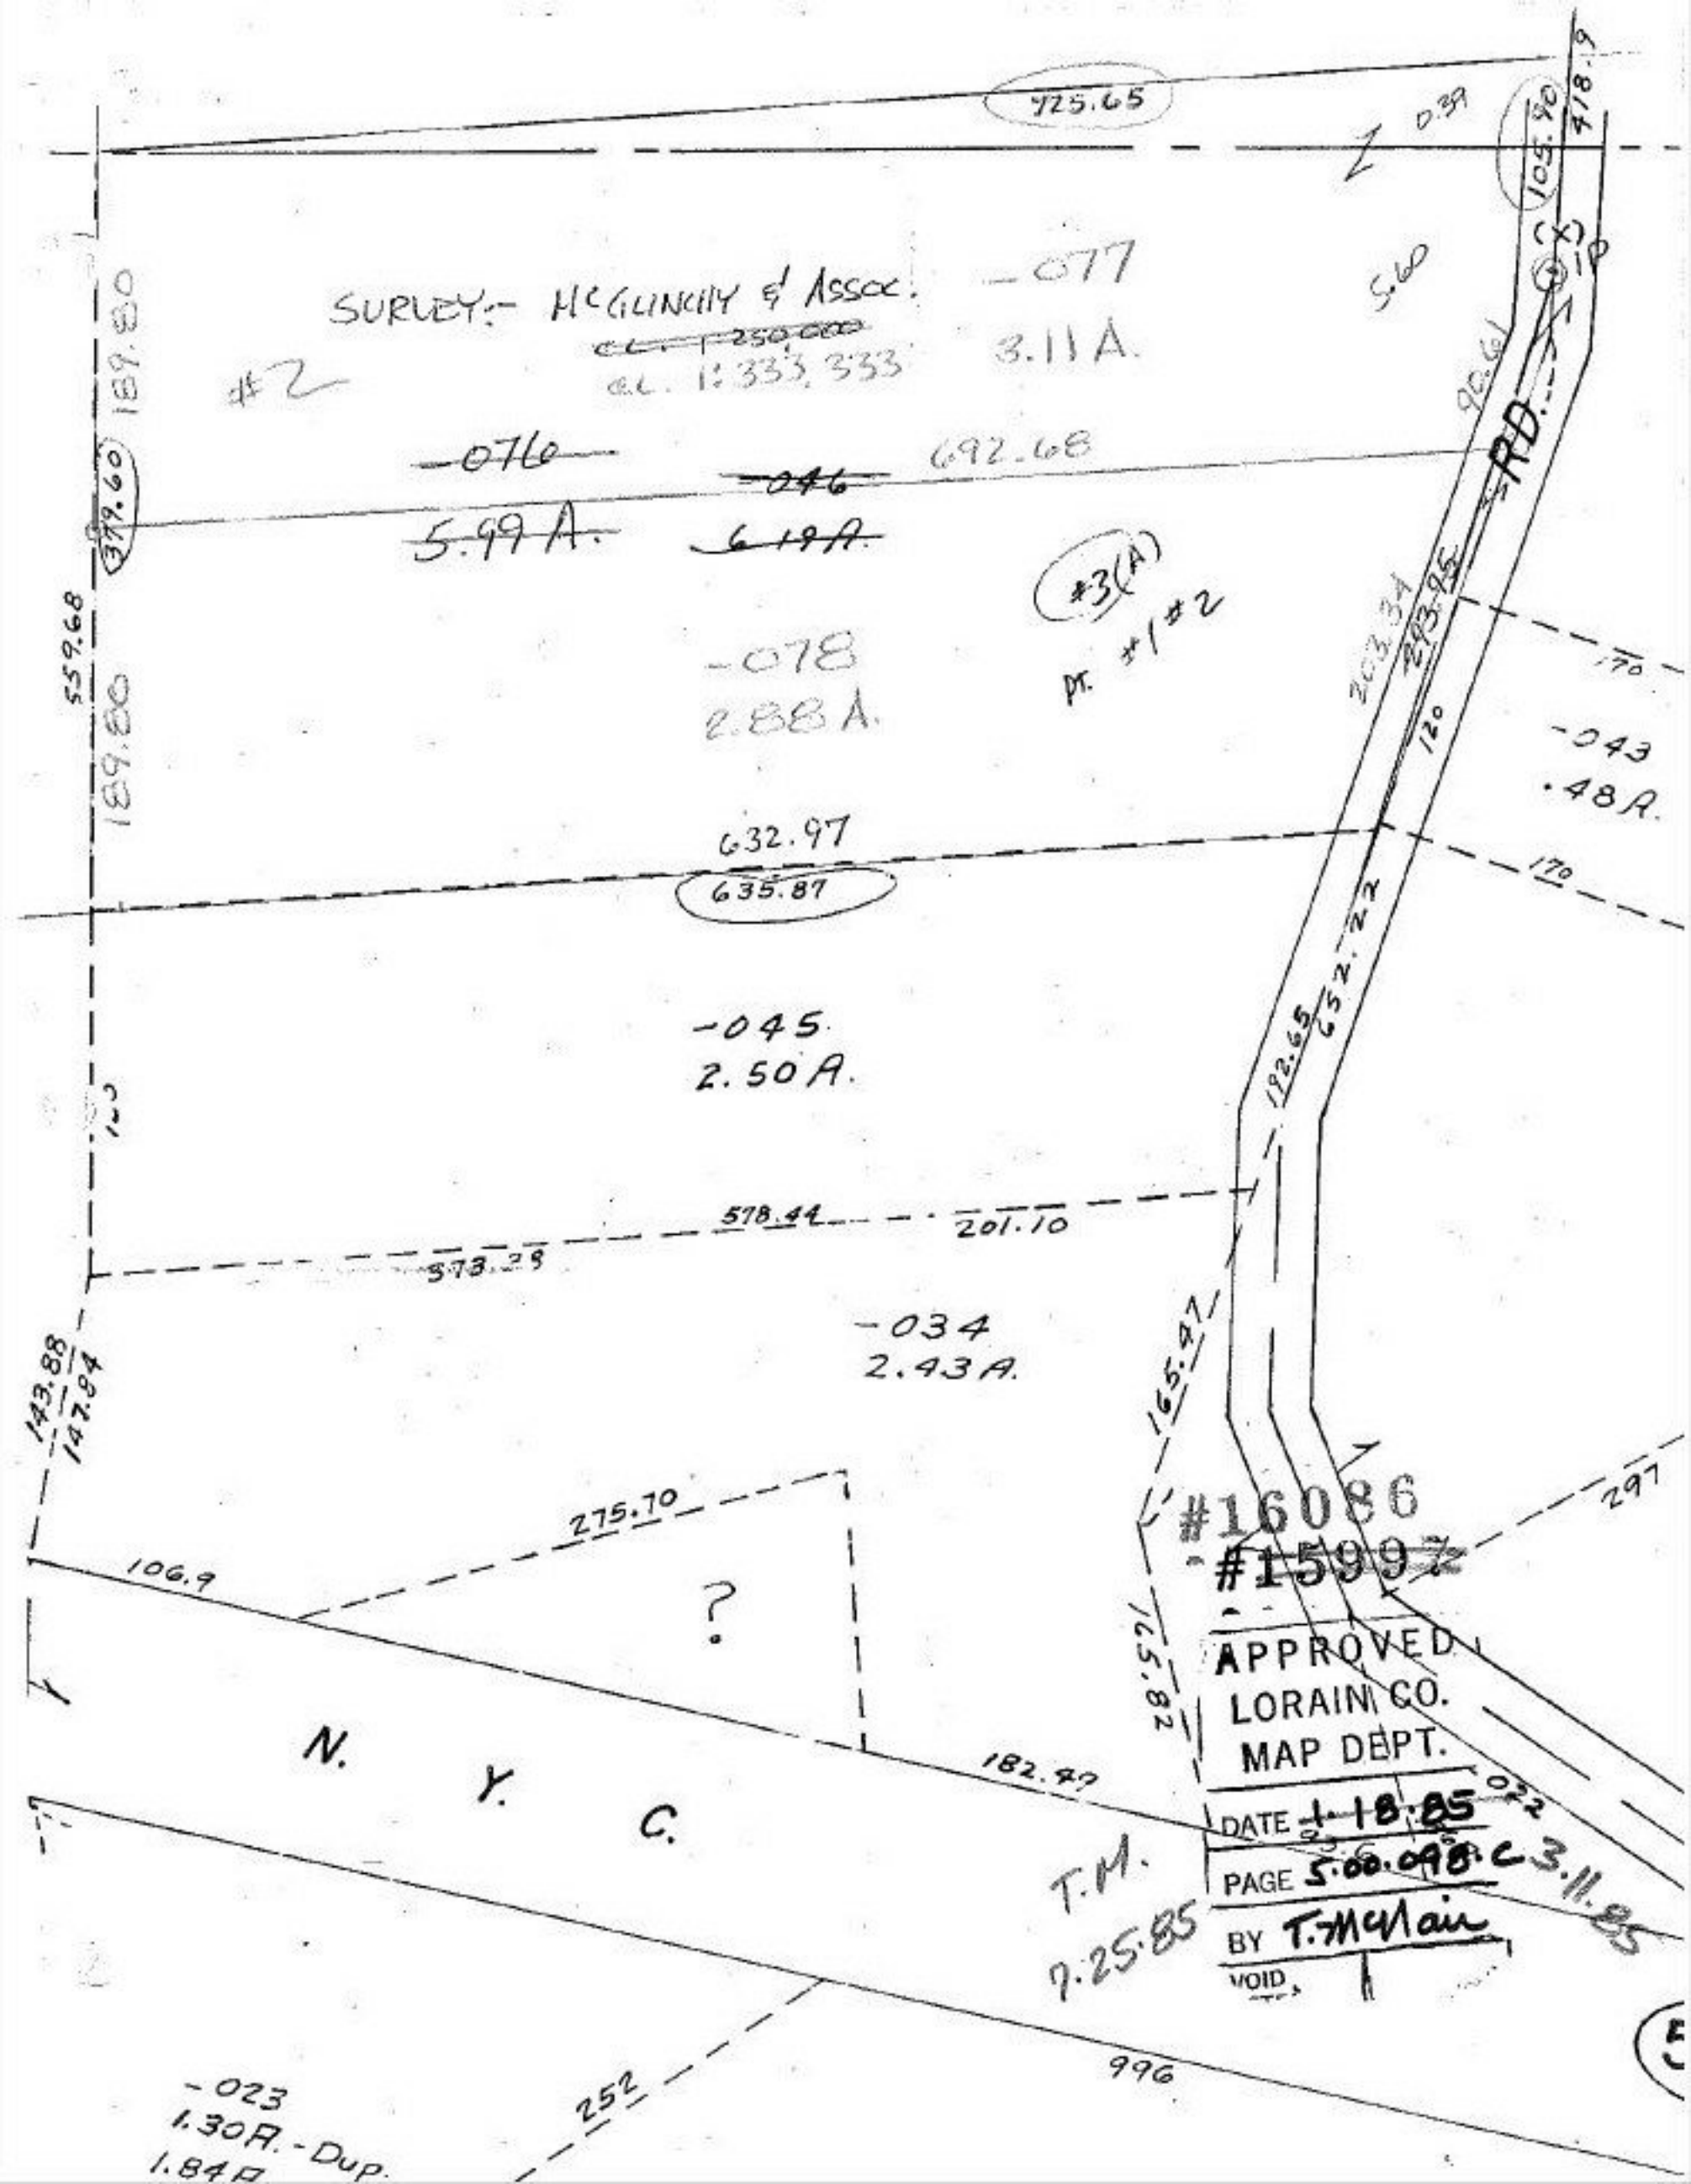

SURVEY:- McGLINCHY & ASSOC.
~~C.L. 1:250,000~~
C.L. 1:333,333
#2
-077
3.11 A.
-076
5.99 A.
-046
6.19 A.
692.68
#3(A)
Pt. #1 #2
-078
2.88 A.
632.97
635.87
-045
2.50 A.
578.44
201.10
-034
2.43 A.
275.70
106.9
?
N. Y. C.
182.47
996
-023
1.30 A. - Dup.
1.84 A.
252
-043
.48 A.
170
RD.
#16086
#15997
APPROVED
LORAIN CO.
MAP DEPT.
DATE 1.18.85
PAGE 5.00.098.C
BY T. McNair
VOID
T.M.
7.25.85
3.11.85