4.00-015-B

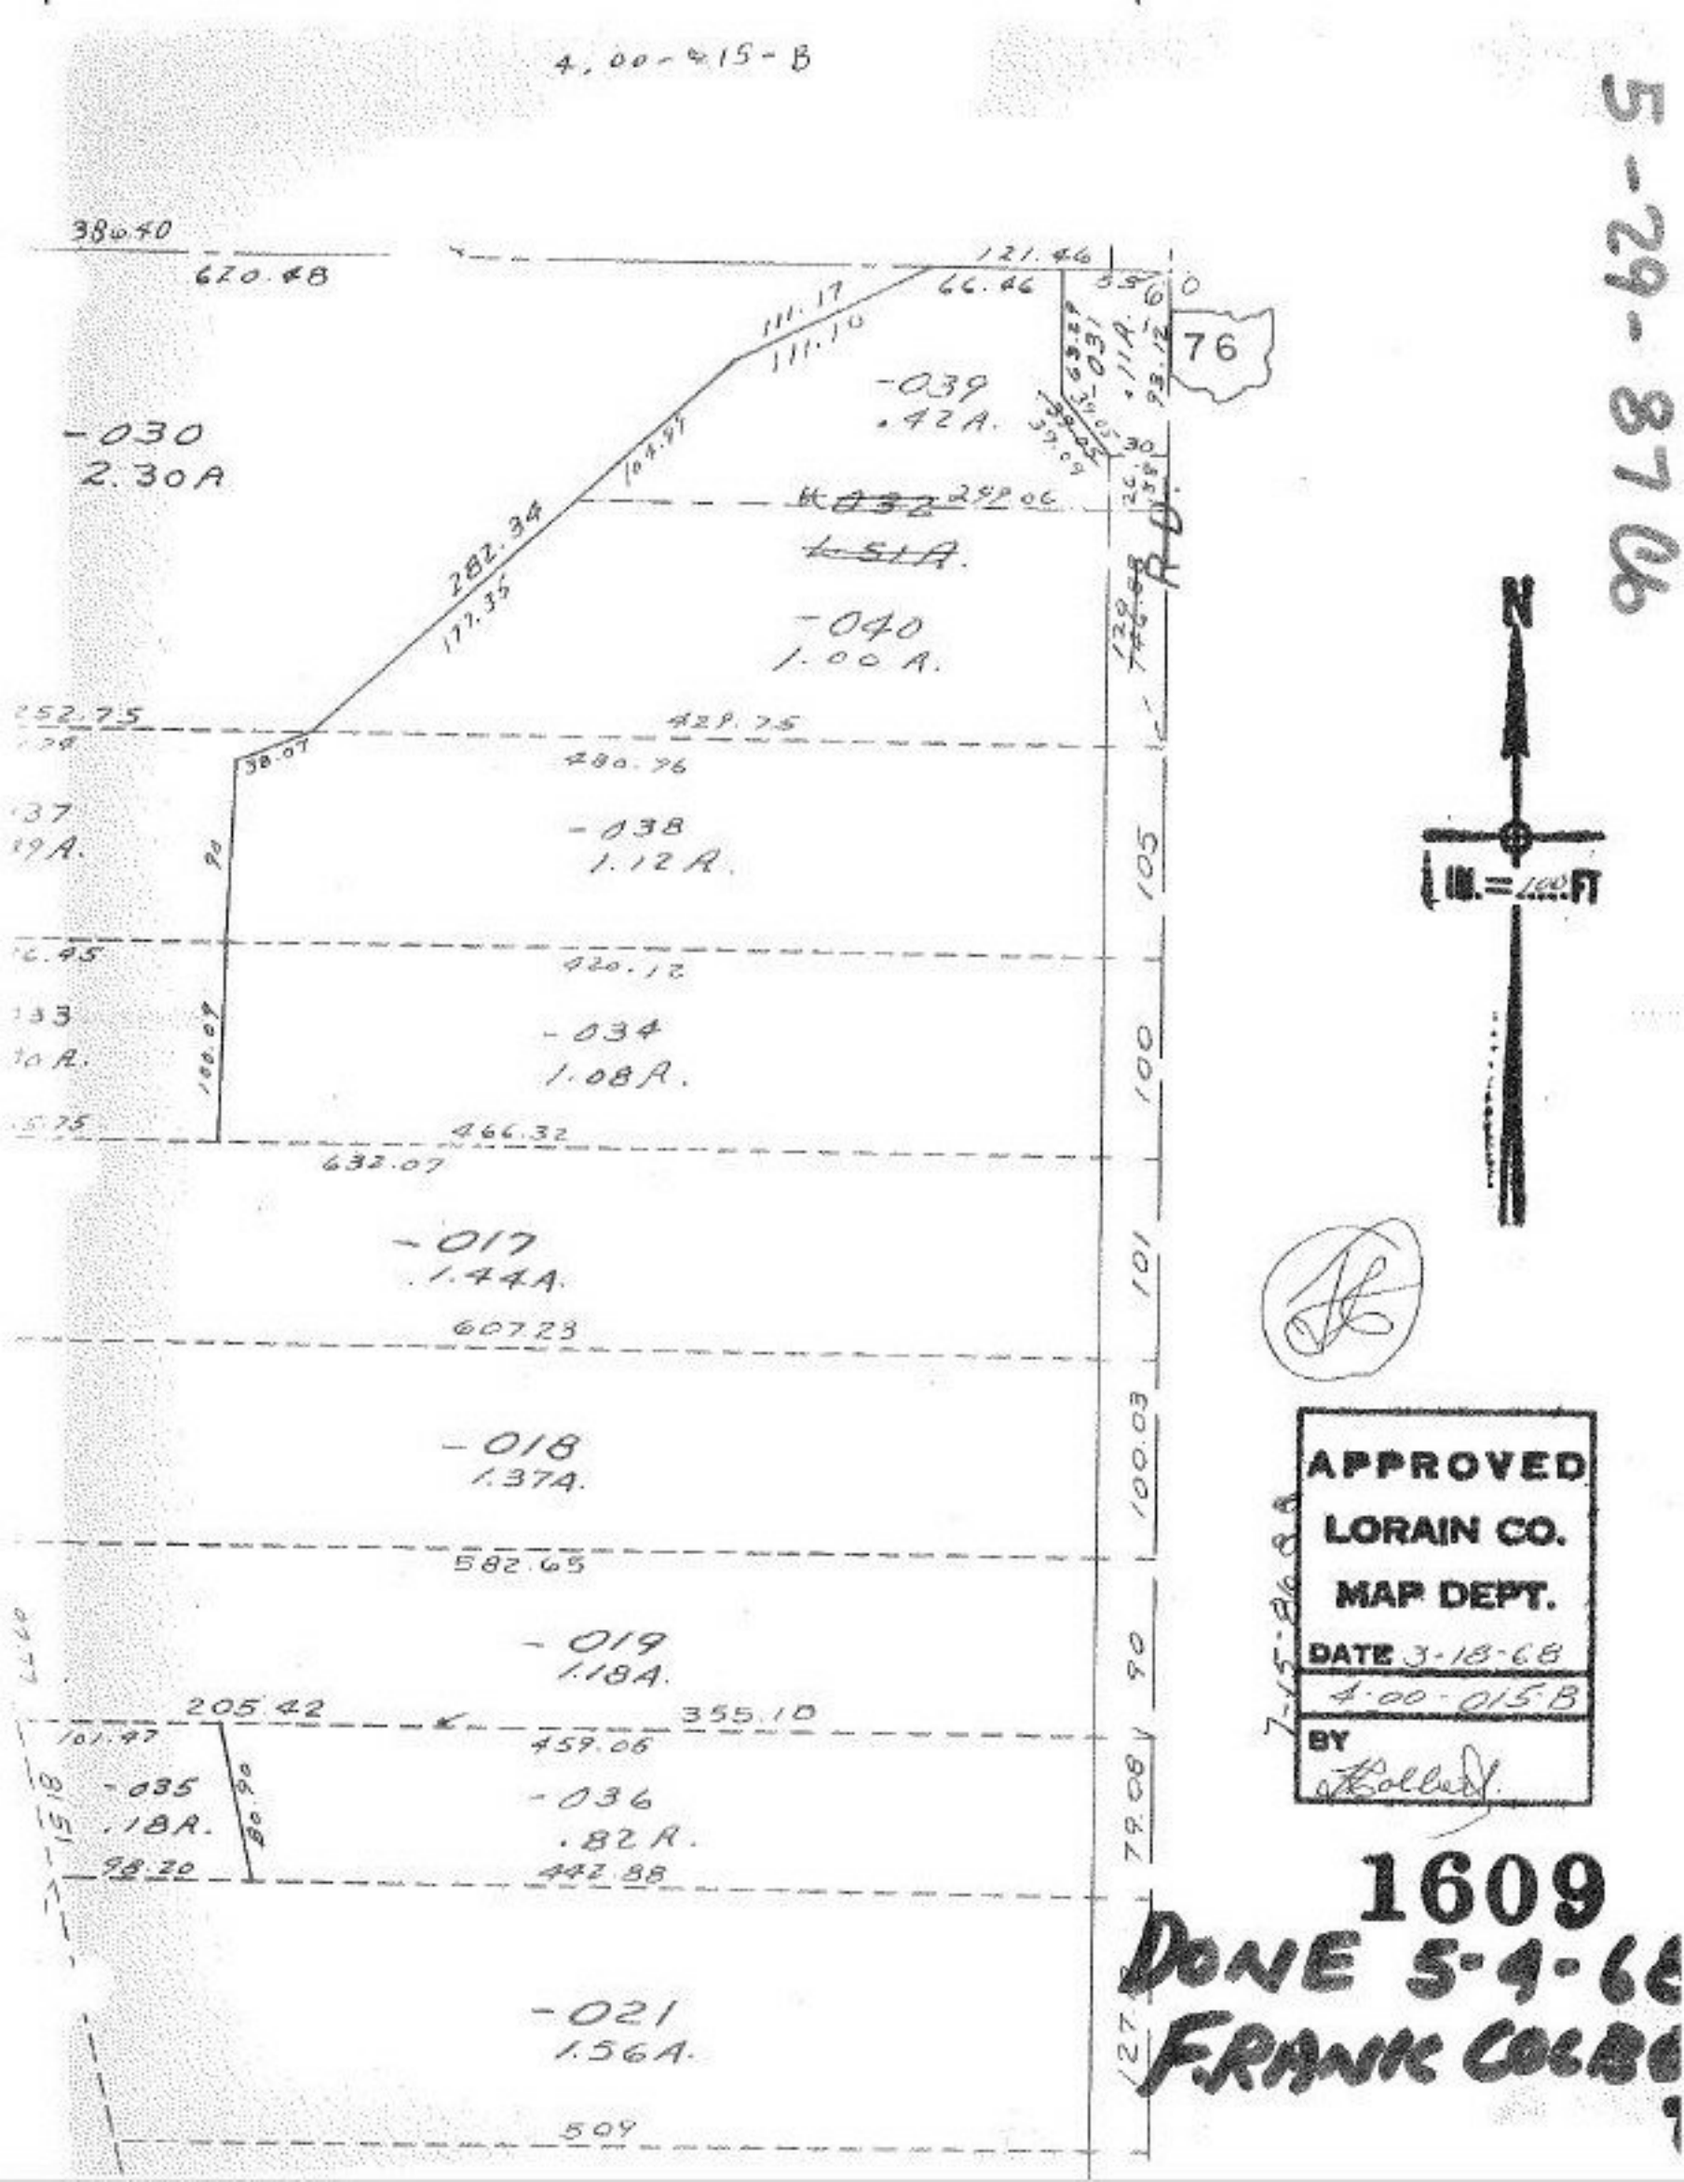

1609
DONE 5-4-68
FRANK COLBY