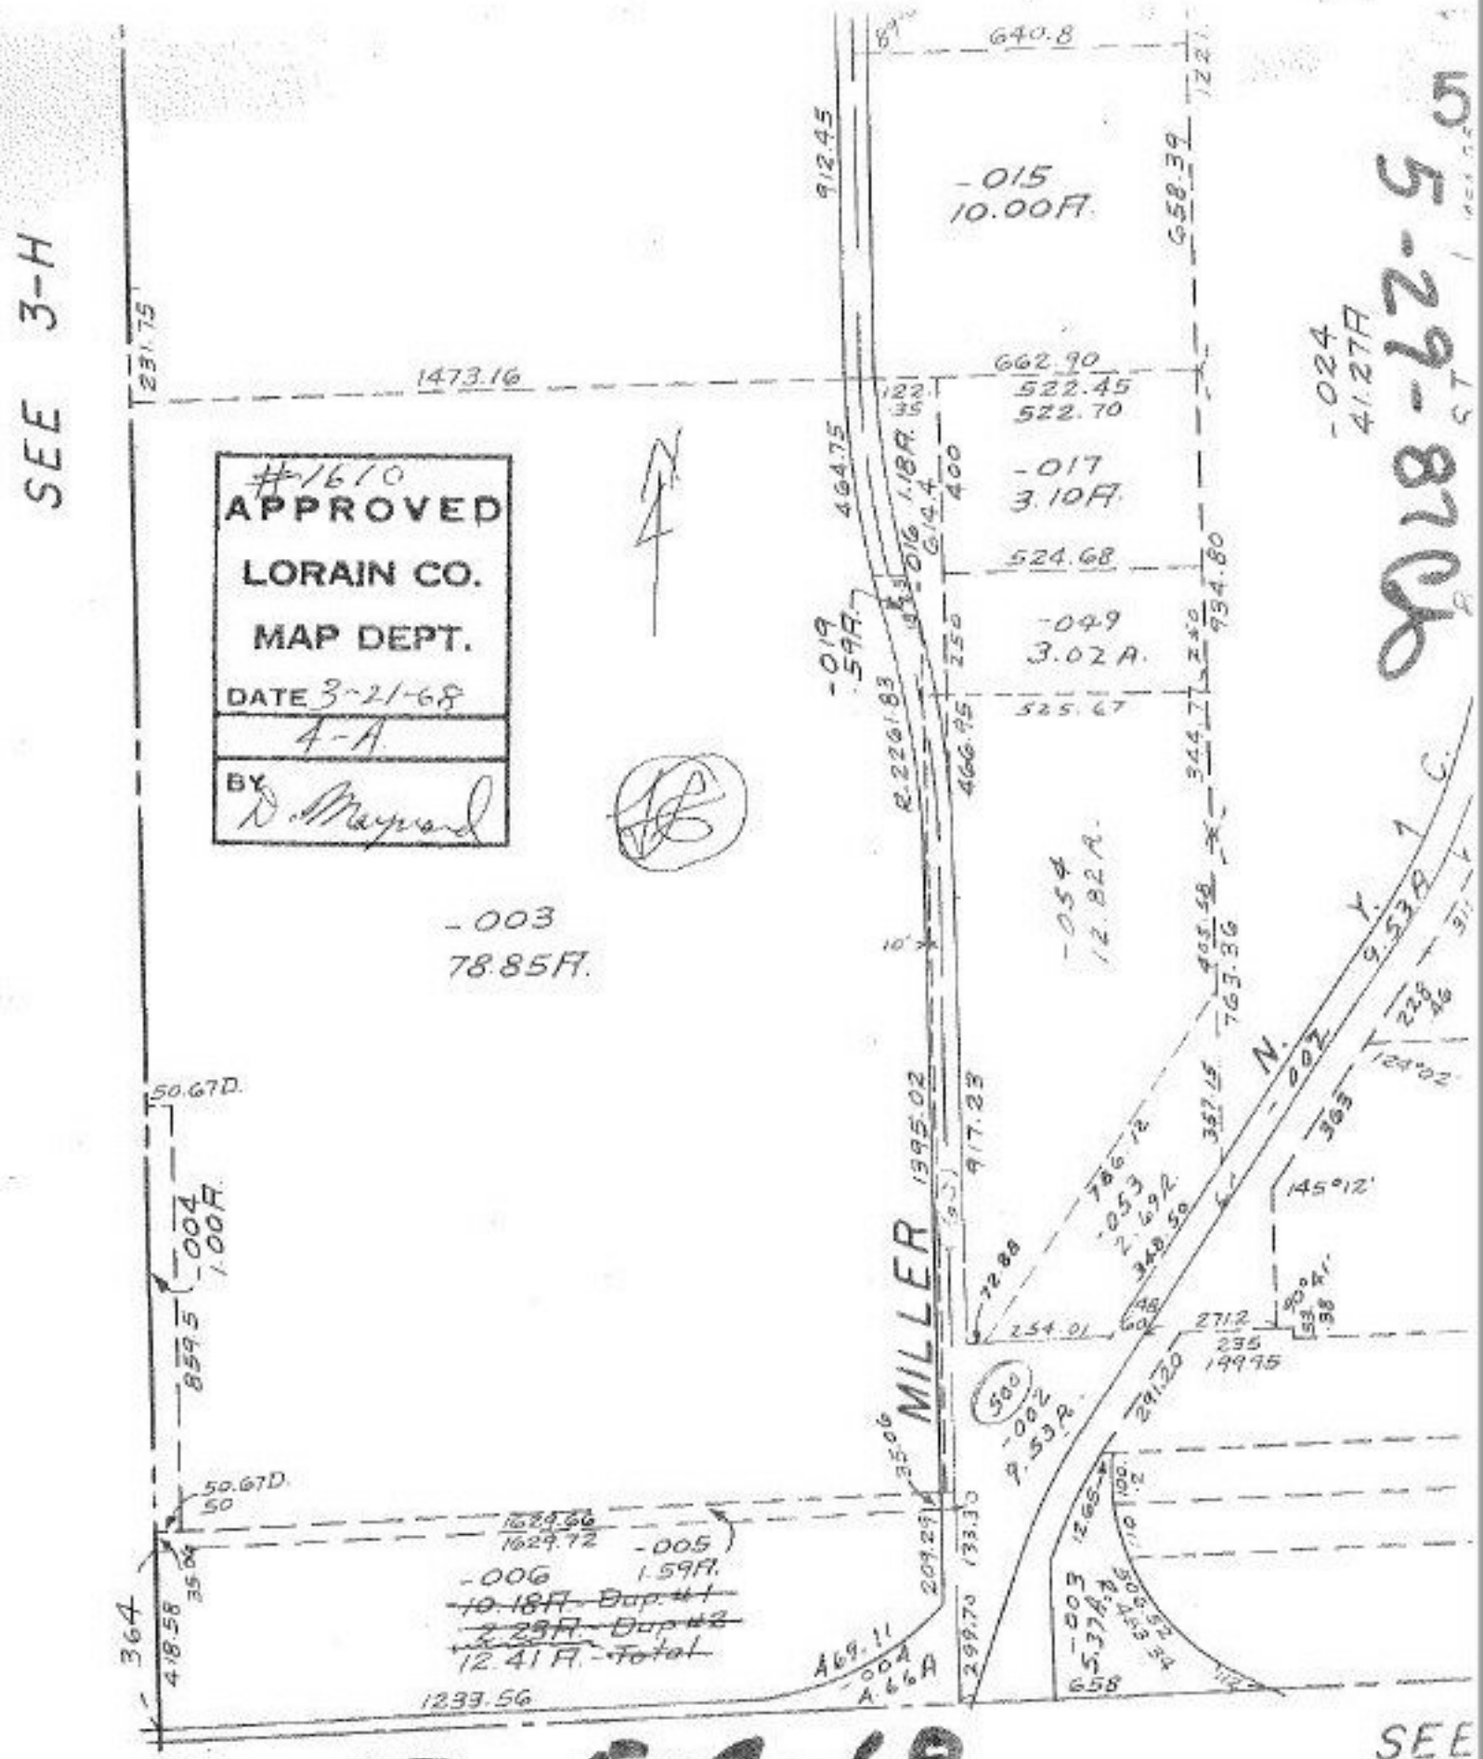

DONE 5-4-68
FRANK COLBERT.

AVON LAKE VILLA

SCALE: 1" = 400'